
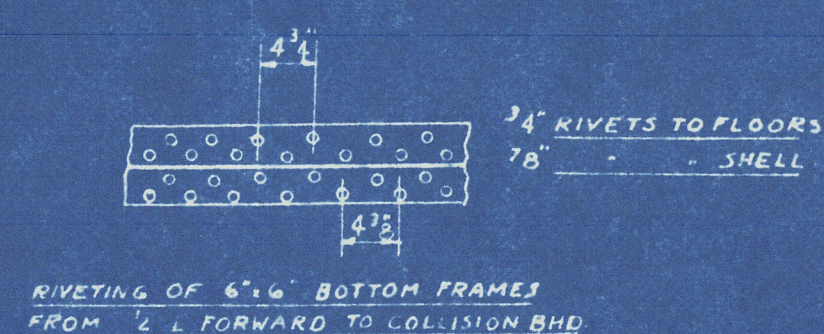


LENGTH B.P.	4'6"-0"
BREADTH EXTR	57'-1"
BREADTH MLD.	56'-10 1/2"
DEPTH MLD. UPPER DK	37'-4"
DEPTH MLD. SECOND DK.	28'-7"
DEPTHS TO LENGTH-UPPER DK.	11.14

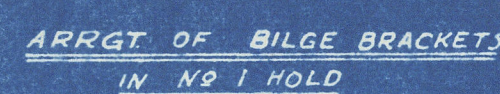

<u>EQUIPMENT NUMERAL</u>		
L(B-D)		39189
MIDSHIP	DECKHOUSE 30.25, 75, .50	113
CASINGS	20.5, 75, .50	77
CASINGS	39.75, 75, .50	314
AFTER DECKHOUSE	28, 75, .50	105
		<u>39,798</u>

2	-	BOWER ANCHORS	68 CWT.
1	-	STUD CABLE CHAIN	- 225 FATHOMS 2 5/16
1	-	STREAM ANCHOR (STOCKLESS)	- 23 3/4 CWTs.
1	-	STREAM WIRE	90 FATHOMS 5" - 6 x 12 FSW
1	-	TOWLINE	120 " 4 3/8 - 6 x 24 JPEC
2	-	HAWSERS	90 " 2 3/8 - 6 x 12 F
2	-	WARPS	90 " 2 3/8 - 6 x 12 "

## MIDSHIP SECTION

DRAWN BY	R	$\frac{1}{2}$ " SCALE
APPROVED BY		= 1 FT
DATE		1429

AS FITTED

DETAIL OF W.T. FLOORS  
AT C.V. KEEL



Fort Cadot River

Vol. 5921

+ Stephens +

008550-008558-0004



© 2021

Lloyd's Register  
Foundation