

2926


RUDDER & STERN FRAME

To LLOYDS CLASS 100 A.I.

SCALE : 1 FOOT




WROUGHT IRON.

RUDDER AREA	26' 6"
CG AFT OF PINTLES	1' 9"
SPEED	9 1/2 KNOTS
A x D	49.6 50.35
L x D	128.5
STEERING CHAIN	9 1/2" DIA
"	2005 5/8" DIA

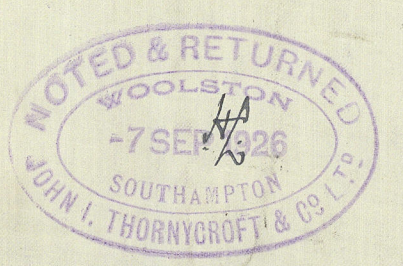


Increases in way of main vertical

RUDDER MAINPIECE

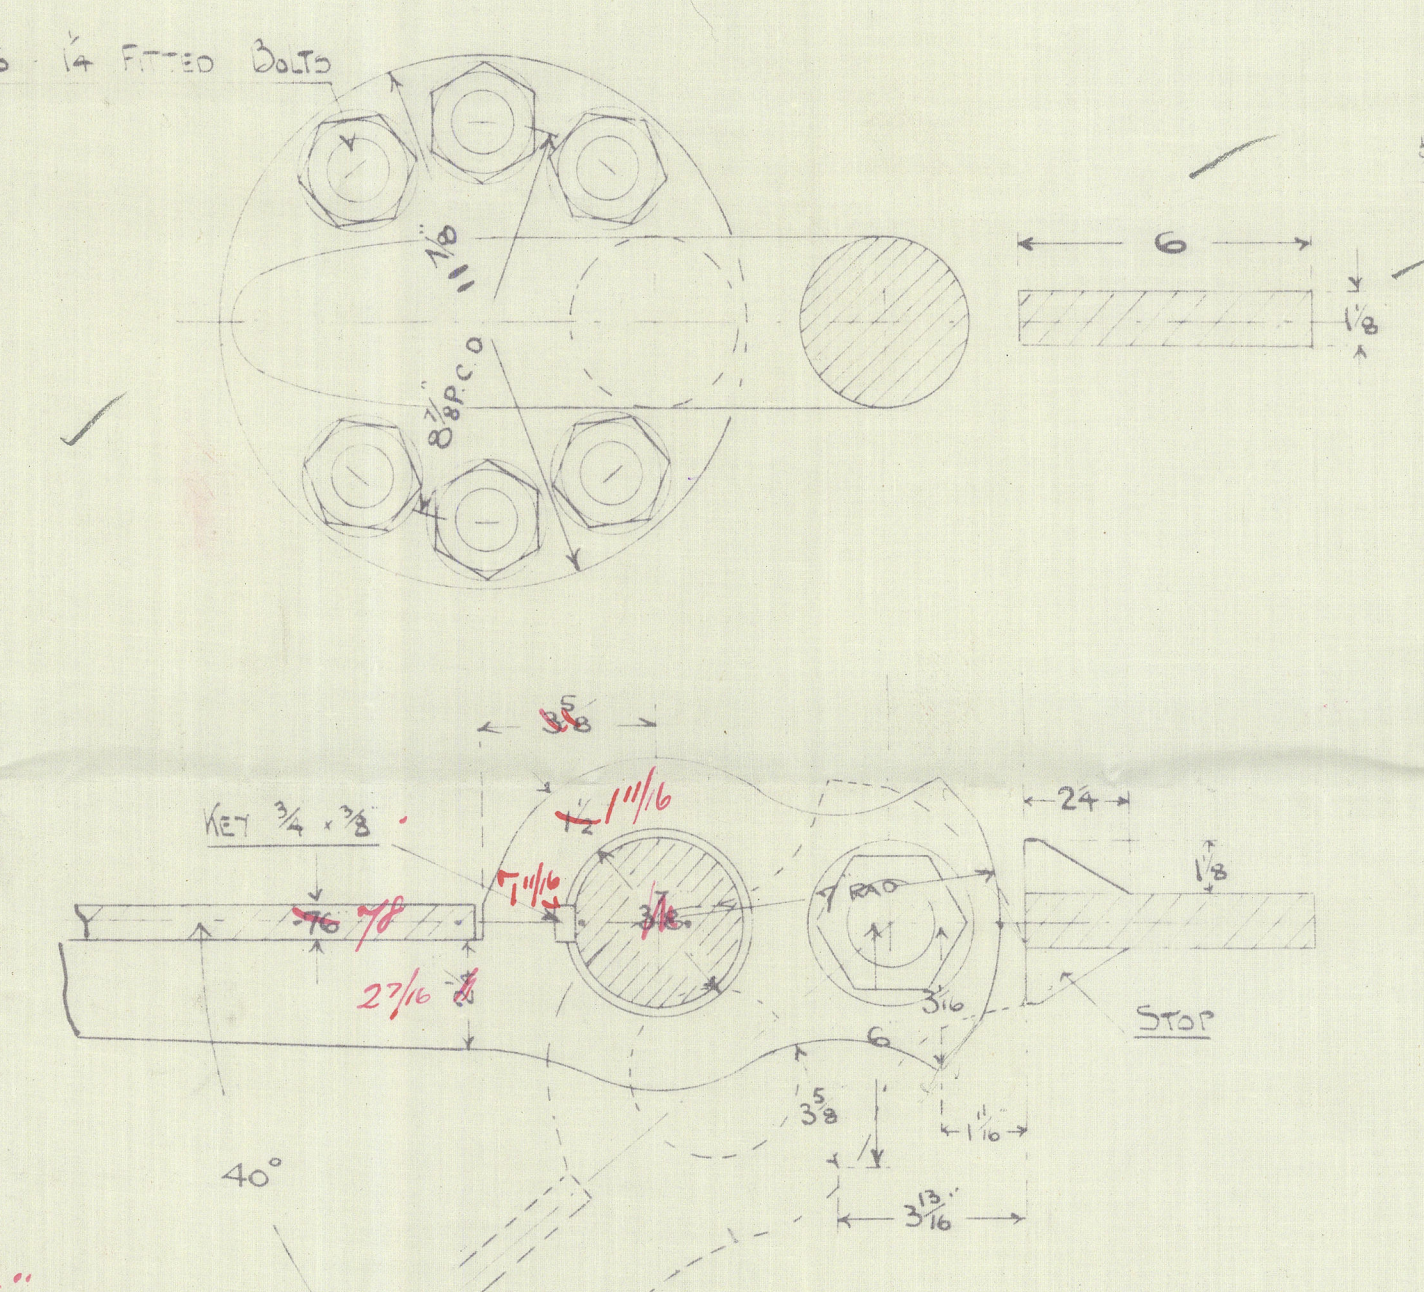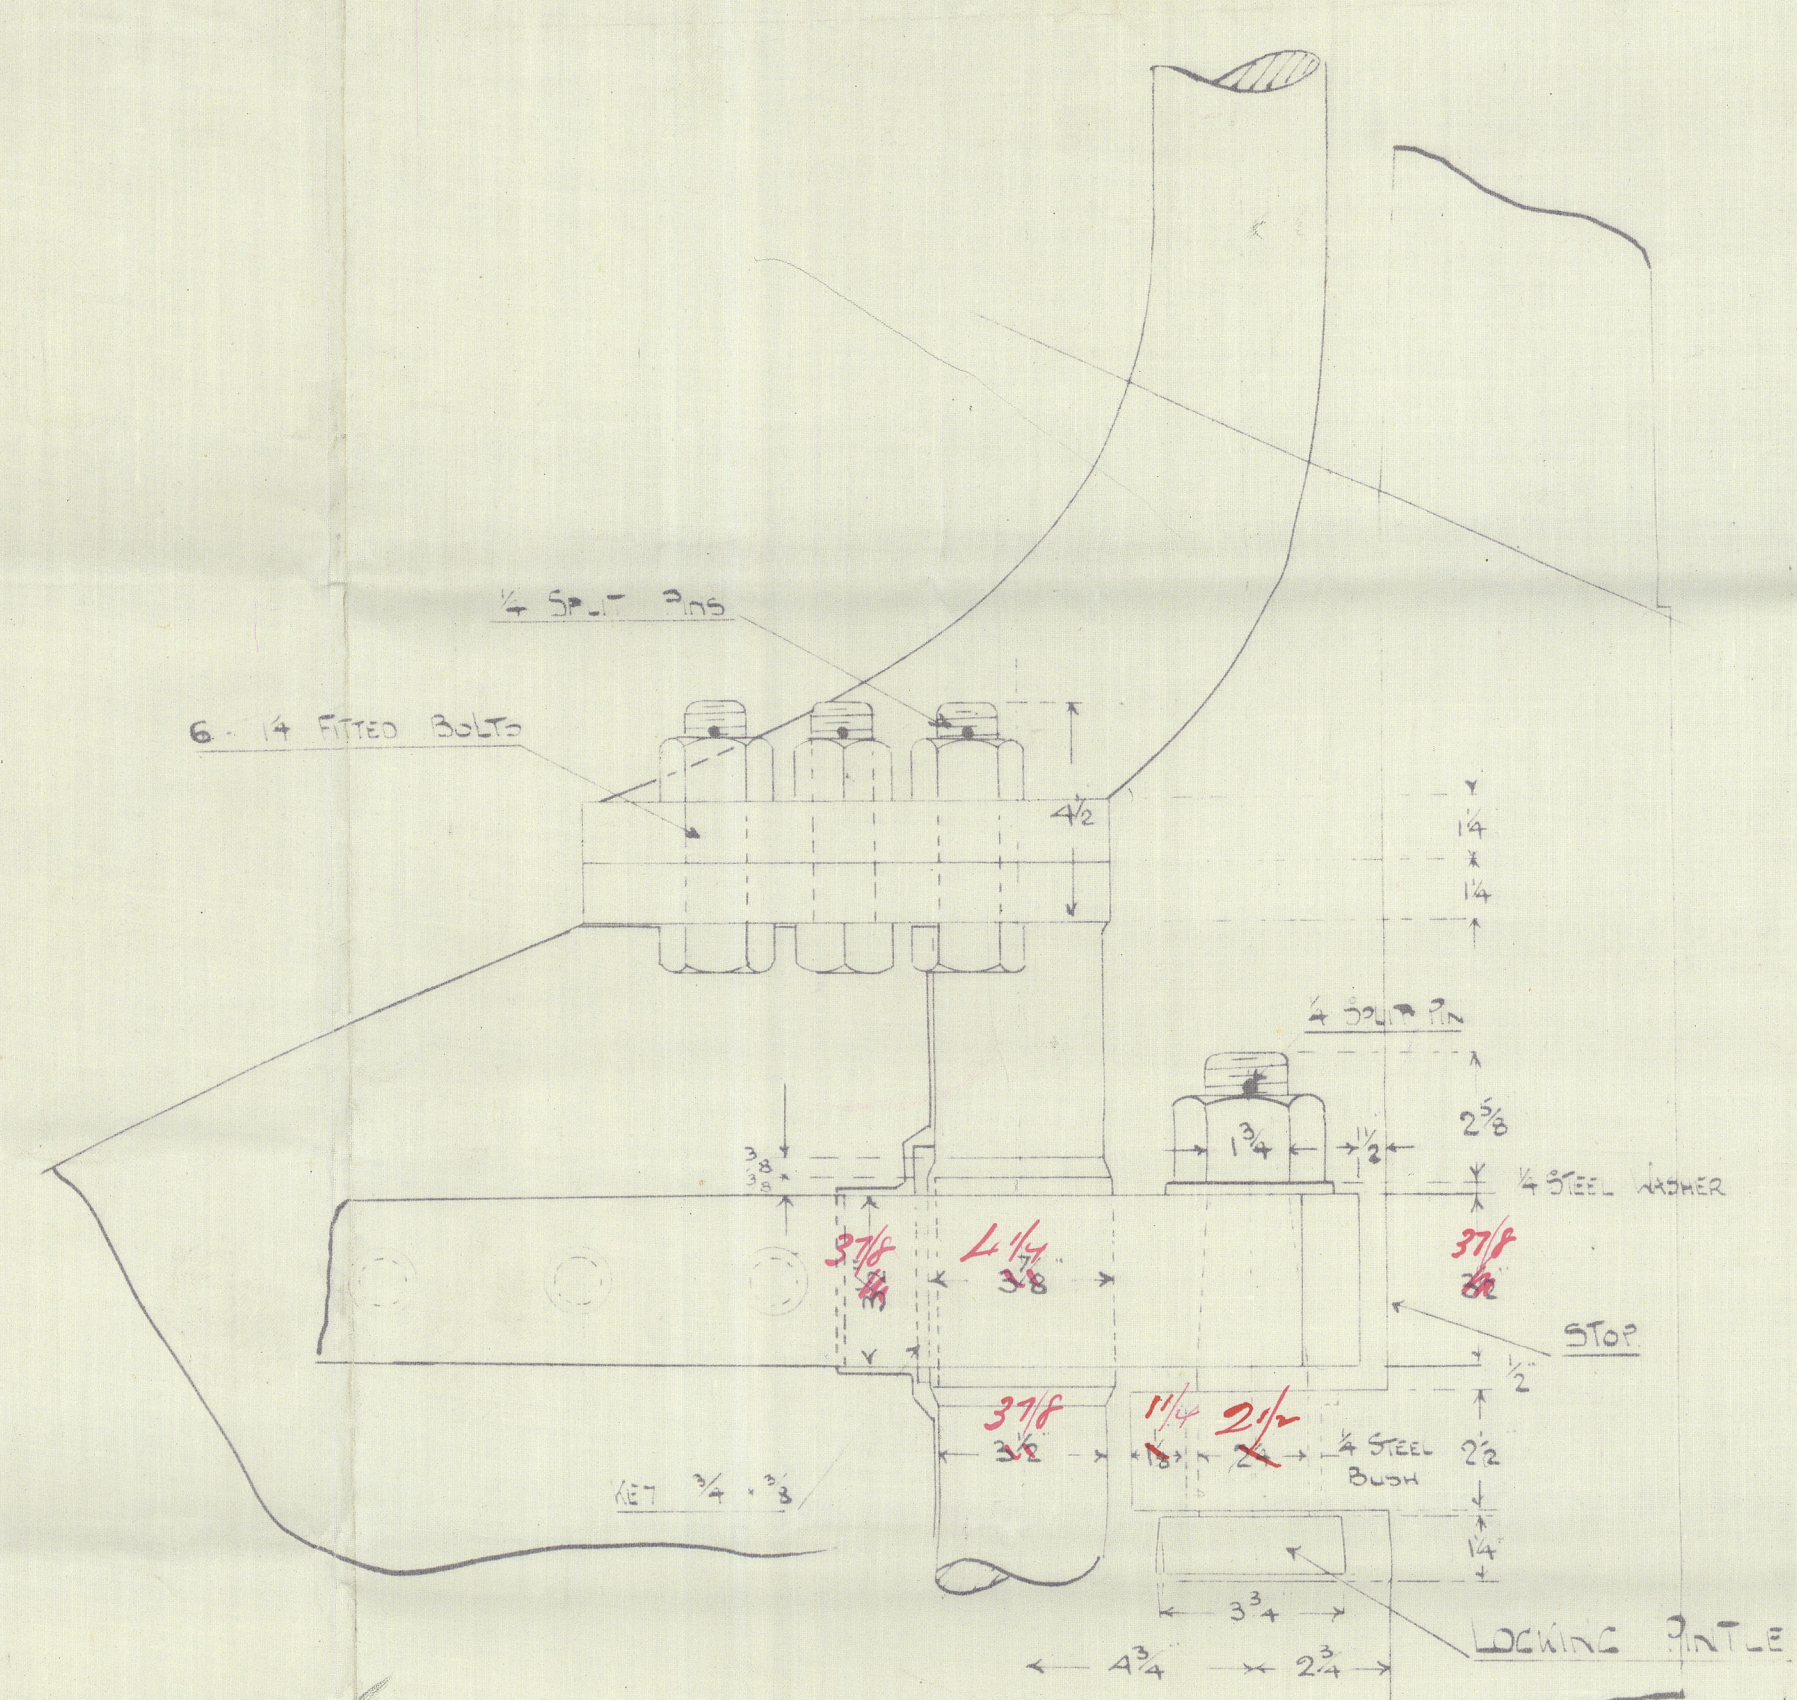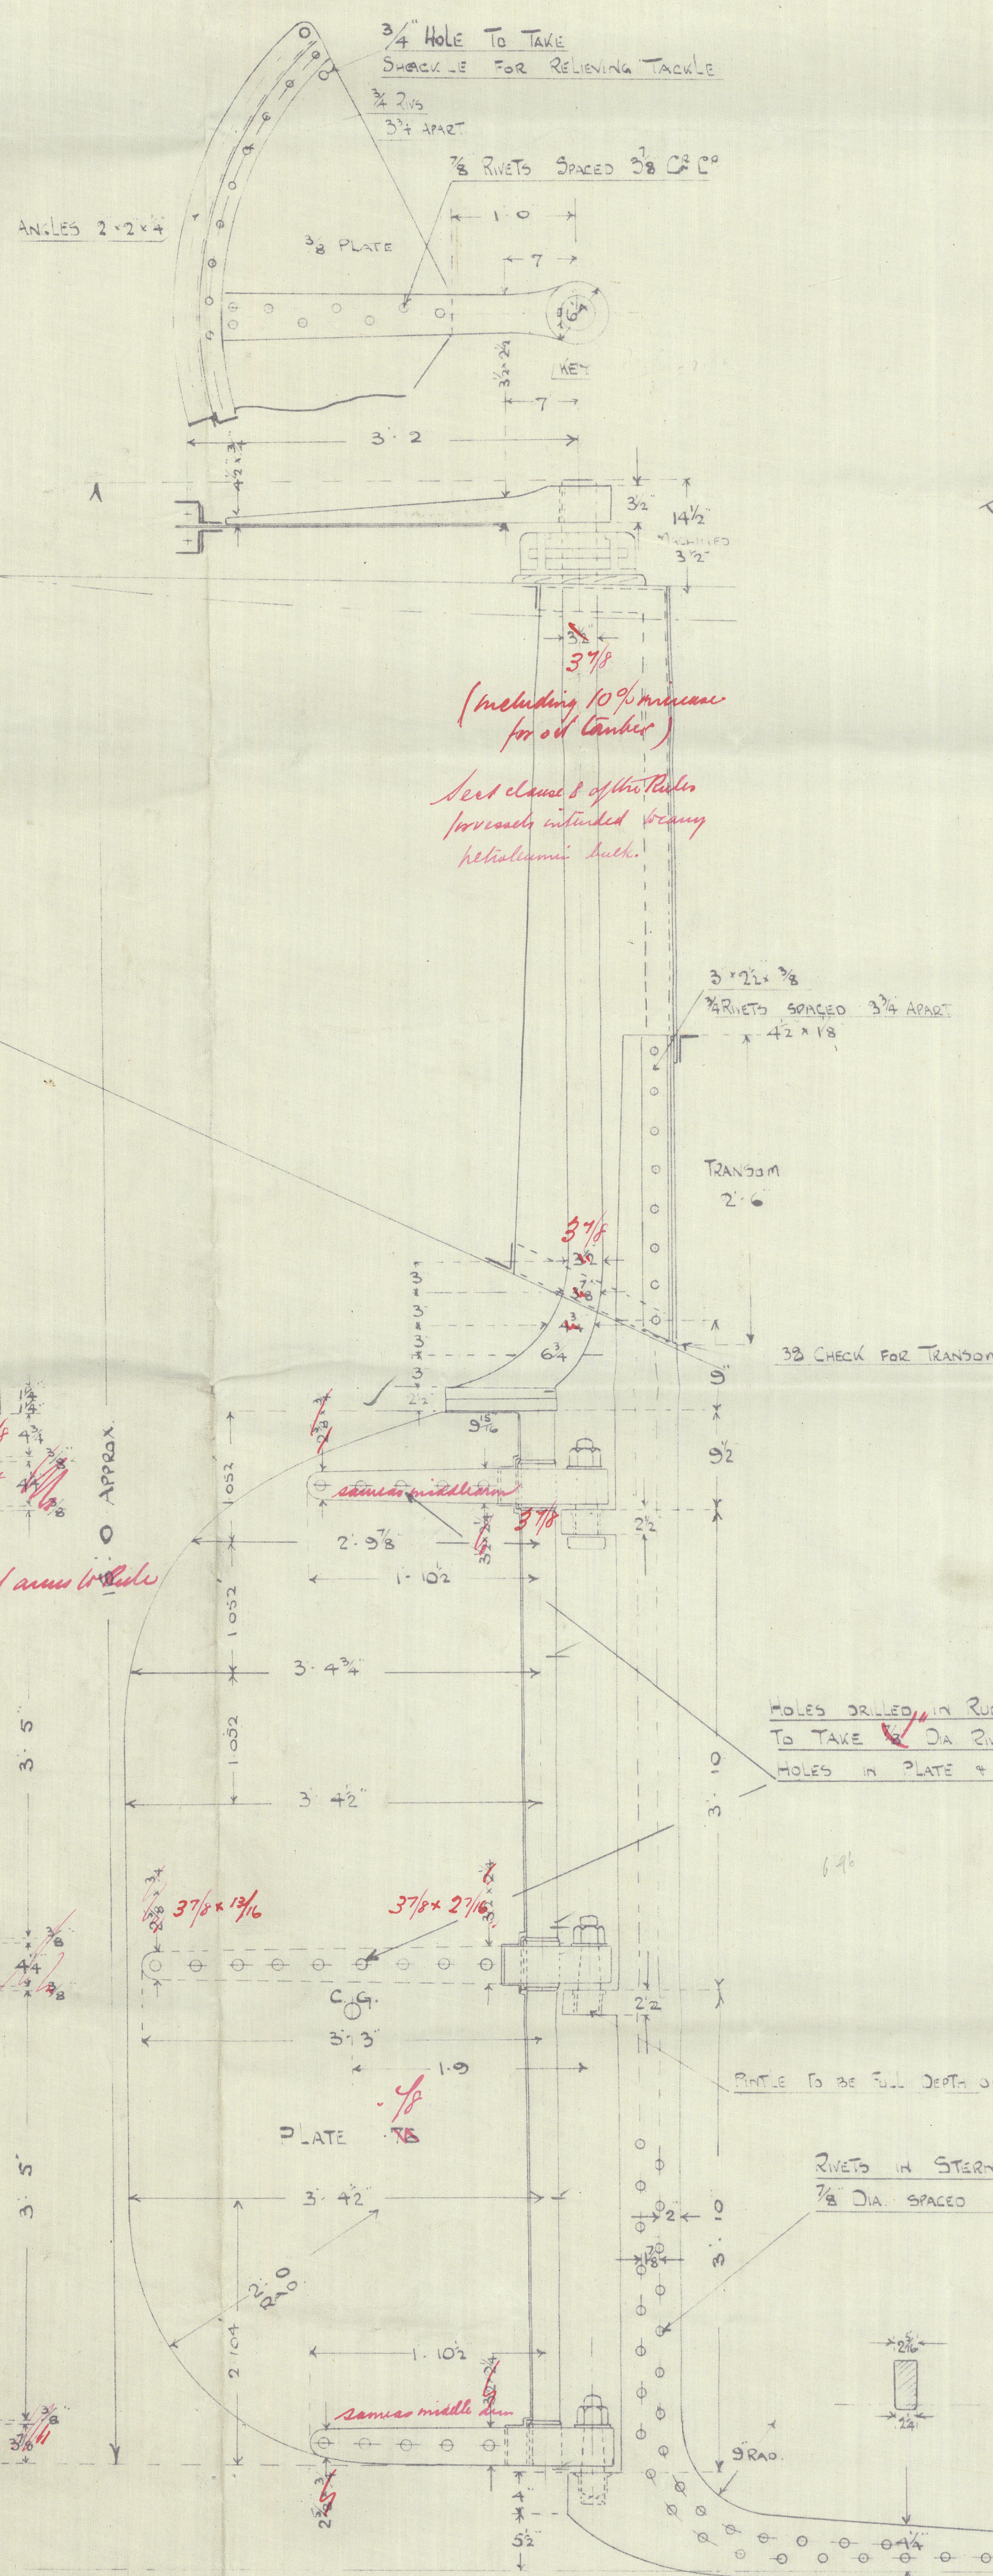


DETAIL OF COUPLING TOP PINTLE & GUDGEON

SCALE 3\"/>

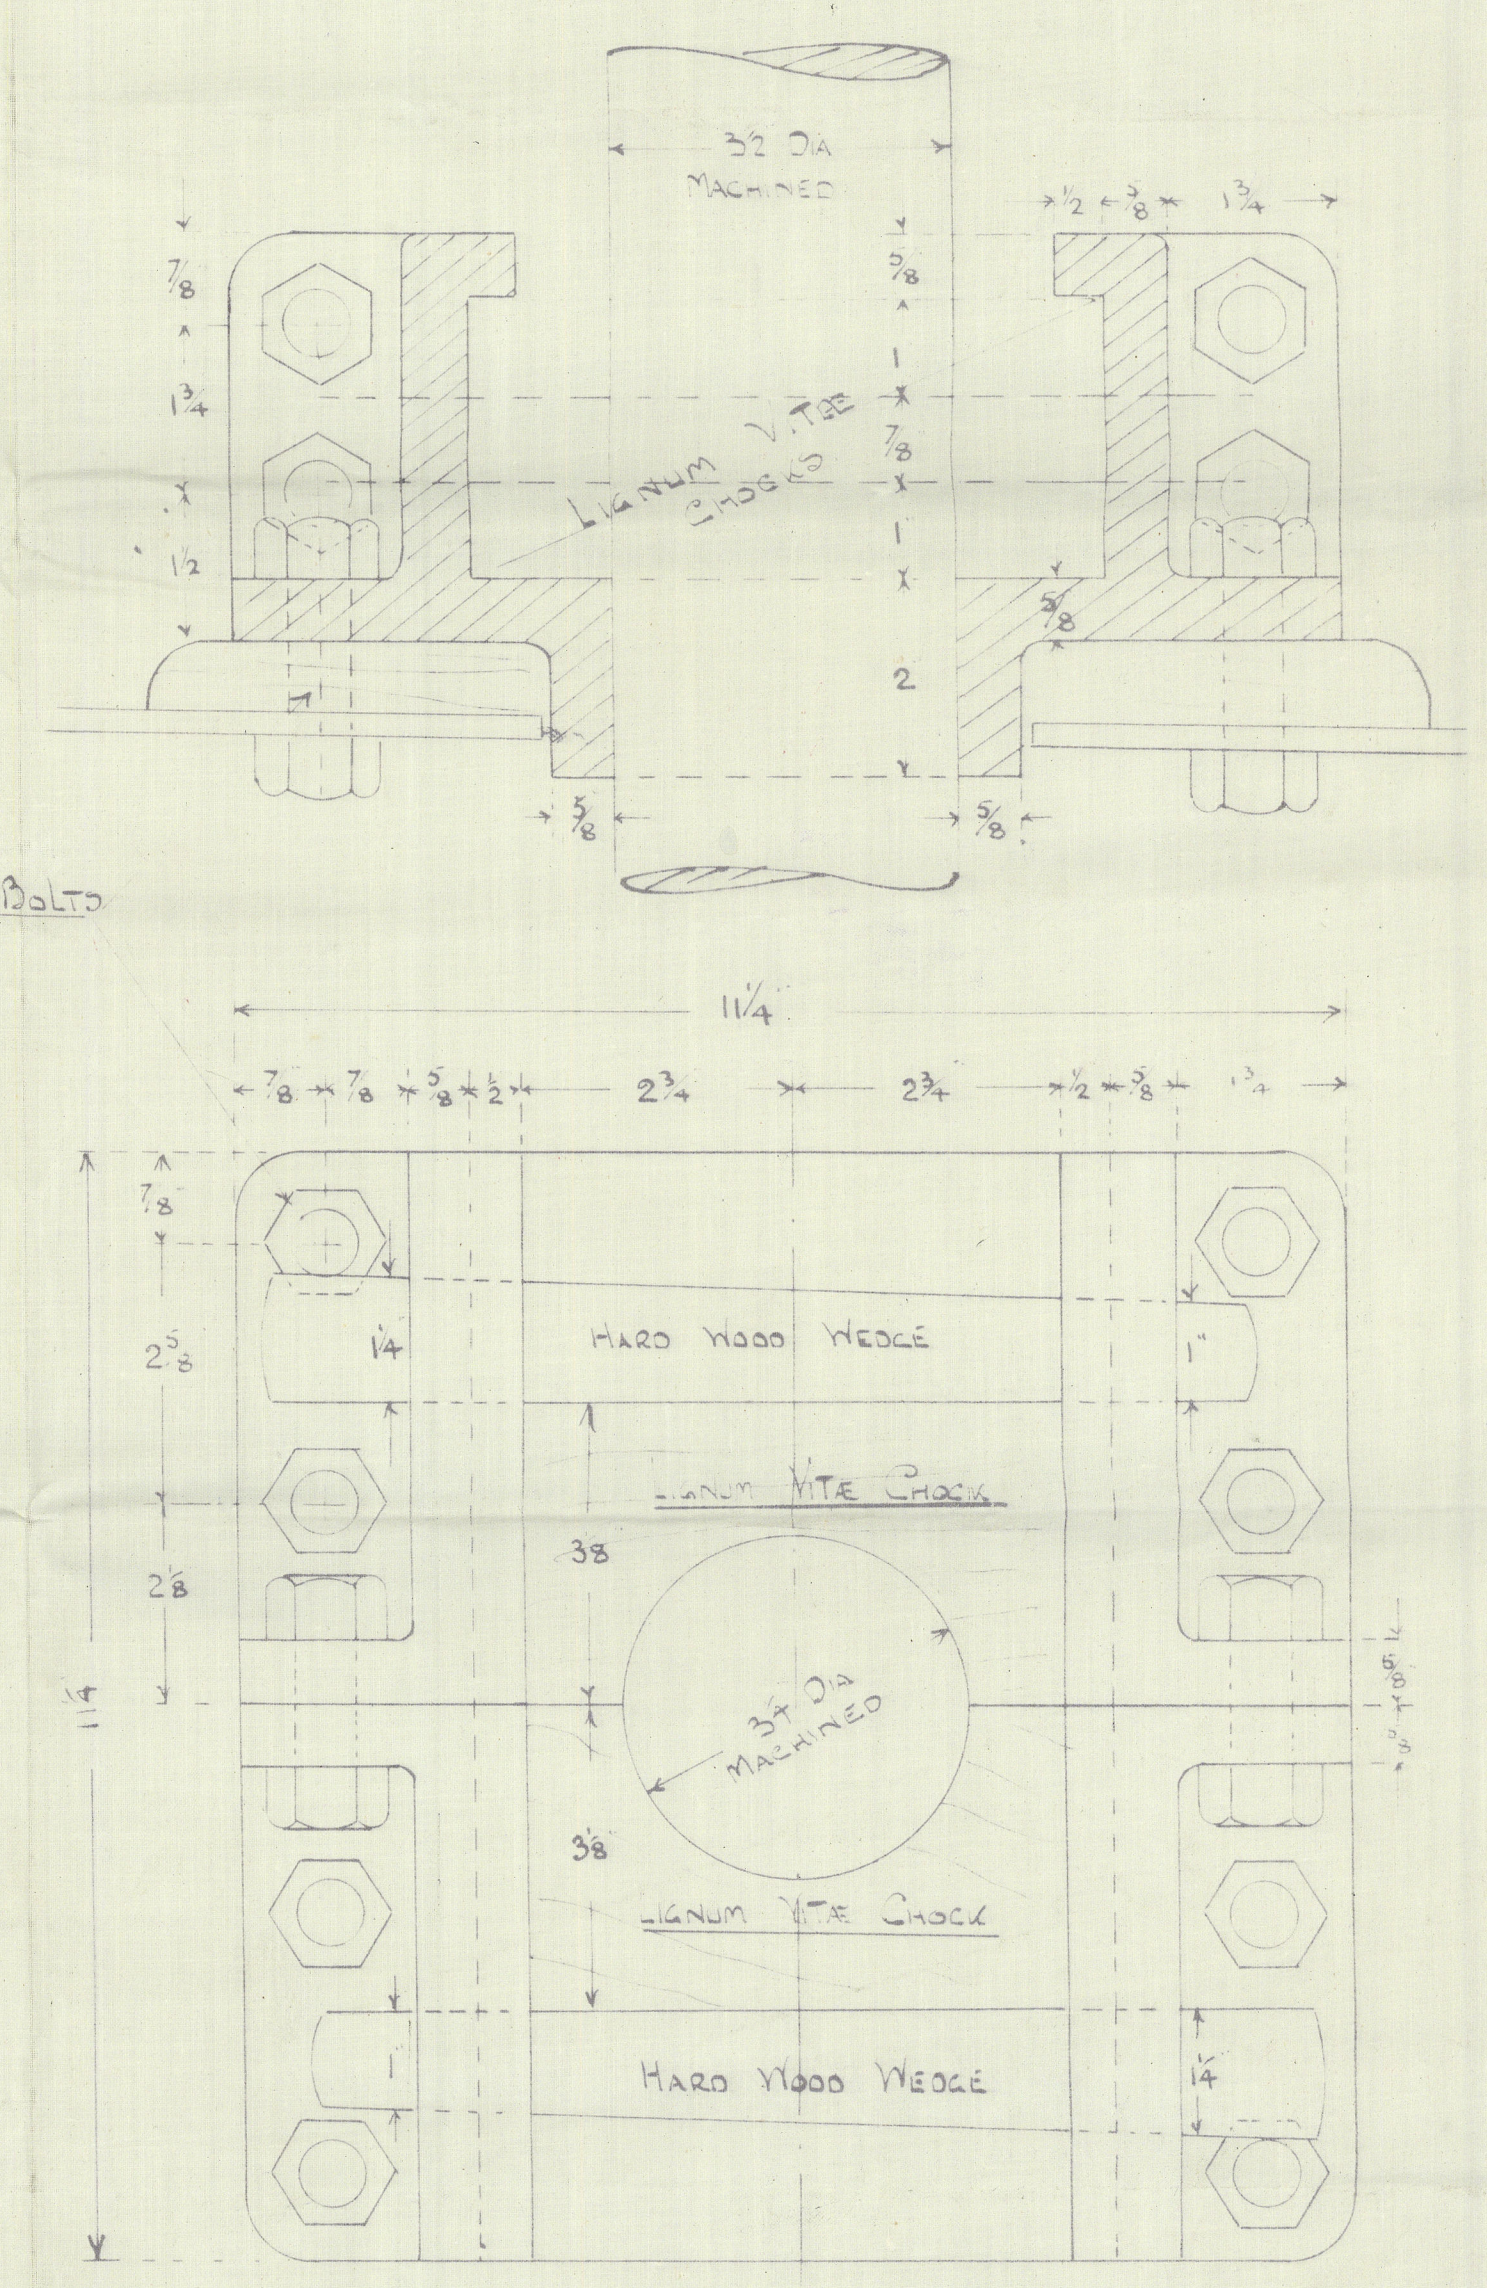

DECK SOCKET
OFF CAST IRON
SCALE 1/2 SIZE

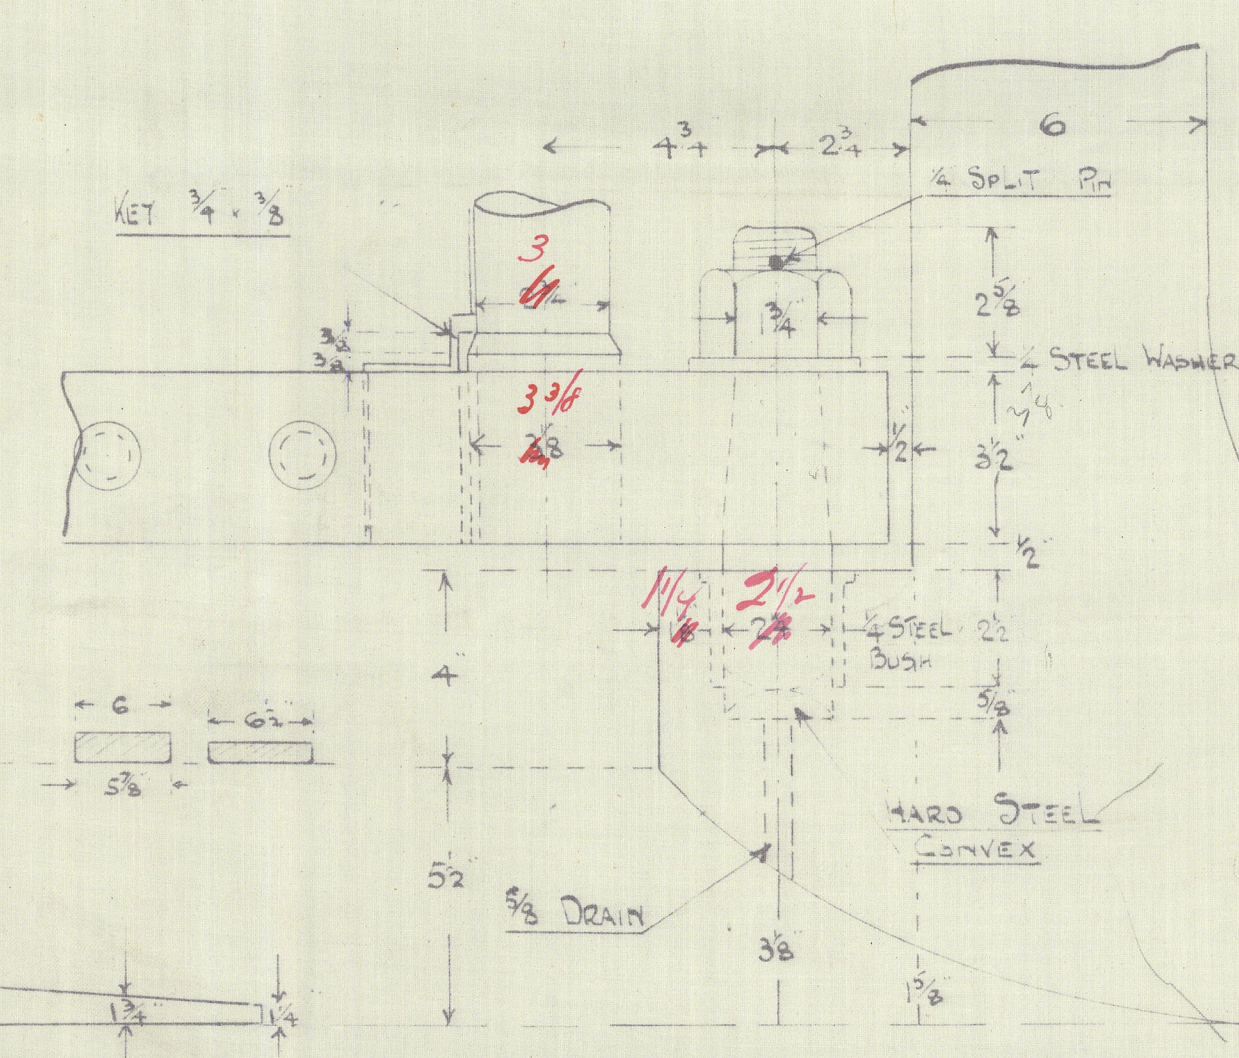

DETAIL OF BOTTOM PINTLE & GUDGEON

SCALE 3\"/>

No 1062

765/26

"EL BUARO."

Messrs. John I. Thornycroft & Co. Ltd.,

Southampton.

Yard N^o 1062.

RUDDER AND STERN FRAME.

Approved plan.



© 2021

Lloyd's Register
Foundation

008550-008558-0253