
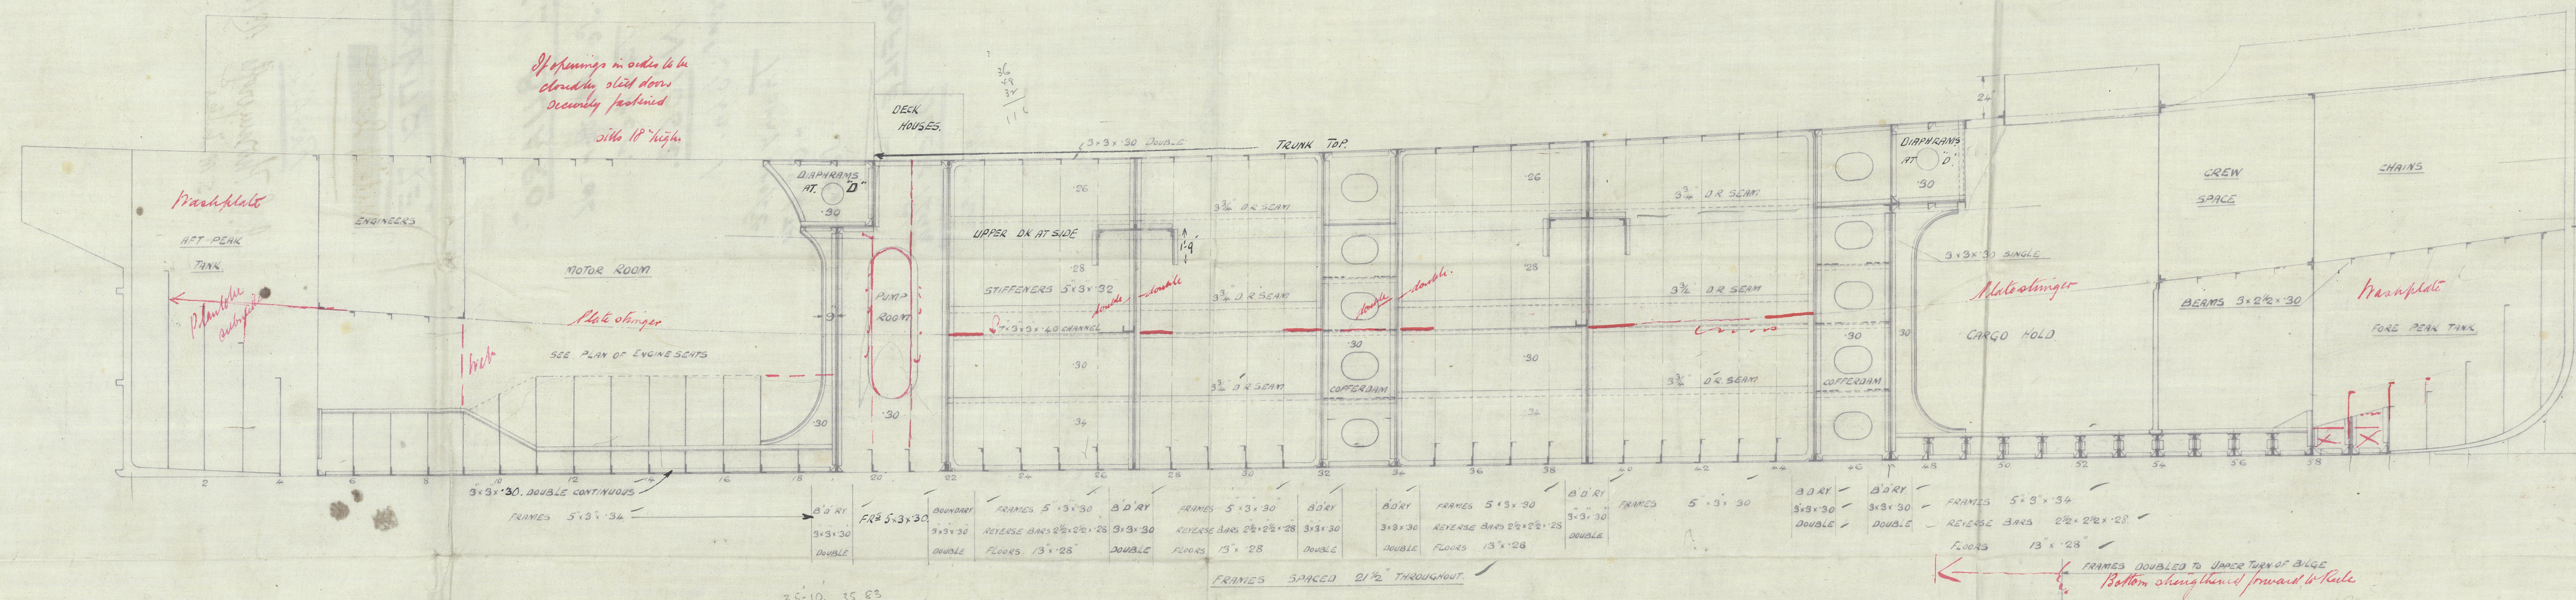


JOHN I. THORNYCROFT & CO. LTD.
SHIP DRAWING OFFICE
8-JUL-1926
J.B.W.
SOUTHAMPTON

15/7/26.
SCALE $\frac{1}{4}" = 1 \text{ FOOT}$

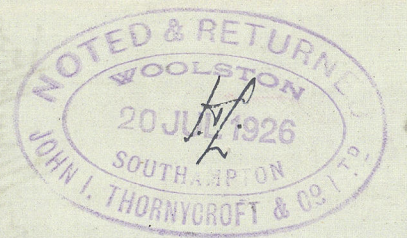

13. 7. 26.

1062

615/26

"EL BUARO."

~~11/2/26~~


Profile.

J. J. Thornycroft No. 1062
T. S. M. Jenkins

Stratthampton

9/2/26

92.25

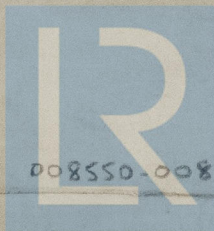

© 2021

Lloyd's Register
Foundation

008550-008558-0254

"EL BUARO"

Tw. Sc. Motor oil
Tanker.

Nº 1062.

Messrs John. I

Thornycroft
& Co Ltd.
Soton.

PROFILE &
DECK Plan.

Appr. Plan.