

LLOYDS STAMP
22-9-36

SHIP N^o 266, 267.

PROFILE & DECK PLANS.


SCALE 1/8" = 1 FOOT.

TO CLASS LLOYDS 100 A1 "CARRYING PETROLEUM IN BULK."

DIMENSIONS L.B.P. 365' 4 1/2" x MAXIMUM BREADTH MID 64' 0" x DEPTH MOULDED 18' 0"

NORMAL 62' 6"
"SHERWOOD COMBINATION SYSTEM"
ARCFORM (PATENT).

NOTE: MASTS, WINDLASS AND WINCHES TO BE SUPPORTED TO SURVEYORS SATISFACTION.

 

Messrs. J. W. H. & Co. Ltd.
Haverhill Hill, N. Yorks.
18/11/36


By Joseph W. H. & Co. Ltd.
4, LLOYDS AVENUE
LONDON, E.C.3.
DATE 18/11/36

FURNESS S.B. C^d N^{os} 266 + 267

(12) PROFILE + DECK PLANS
2nd COPY

S.S. Bachagueno
MDB. RPT. No. 16030

S.S. M^lwoa
MDB. RPT. No. 16055

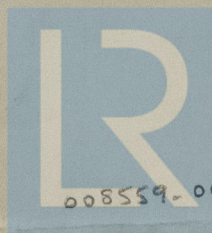

© 2020

Lloyd's Register
Foundation

008559-008568-0088

FURNESS S.B. C²³

N^{os} 266 + 267.

PROFILE + DECK PLANS 2nd COPY

(12)

"PETRO LAÇO"

MM. 8564



© 2020

Lloyd's Register
Foundation

008559-008568-0088