


24.3.08.

S.S.T. "Kirkland"

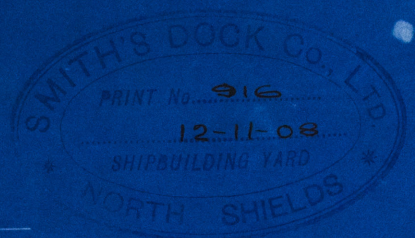

NUMERALS.  
 1/2 BEAM... 10.67.  
 DEPTH... 12.96.  
 1/2 GIRTH... 19.25.  
 1st. No... 42.88.  
 LENGTH... 118.87.  
 2nd No... 5097.94.

Nos 819, 301  
 — MIDSHIP SECTION —  
 — OF TWO —  
 — STEEL SCREW TRAWLER —  
 TO CLASS 100 ALL LOYDS.


DIMENSIONS 120'-0" BP x 21'-6" EXT. x 12'-6" MOULDED.

SCALE 1/2" = 1 FOOT.

EQUIPMENT.

1 ANCHOR	5 1/4 CWTs	EX STOCK OR STOCKLESS
1 "	4 3/4 "	" " " "
1 "	2 1/2 "	" " " "
90 FATHOMS	1" STUD LINK CHAIN	
60 "	6" HAWSER OR 2 1/2" STEEL WIRE	
60 "	4 1/2" WARP	1 3/4 " "

12/11/08  
 20/3/08  
 12/11/08  
 20/3/08

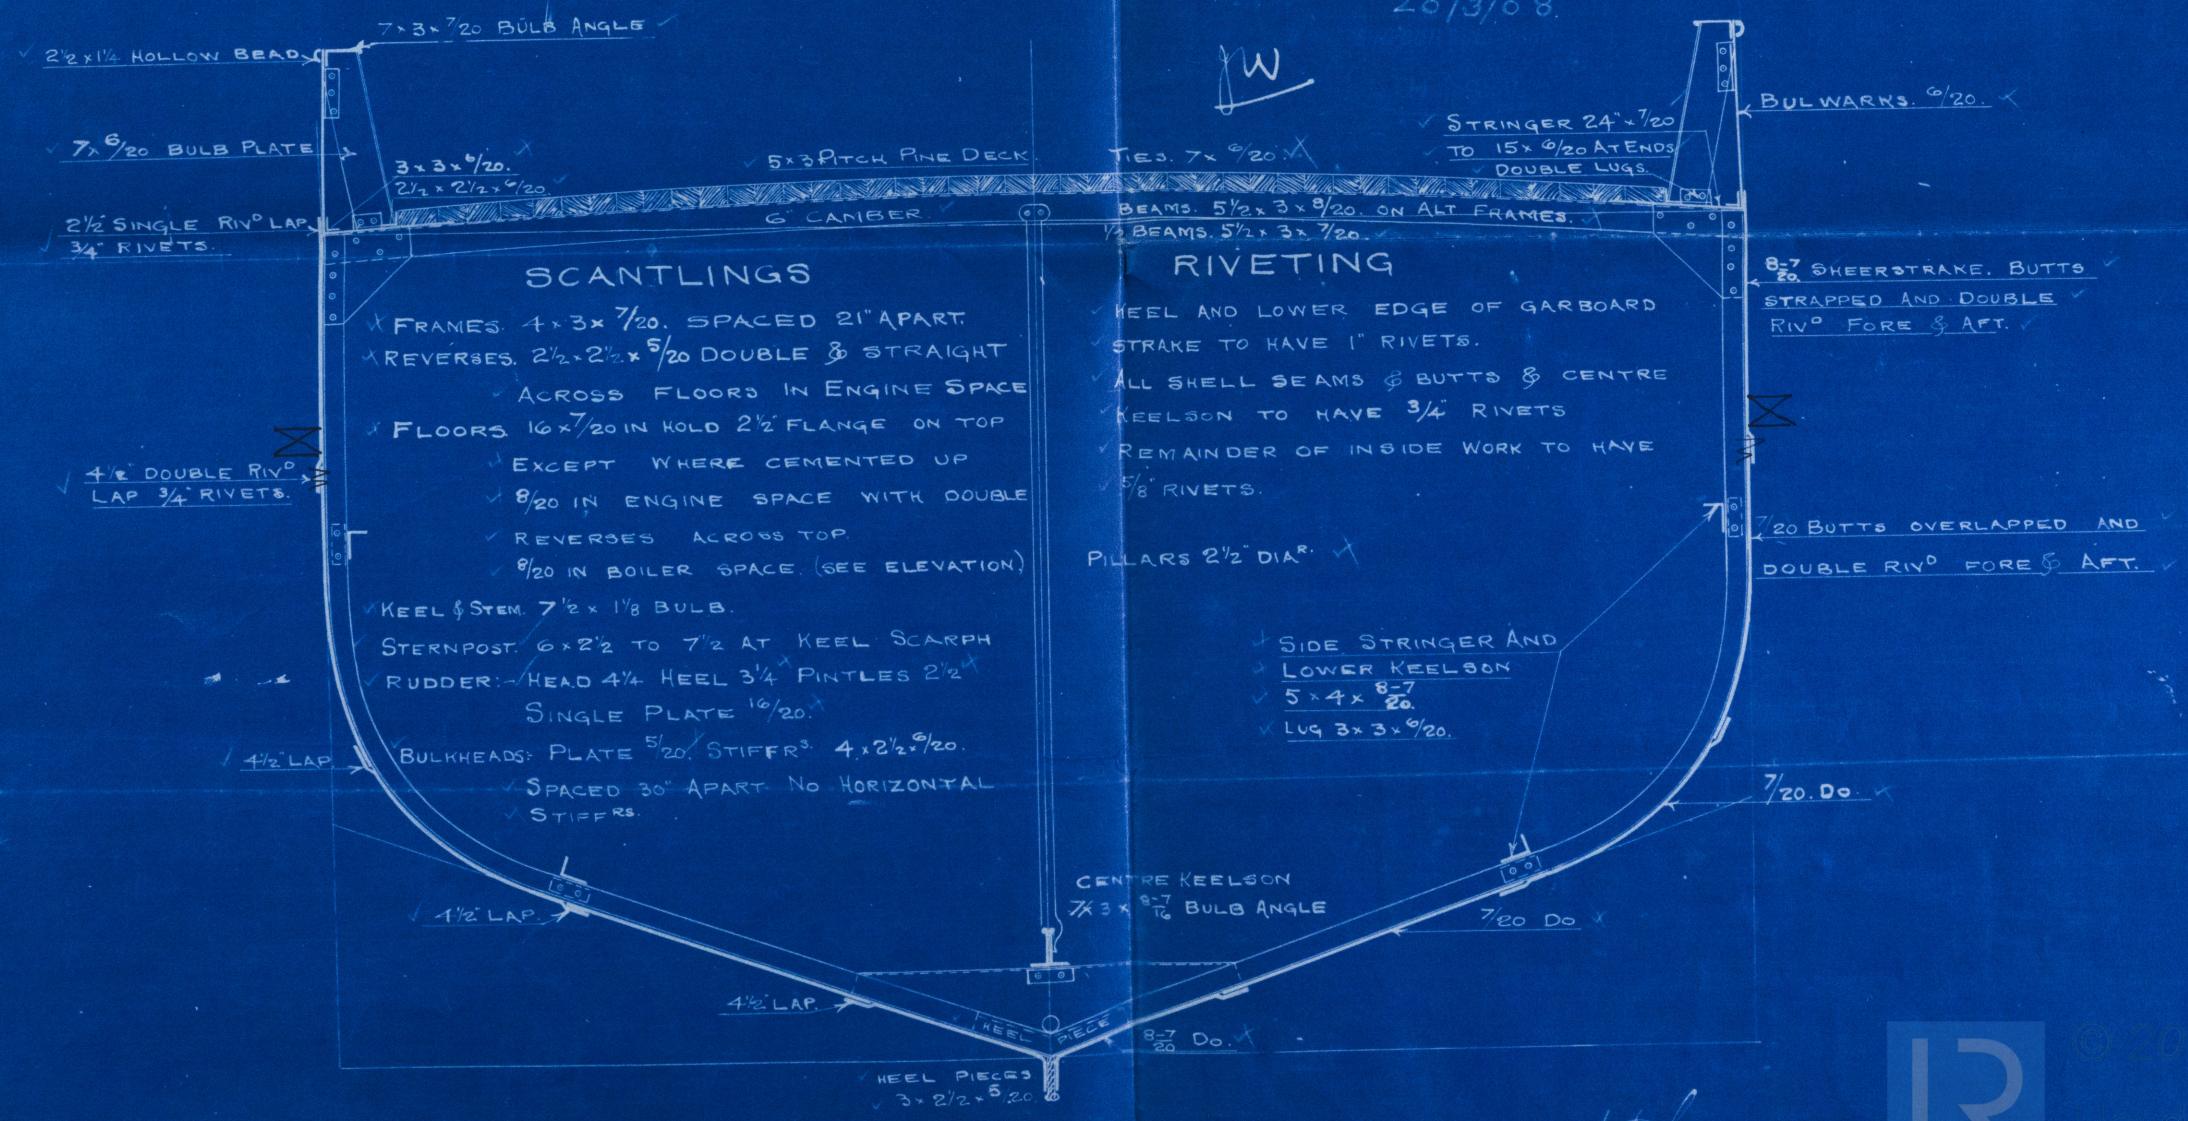

14/1  
 24/3/08



Smith's Dock Co's  
No. 819

S.S.T. <sup>The Norman</sup> Kirkland.  
Midship Section

S.S. "~~Kirkland~~"

Newcastle Report

53857  
No. ~~55443~~



© 2019

Lloyd's Register  
Foundation