


DIMENSIONS


LENGTH BETWEEN PERPENDICULARS	110' 0"	$1^{st} N^o$	21.75 + 12.625 =	34.375	
BREADTH MOULDED	21' 9"	$2^{nd} N^o$	34.375 × 110 =	3781.25	
DEPTH MOULDED	12' 7½"	$\frac{2}{3}$ AMOSHIP	$\frac{2}{3} \times 110 =$	73.33	
		$\frac{1}{3}$	8.06	$\frac{1}{3} \times 110 =$	36.66

GRADE 100 A.1 "STEAM TRAWLER"

SCALE $\frac{1}{2}$ INCH = 1 FOOT

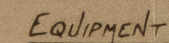

	ANCHOR	S. GWT.	EX.	STOCK
1	"	42	"	
1	"	22	"	
90	FATHOMS	1"	STUD CHAIN	CABLE
60	"	5 $\frac{1}{2}$ "	MANILLA	
60	"	4"	"	
45	"	2 $\frac{1}{2}$ "	"	

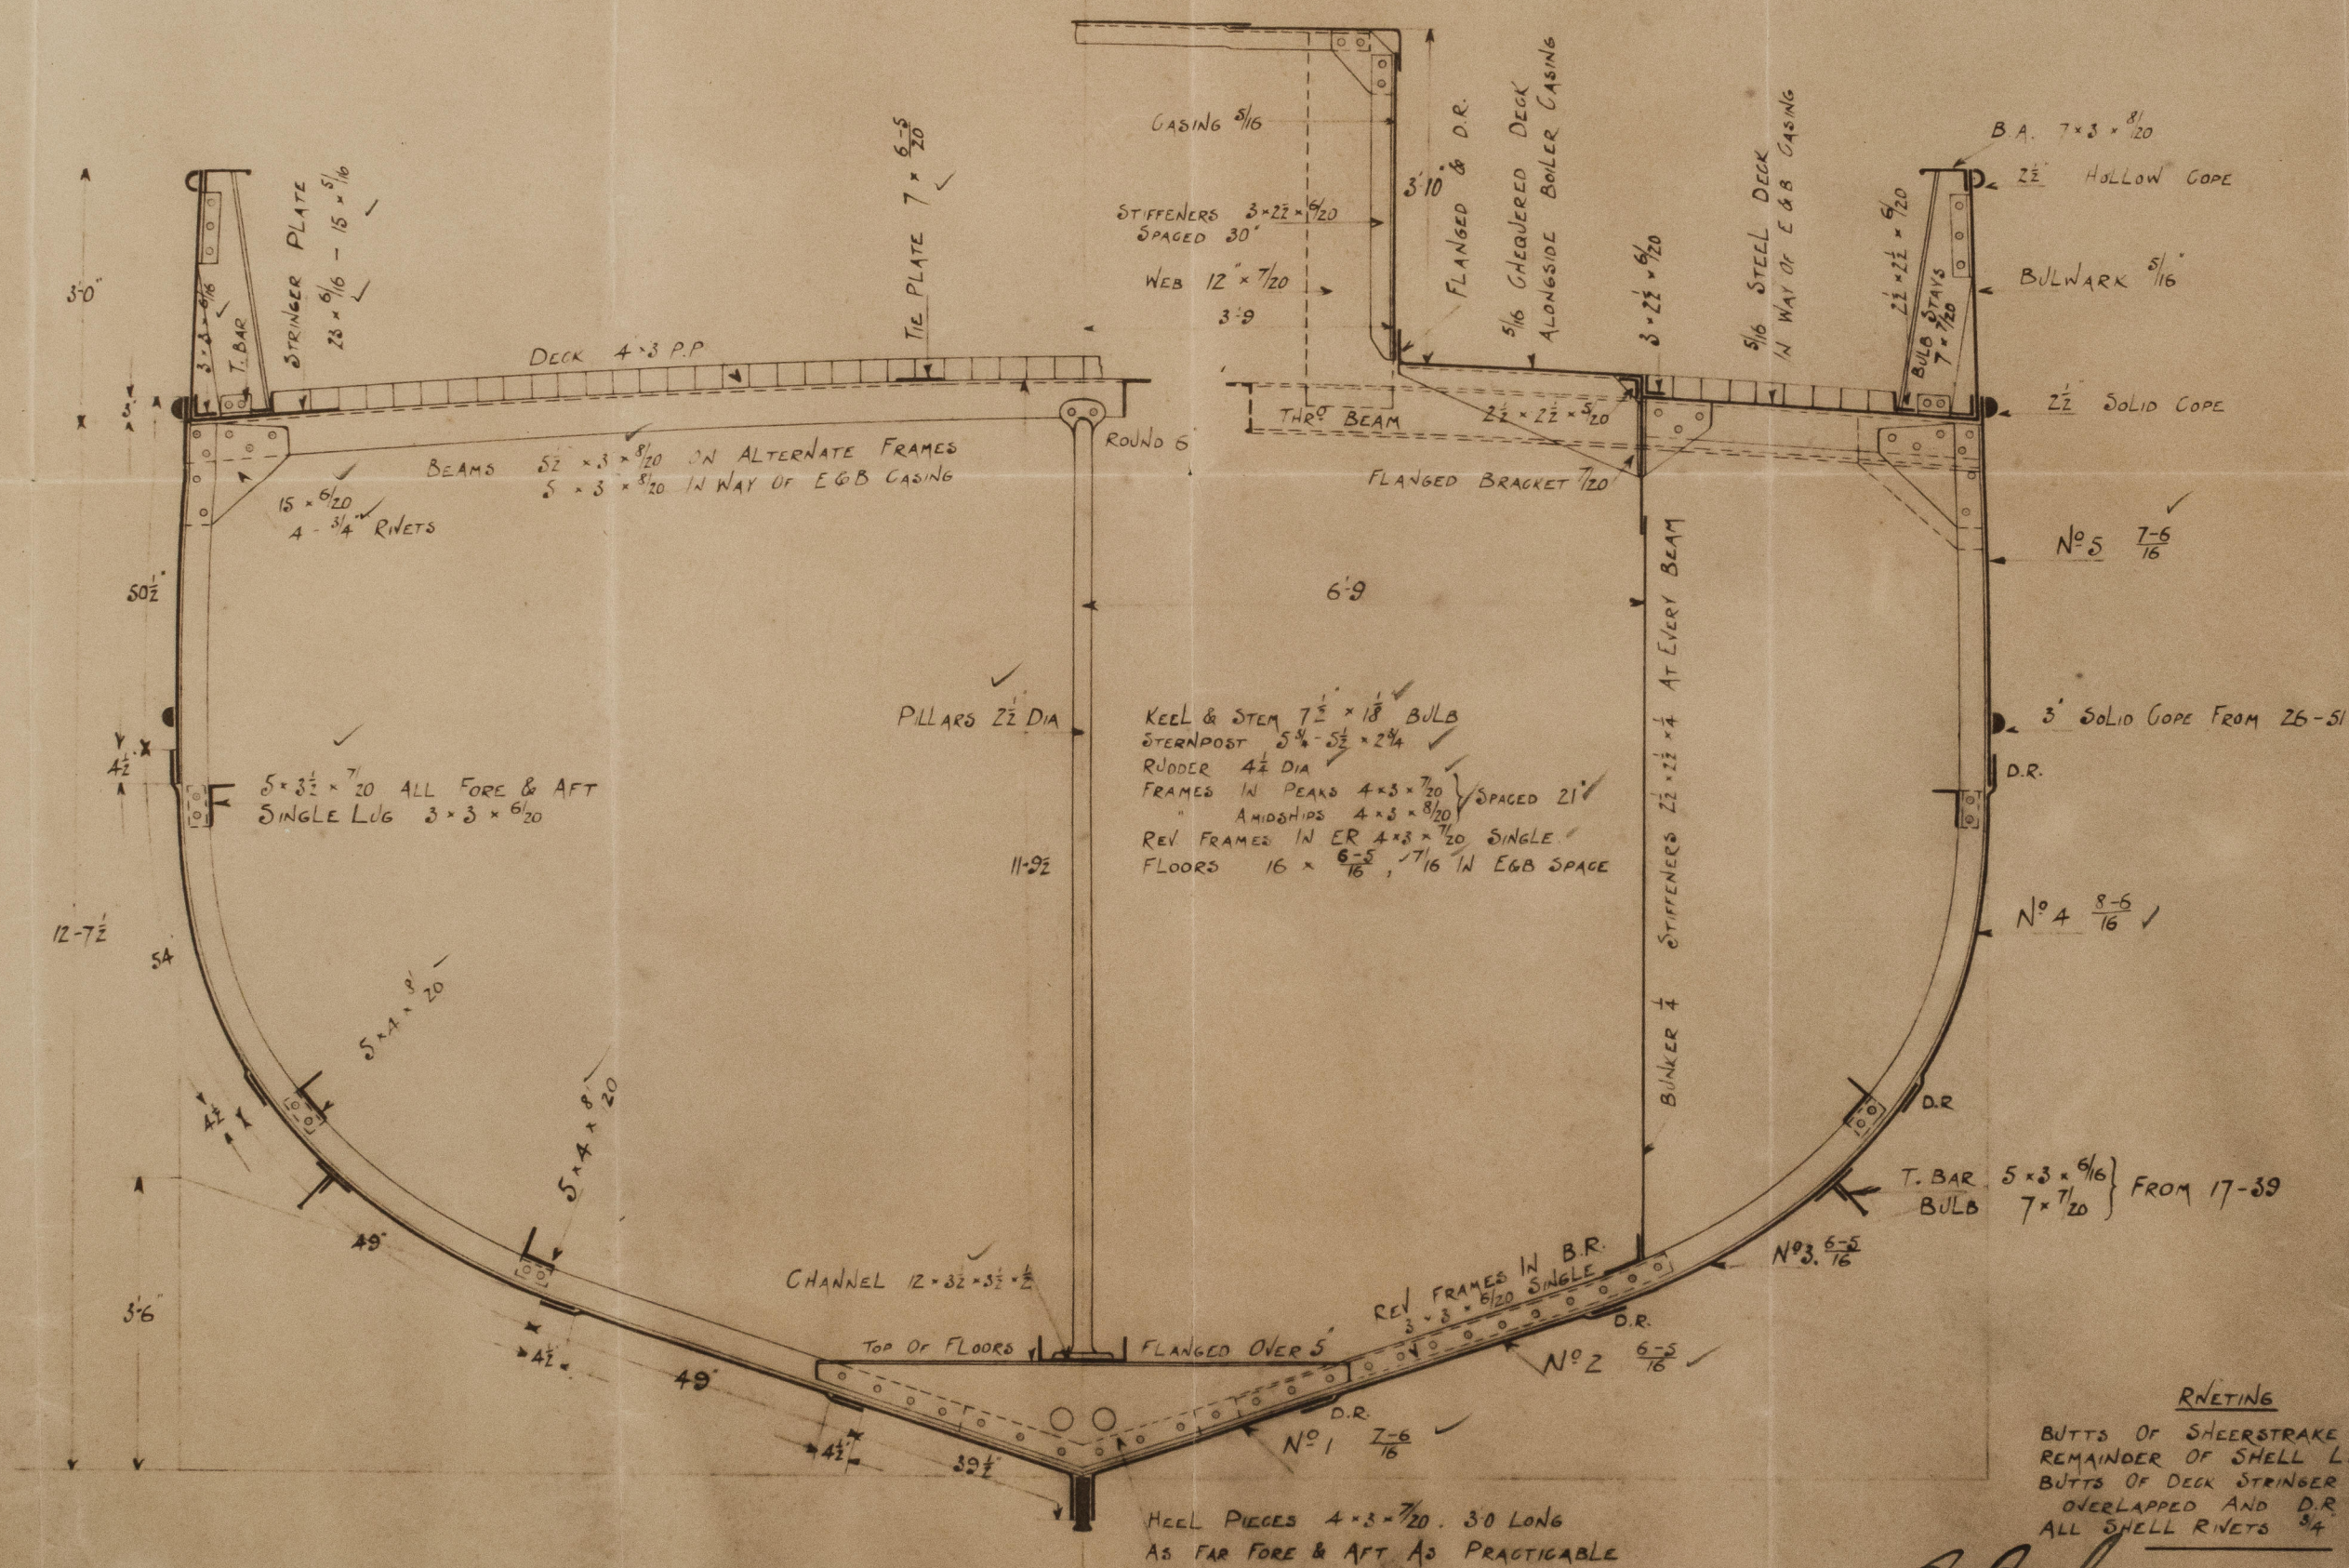

N^o 566.




Hall Russell & Co. Ltd.

No. 566.

Knidship Section

S.S. "Eveline Mitten"

Ubr rept. No. 11715.

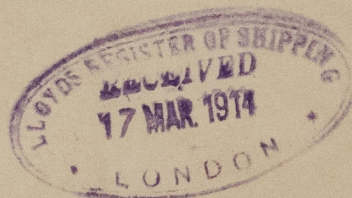

© 2021

Lloyd's Register
Foundation