


$1^{st} N^o$ 34.375 $2^{nd} N^o$ 3781.25

SCALE $\frac{1}{4}$ INCH = 1 FOOT

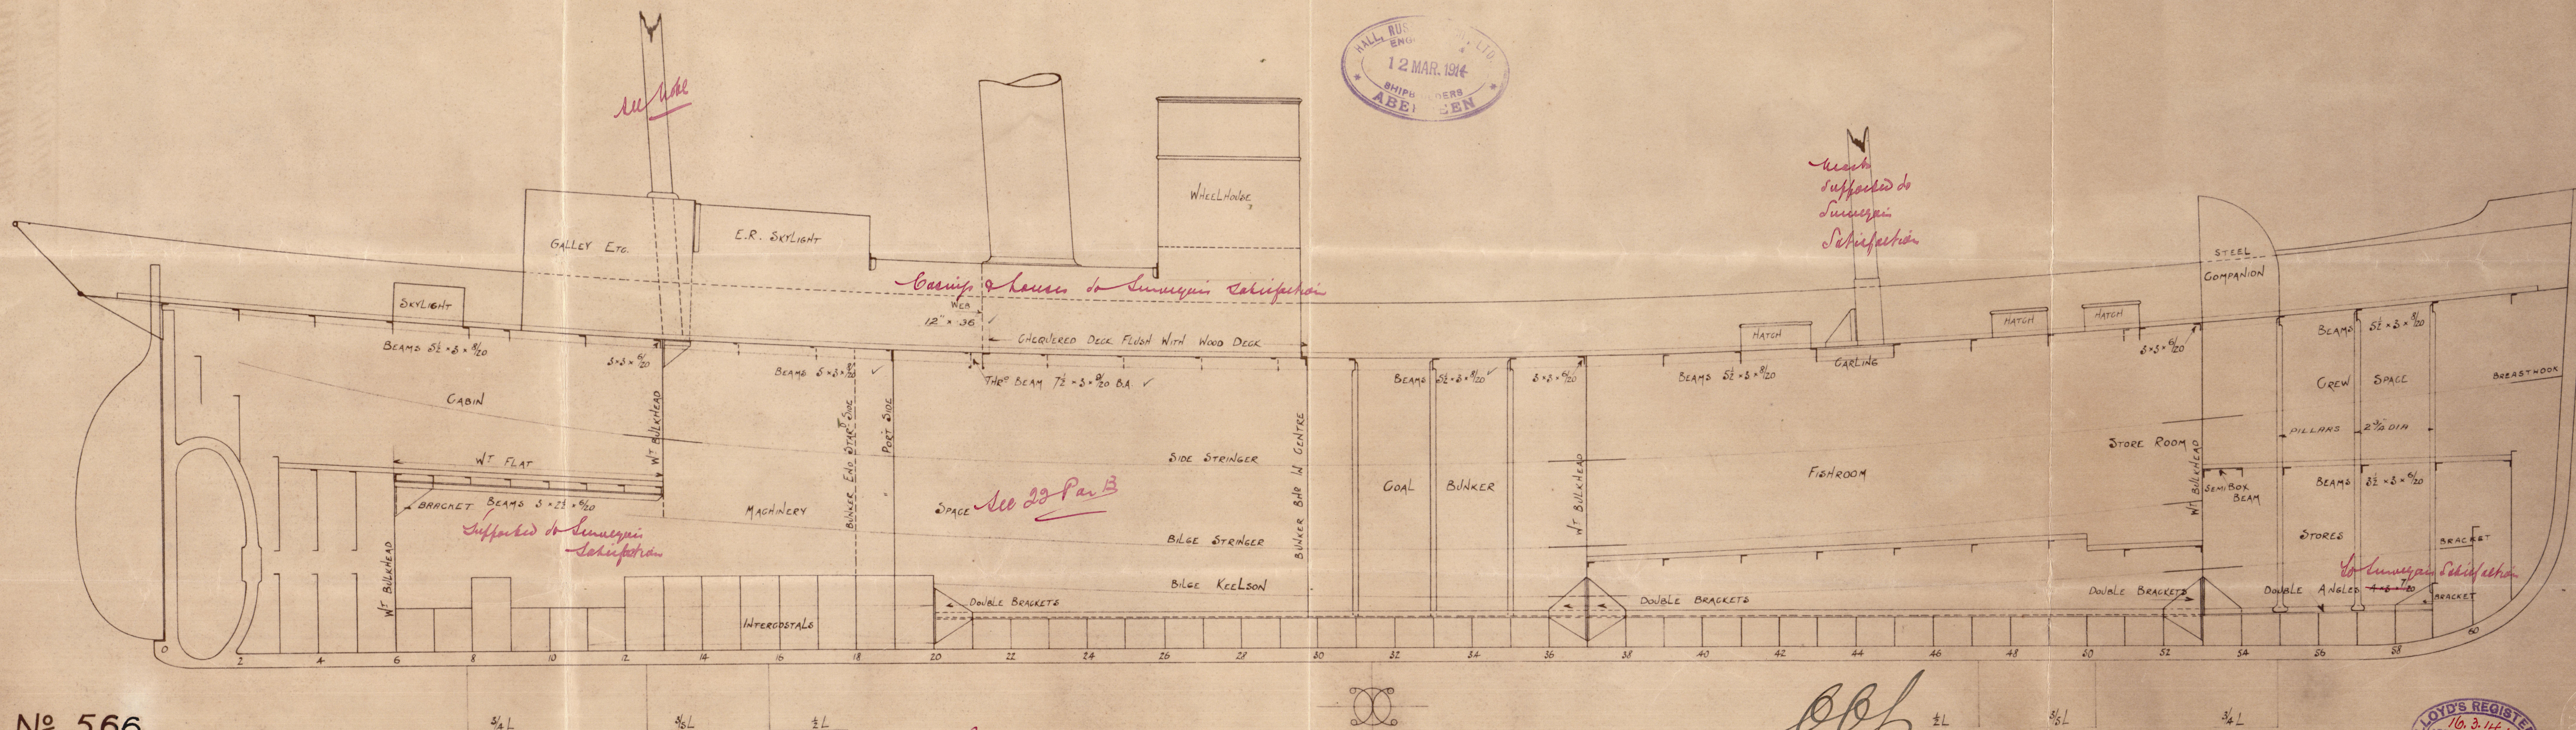

Nº 566.

Pillaring throughout to Immigrant
Satisfaction

BB
18.3.14.



Lloyd's Register
Foundation


Wall Russell & Co. Ltd.

No. 566.

Profile.

S.S. "Coeline Nutter."

Abn. Rep. No. 114/15.

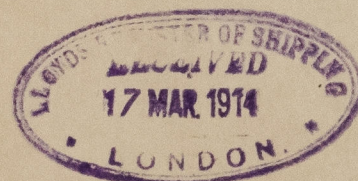

© 2021

Lloyd's Register
Foundation