

# DRAWING N° 3832

## M/V "BADGER"

### PROFILE AND DECK PLAN

SCALE: 1/4 INCH = 1 FOOT

LENGTH B.P. 242'2 (264'0 DA)

BREADTH MLD 40'0






DEPTH MLD TO UPPER/DR MAIN DECK 23'8

HEIGHT POOP AND FORECASTLE 7'2

HEIGHT BRIDGE 7'10

CLASS 100A1

PARTICULARS OF EQUIPMENT ON BOARD TO BE SUBMITTED

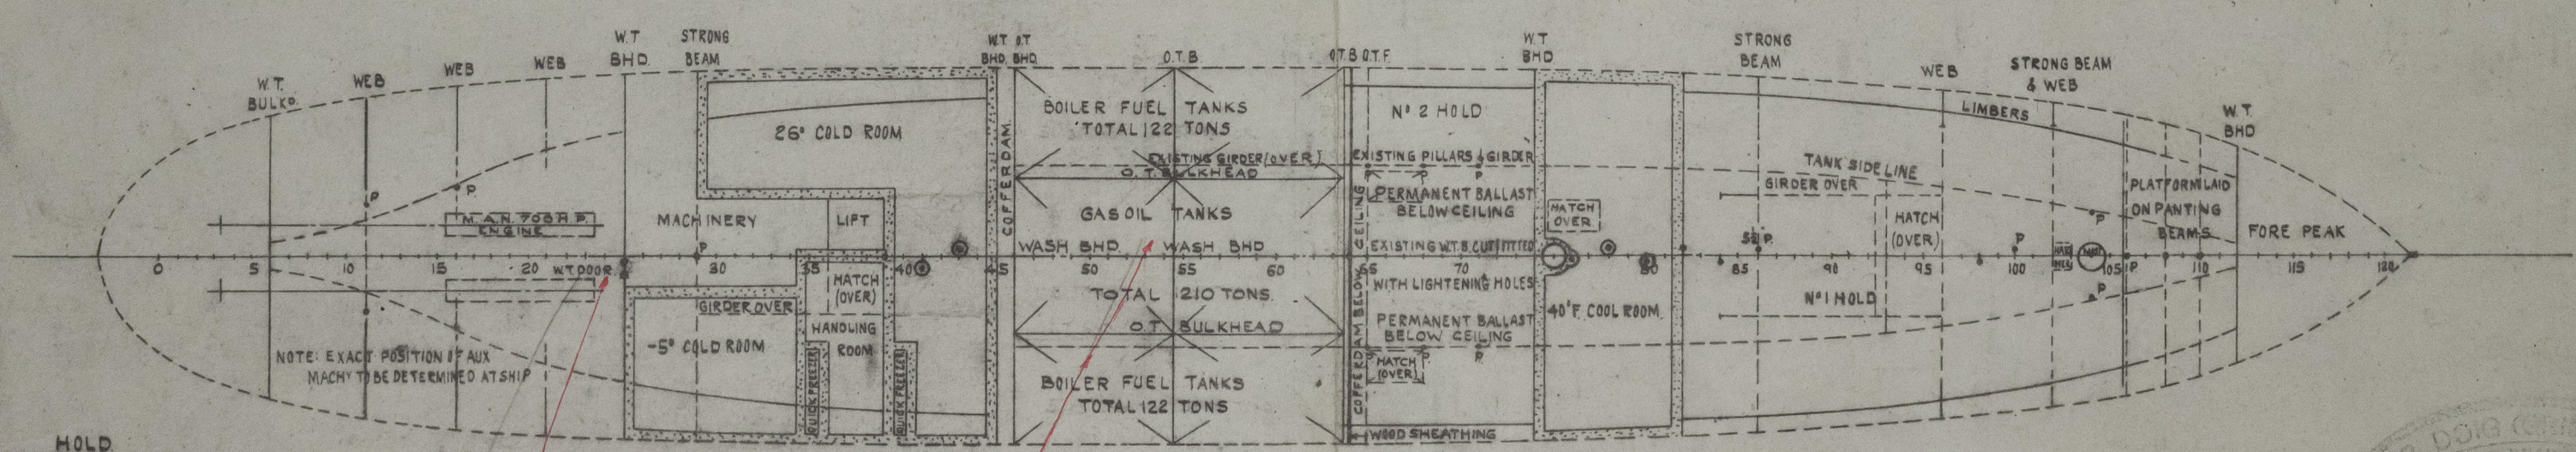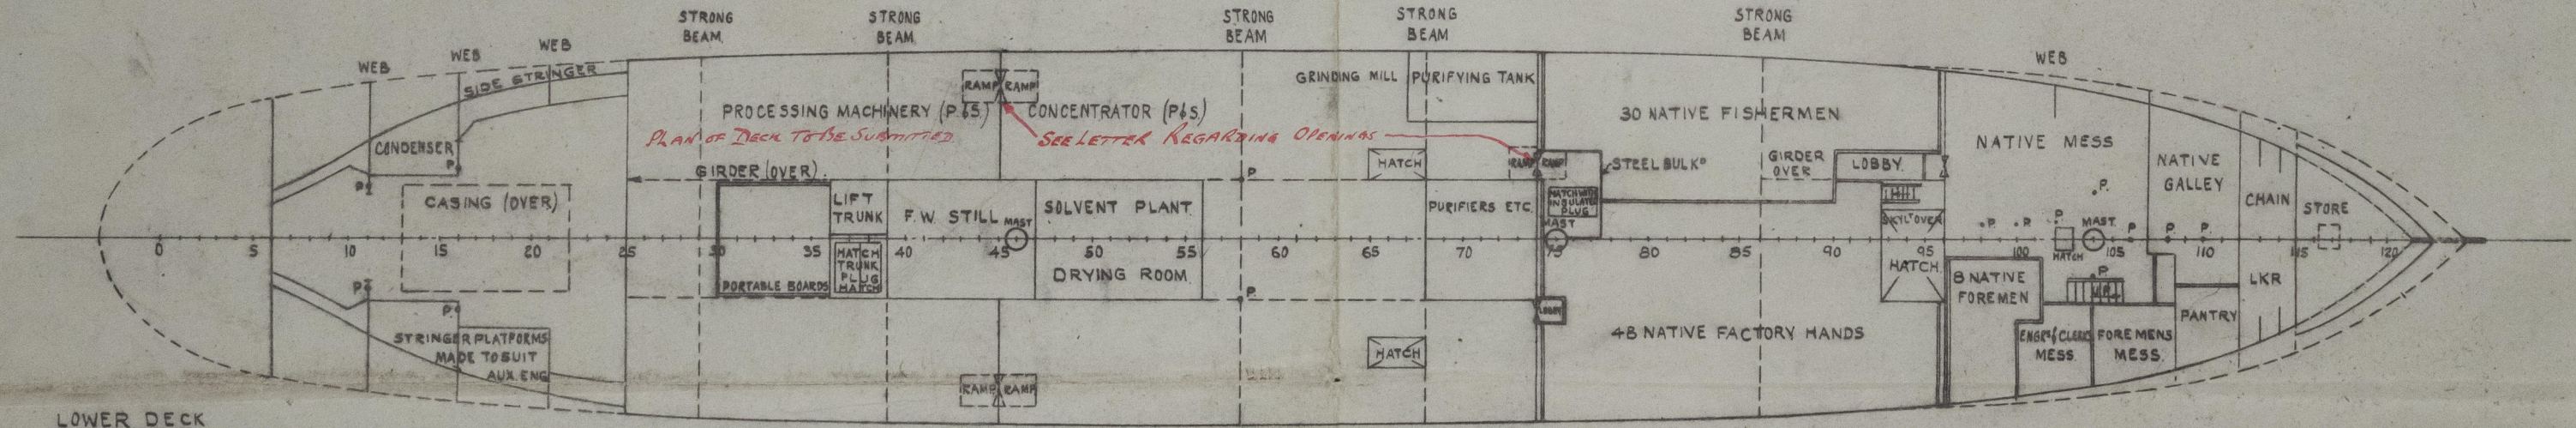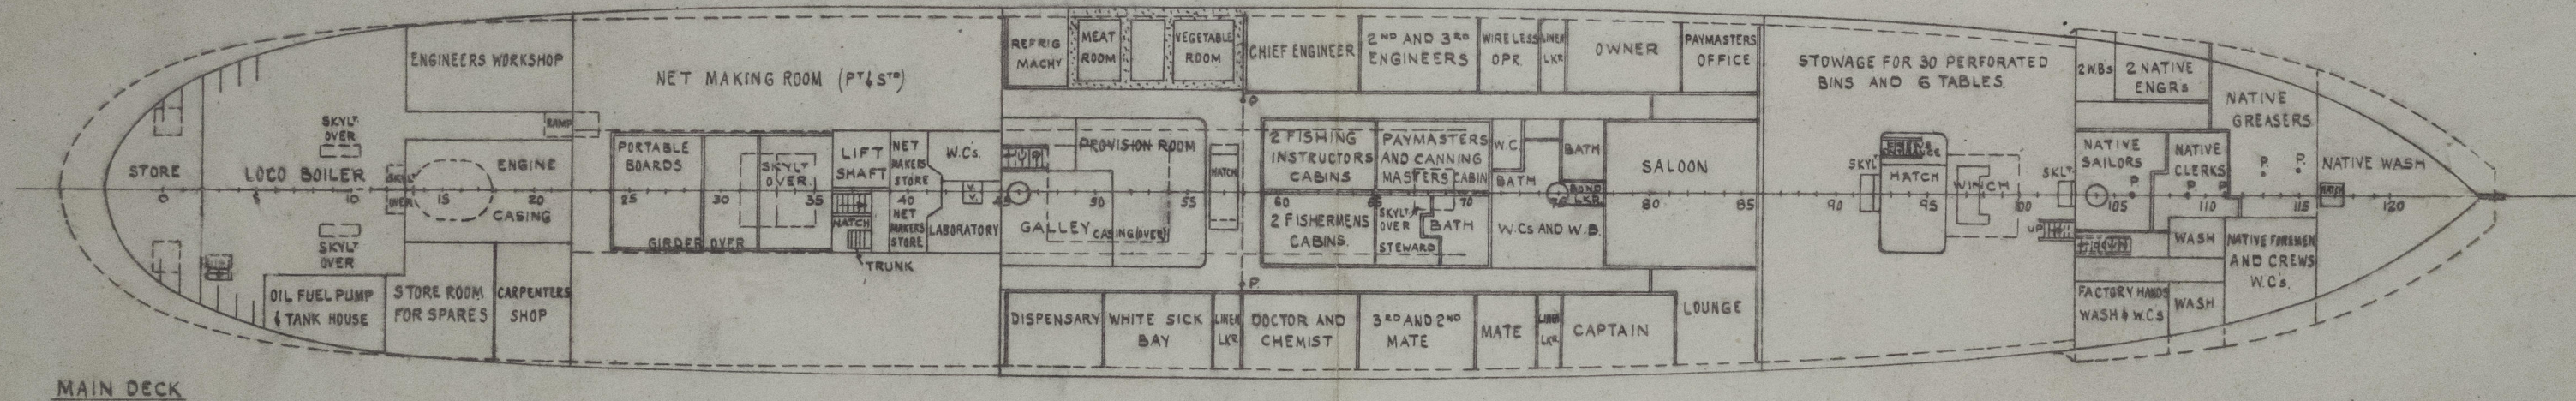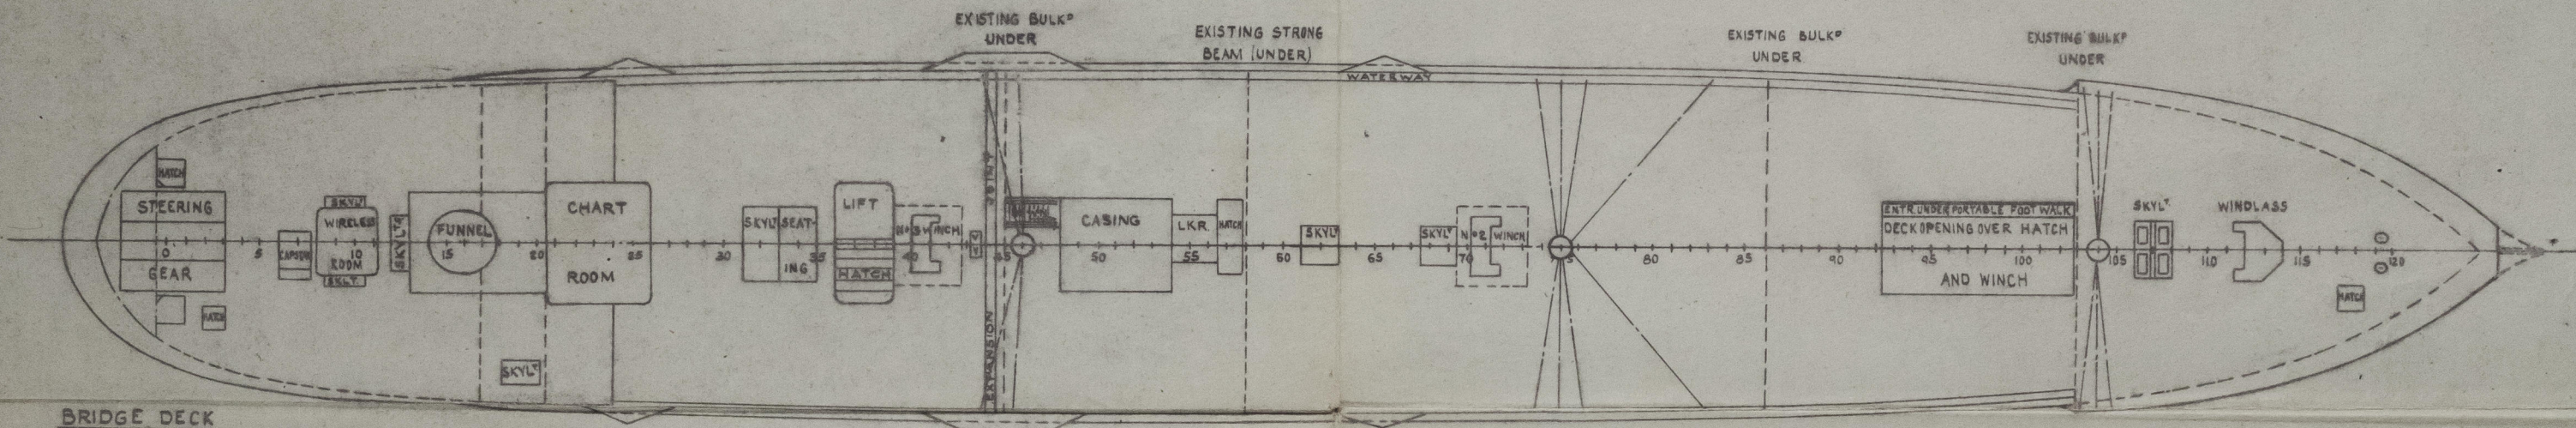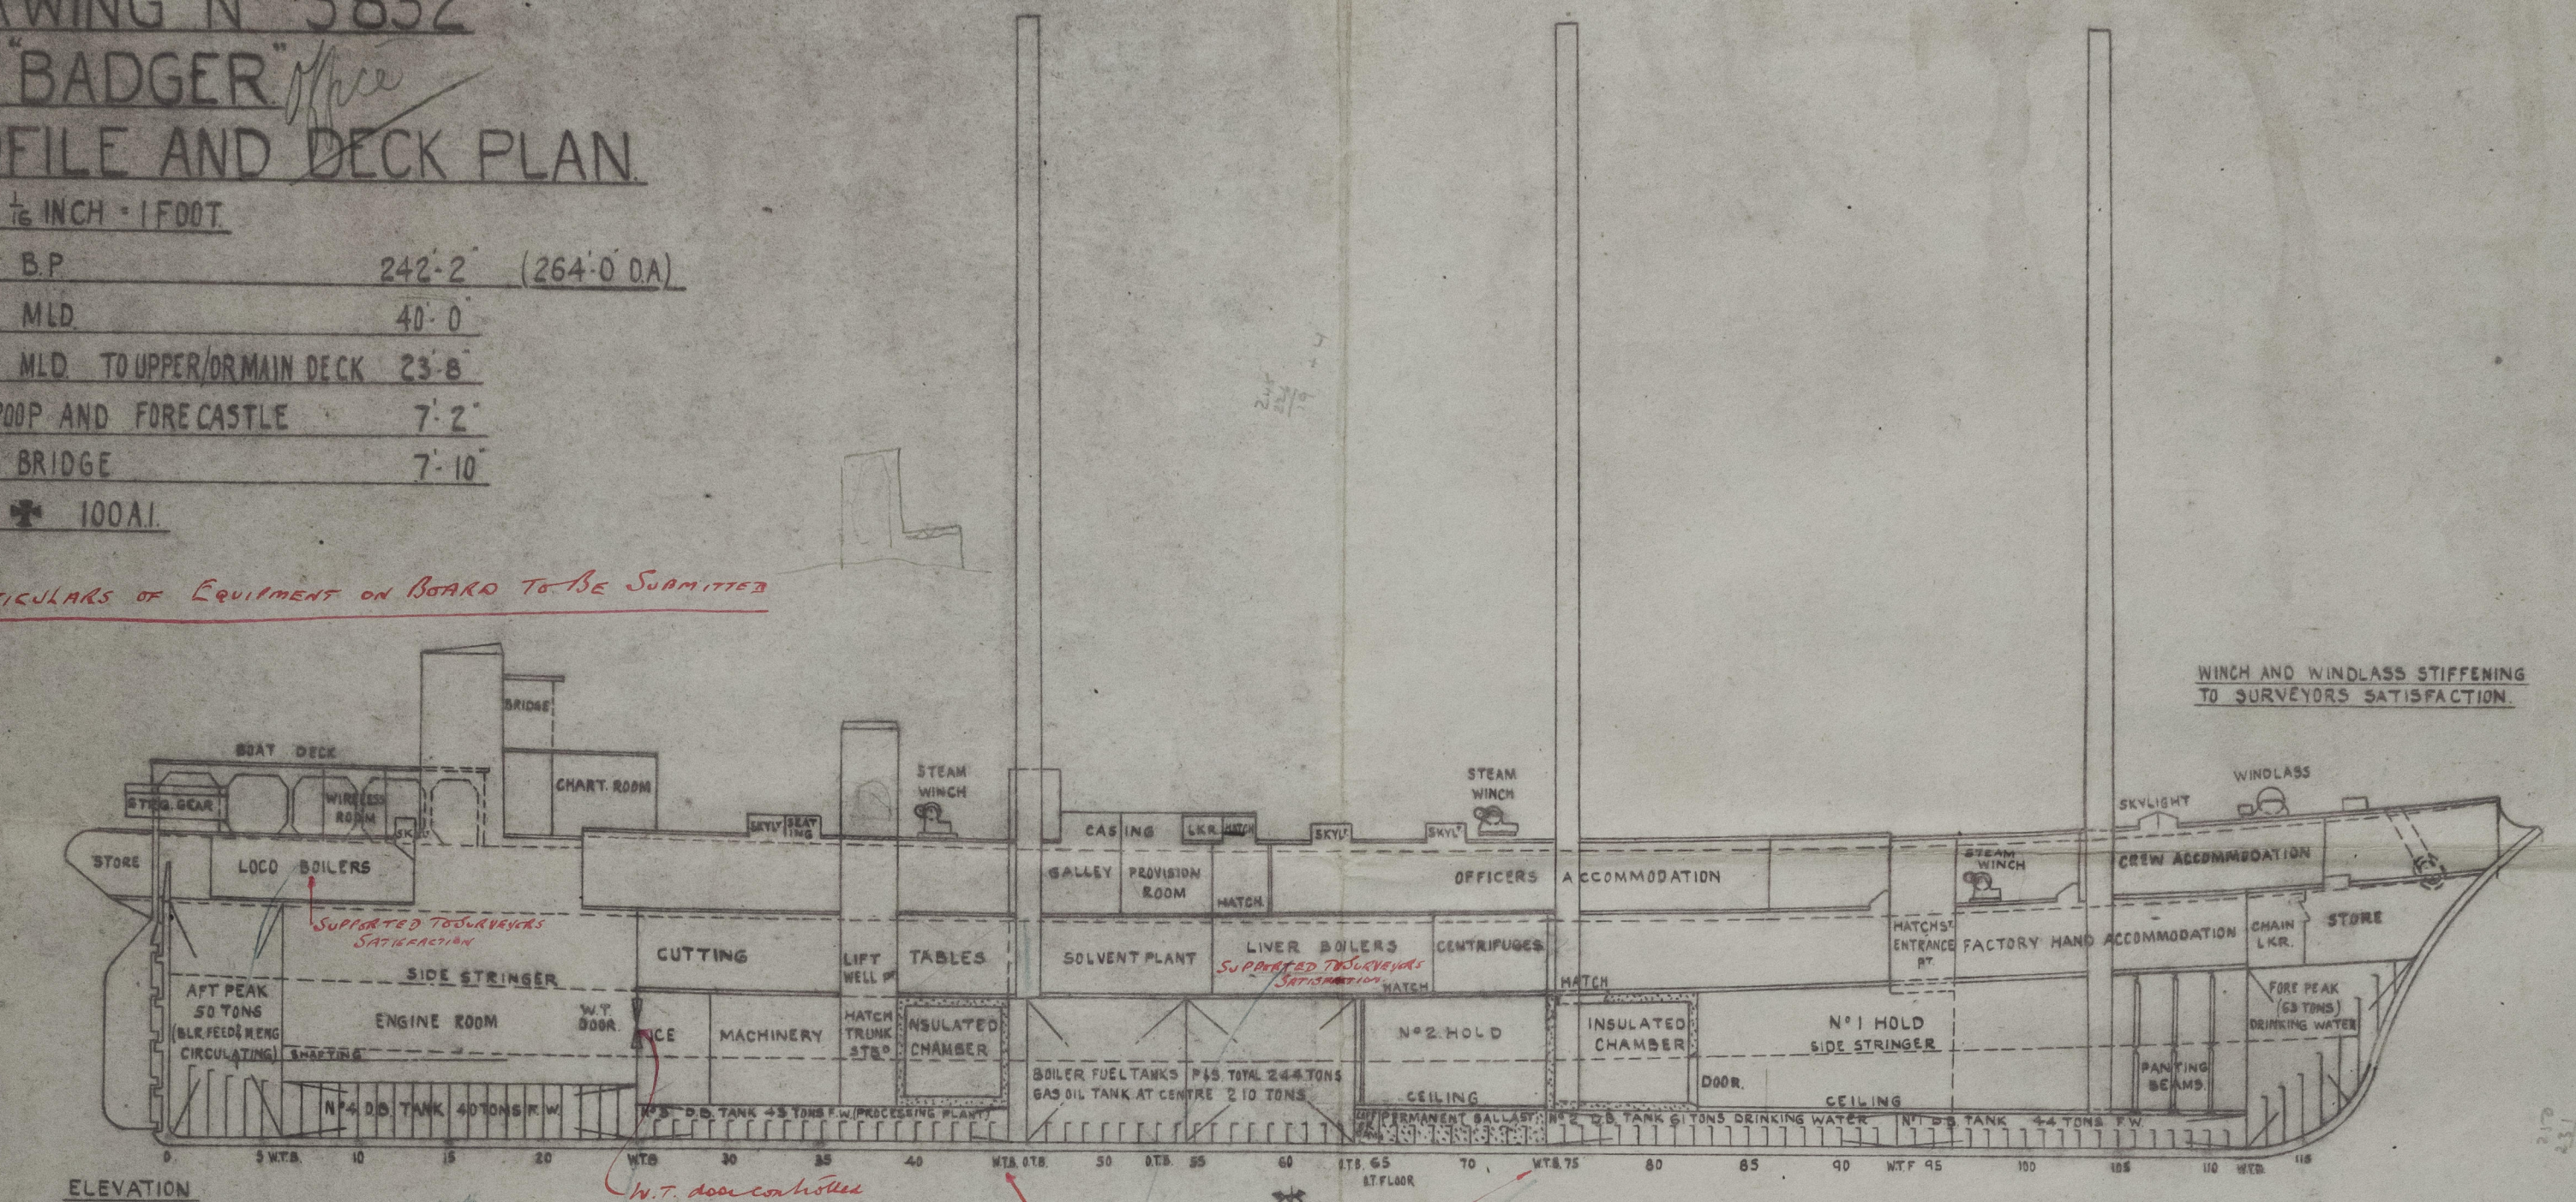

9/12/49





*Spec*

GRIMSBY. 24353.



M/V BADGER

PROFILE & DECK

G/A

alteration Plan

RECORDS DEPT.  
LONDON

2



© 2020

Lloyd's Register  
Foundation

008628-008633-0001