



29.8.16

TOP OF KEELSON.

TOP OF DEEP TANK

8'-10"

UPPER DECK


BOOM

23'-6"

9'-6"


TOTAL LENGTH 114'-0"

EXPANSION OF MASTPLATES.

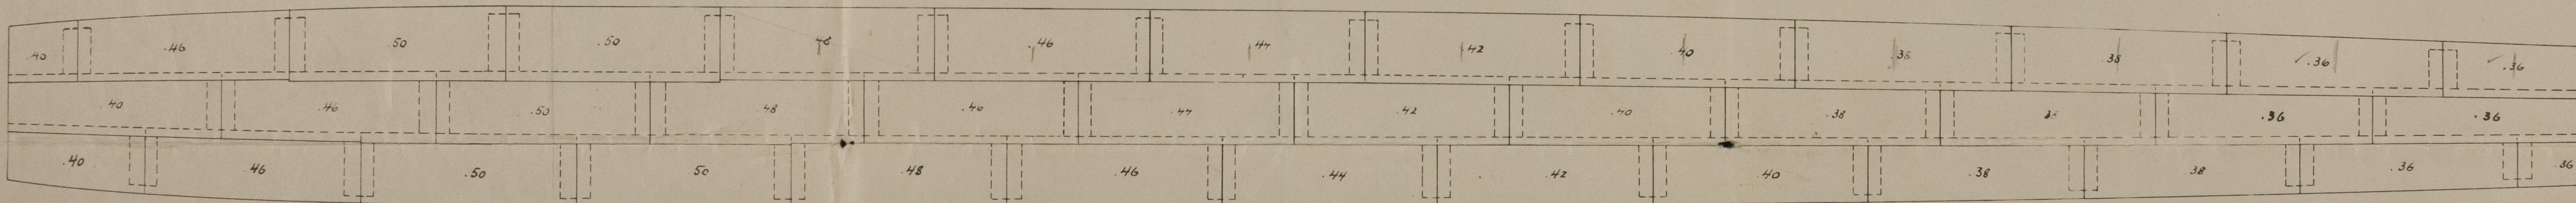

Q83. ONE MAST TO BE PLACED ON THE TOP OF THE DEEP TANK THIS BEING SPECIALLY STRENGTHENED AND SUPPORTED BELOW. ALL PLATES OF THIS MAST TO BE .50" THICK BELOW UPPER DECK.

to Surveyor's satisfaction.

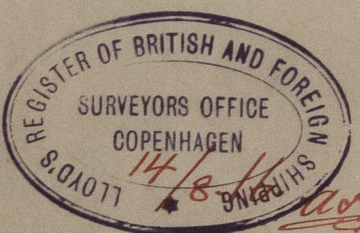

SEAMS DOUBLE RIVETED. $5\frac{1}{4}$ " OVERLAP. $\frac{7}{8}$ " RIVETS. $4\frac{3}{8}$ " C.TOC. FOR PLATES ~~48"~~ AND ABOVE. 48"

" " " $4\frac{1}{2}$ " " $\frac{3}{4}$ " " $3\frac{3}{4}$ " " " ~~48"~~ AND ABOVE. 48"

BUTTS TREBLE " $16\frac{3}{4}$ " STRAPS $\frac{7}{8}$ " " $4\frac{3}{8}$ " " " ~~48"~~ AND ABOVE. 48"

" " " $14\frac{1}{4}$ " " $\frac{3}{4}$ " " $3\frac{3}{4}$ " " " ~~48"~~ AND ABOVE. 48"

BUTTSTRAPS TO BE $\frac{1}{20}$ " THICKER THAN THE PLATES WHICH THEY ARE CONNECTING

EACH MAST TO BE FITTED WITH 3 ANGLES $5\frac{1}{2} \times 3 \times .46$ PLACED ON THE MIDDLE LINE OF EACH STRAKE AND EXTENDING FOR THE FULL LENGTH OF THE MASTS.


DOUBLINGS 4" WIDE TO BE PLACED IN WAY OF WEDGINGS, AND SUITABLE DOUBLINGS TO BE FITTED AT heel-end at the CAPS AND WHERE LOCAL STRESSES ARE TRANSFERRED FROM BOOMS AND JAWS.

Four Mast Fore-and aft Schooner.

Masts.

SCALE $\frac{1}{4}$ " = 1'.


MATERIAL: STEEL. ALL FOUR MASTS ALIKE.

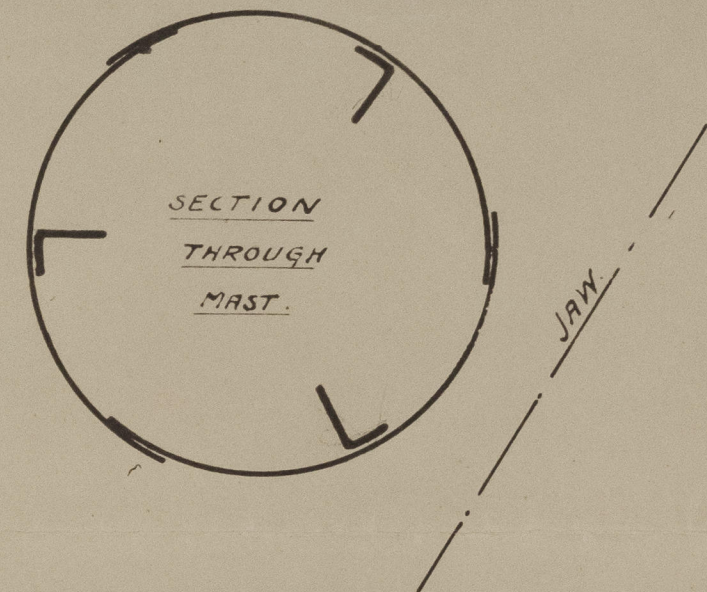

DIAMETER OF ALL MAST AT PARTNERS. 32" -
" " " " " HEEL 25" -
" " " " " TOP 21" -


29.8.16

See 8 August 1916

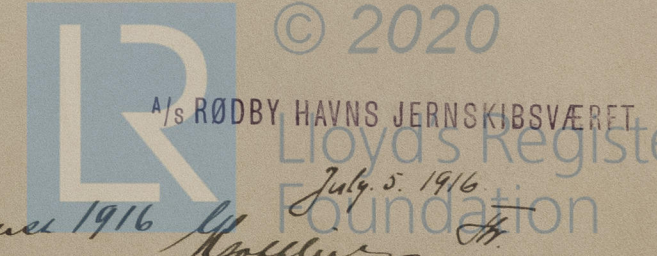

008628-008633-0002

Marks ⁽⁶⁾
for
Messrs. Rødby Havns
Jernskibsvarfts Yard
Nos 1, 2 & 3.

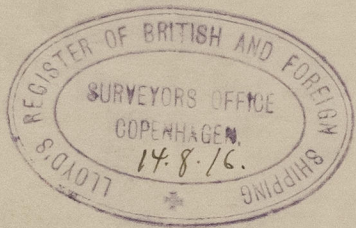

M⁴ "Westward"⁷
EX
'Dampfoll' Gpm. Rpt. No. 626.



© 2020

Lloyd's Register
Foundation