

20-7-16  
29-8-16  
24-11-16

EEN


PROFILE AND DECK PLANS TO 4 MAST SAILING VESSEL.

| DIMENSIONS                  |         |
|-----------------------------|---------|
| LENGTH REGULATING SCANTLING | 247'-0" |
| LENGTH OUTSIDE STEMS        | 243'-6" |
| BREADTH MOULDED             | 40'-0"  |
| DEPTH                       | 23'-8"  |
| HEIGHT OF FORECASTLE        | 6'-6"   |
| BRIDGE                      | 7'-10"  |
| POOP                        | 7'-0"   |

TYPE: FORECASTLE, SHORT BRIDGE, POOP AFT  
MATERIAL: STEEL  
DRAFT: 4'-0"

ALL THICKNESSES 1/4 IN.

CLASS: BRITISH LLOYD 100 R/L. SCALE 1/8" = 1'

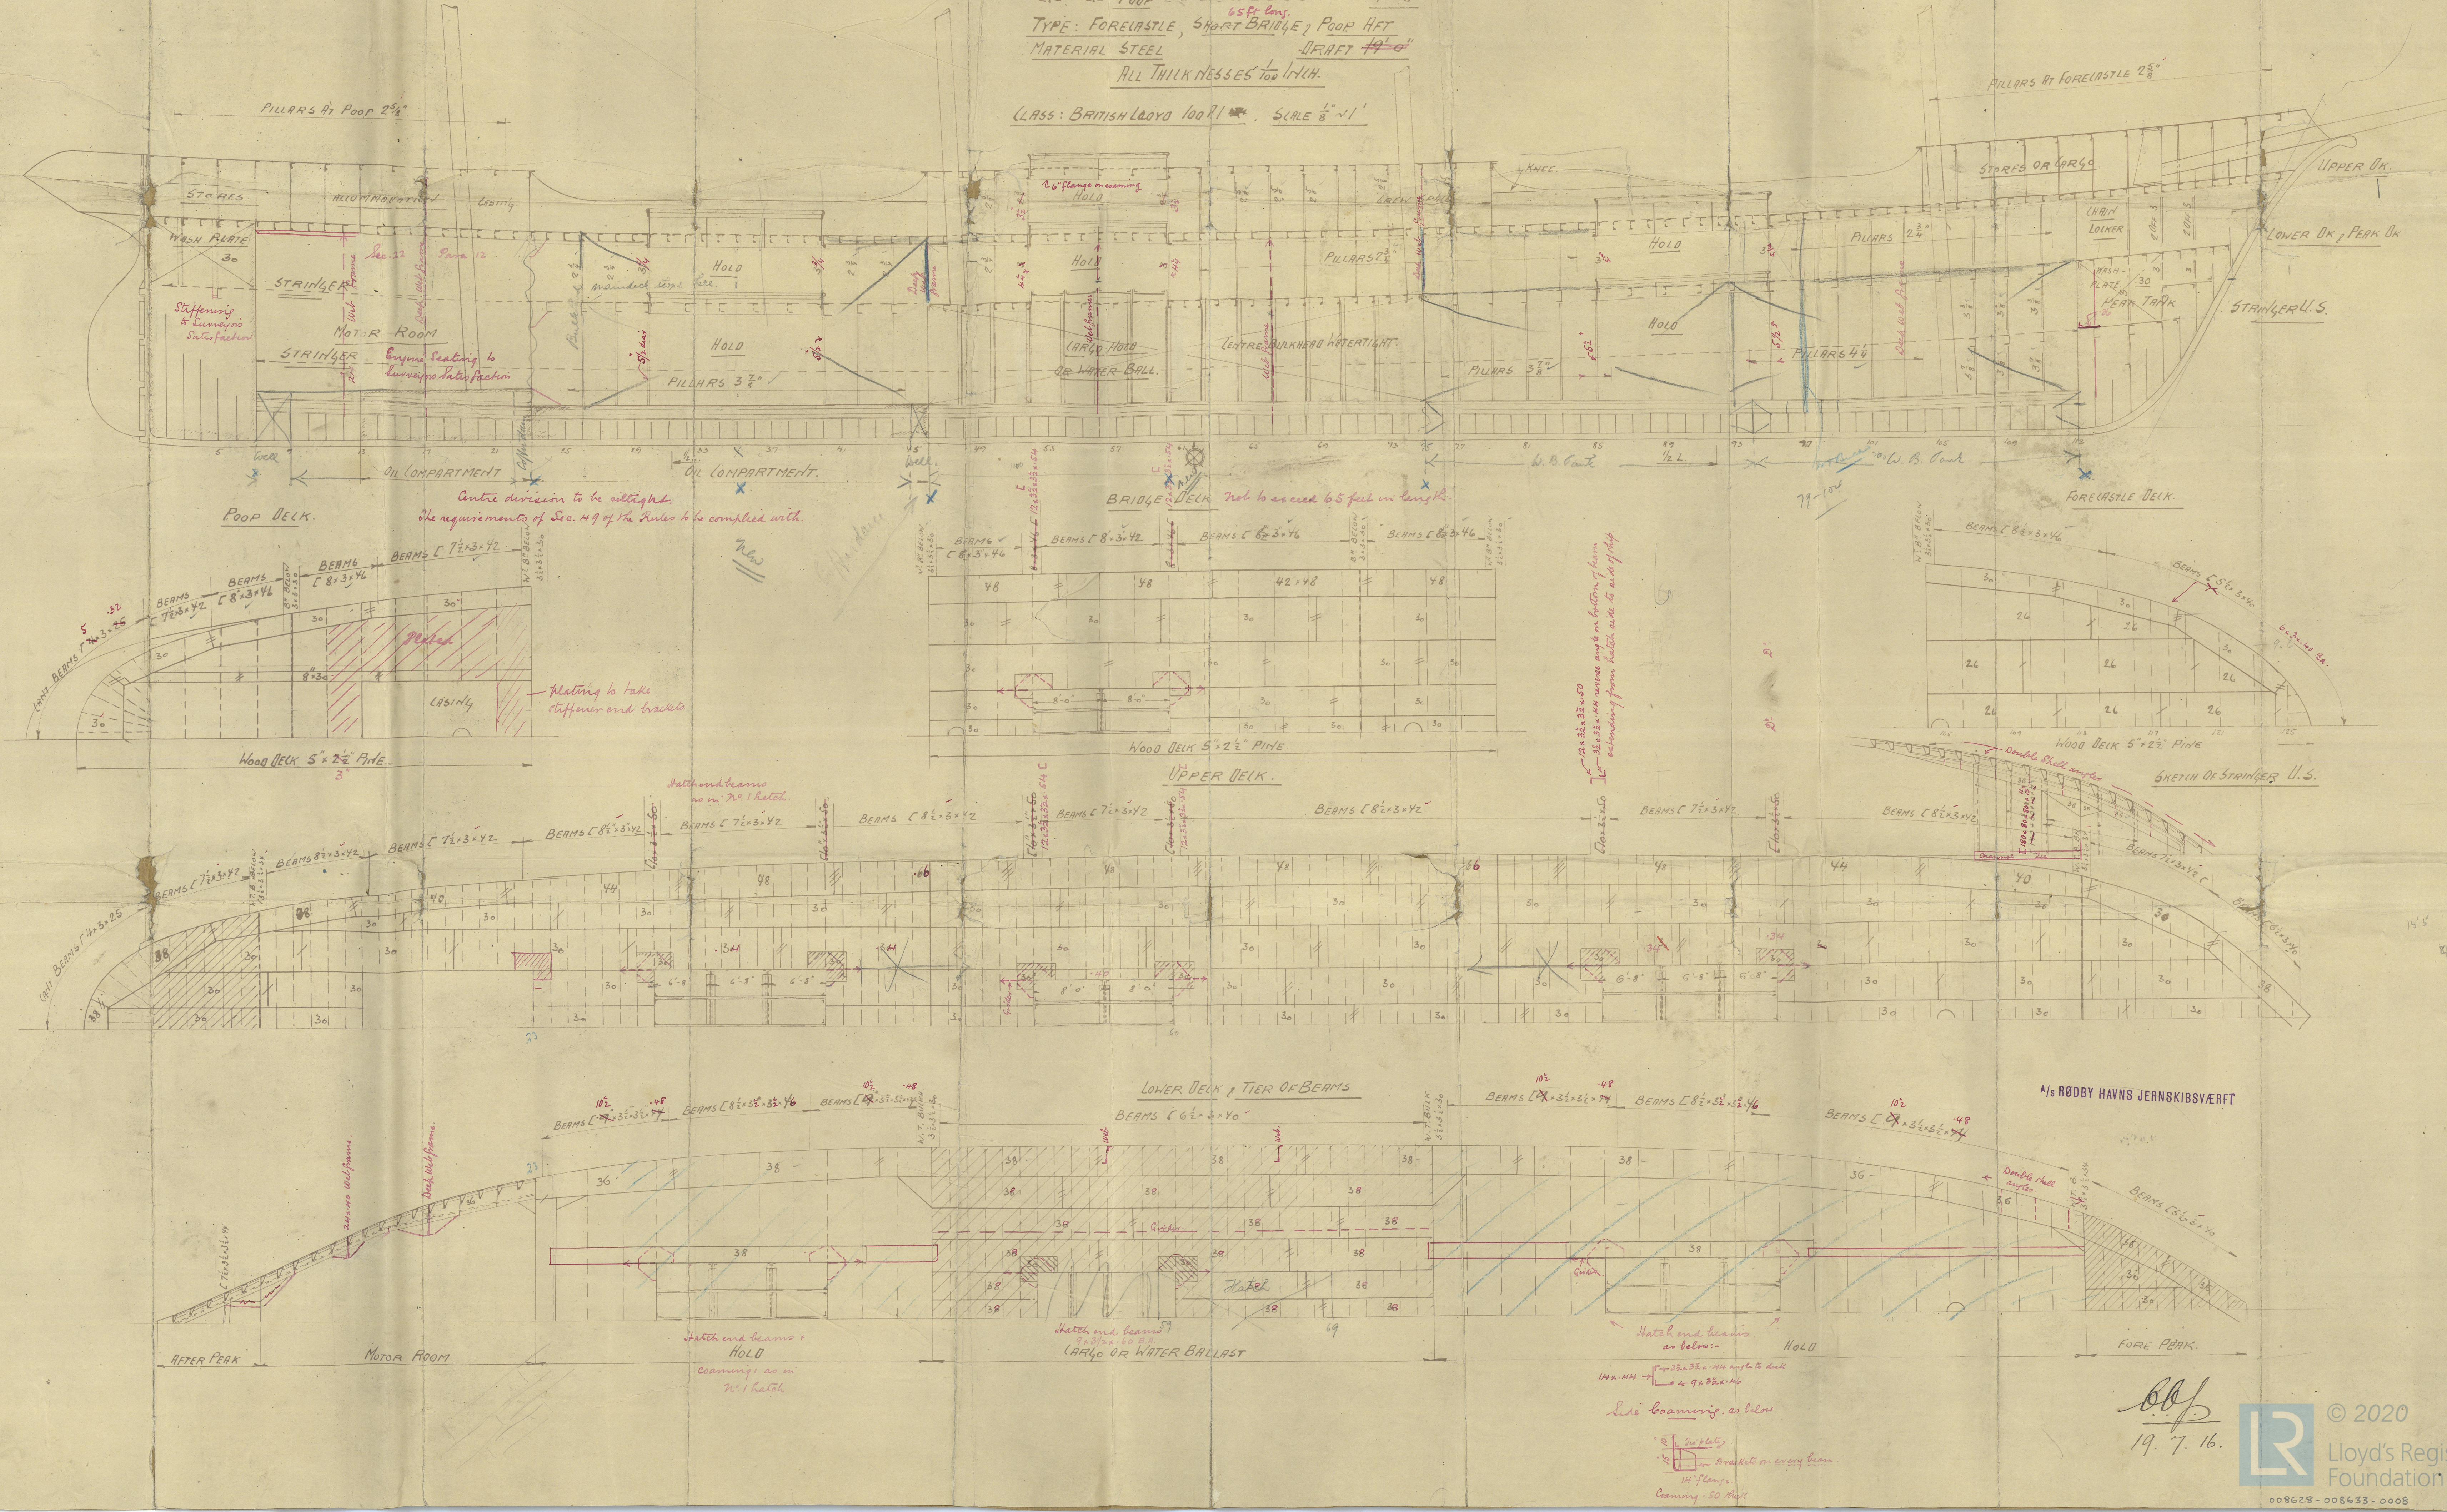

19.7.16.



NIN AFRICAN  
s. Røddbyhavn's  
Jernskibsselskab.


Røddbyhavn.  
Denmark.

4<sup>th</sup> Sailing ship.


Longitudinal  
Section

& Deckplans.

Aft View

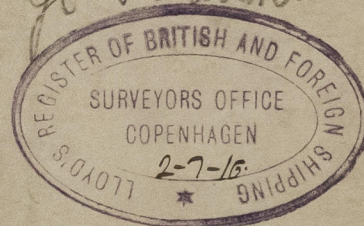

RANGER 37

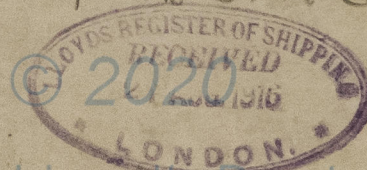

Lloyd's Register  
Foundation

008628-008633-0008