



M/V BADGER RIGGING PLAN

SCALE 3/4" = 1 FOOT.

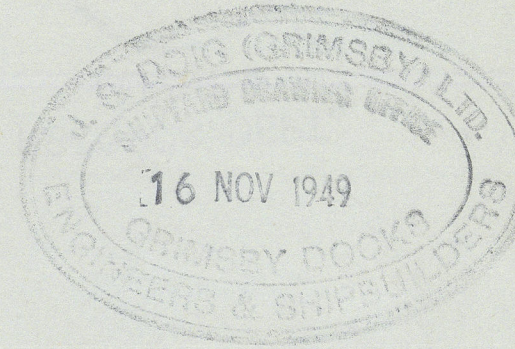


Assumed original masts on ship

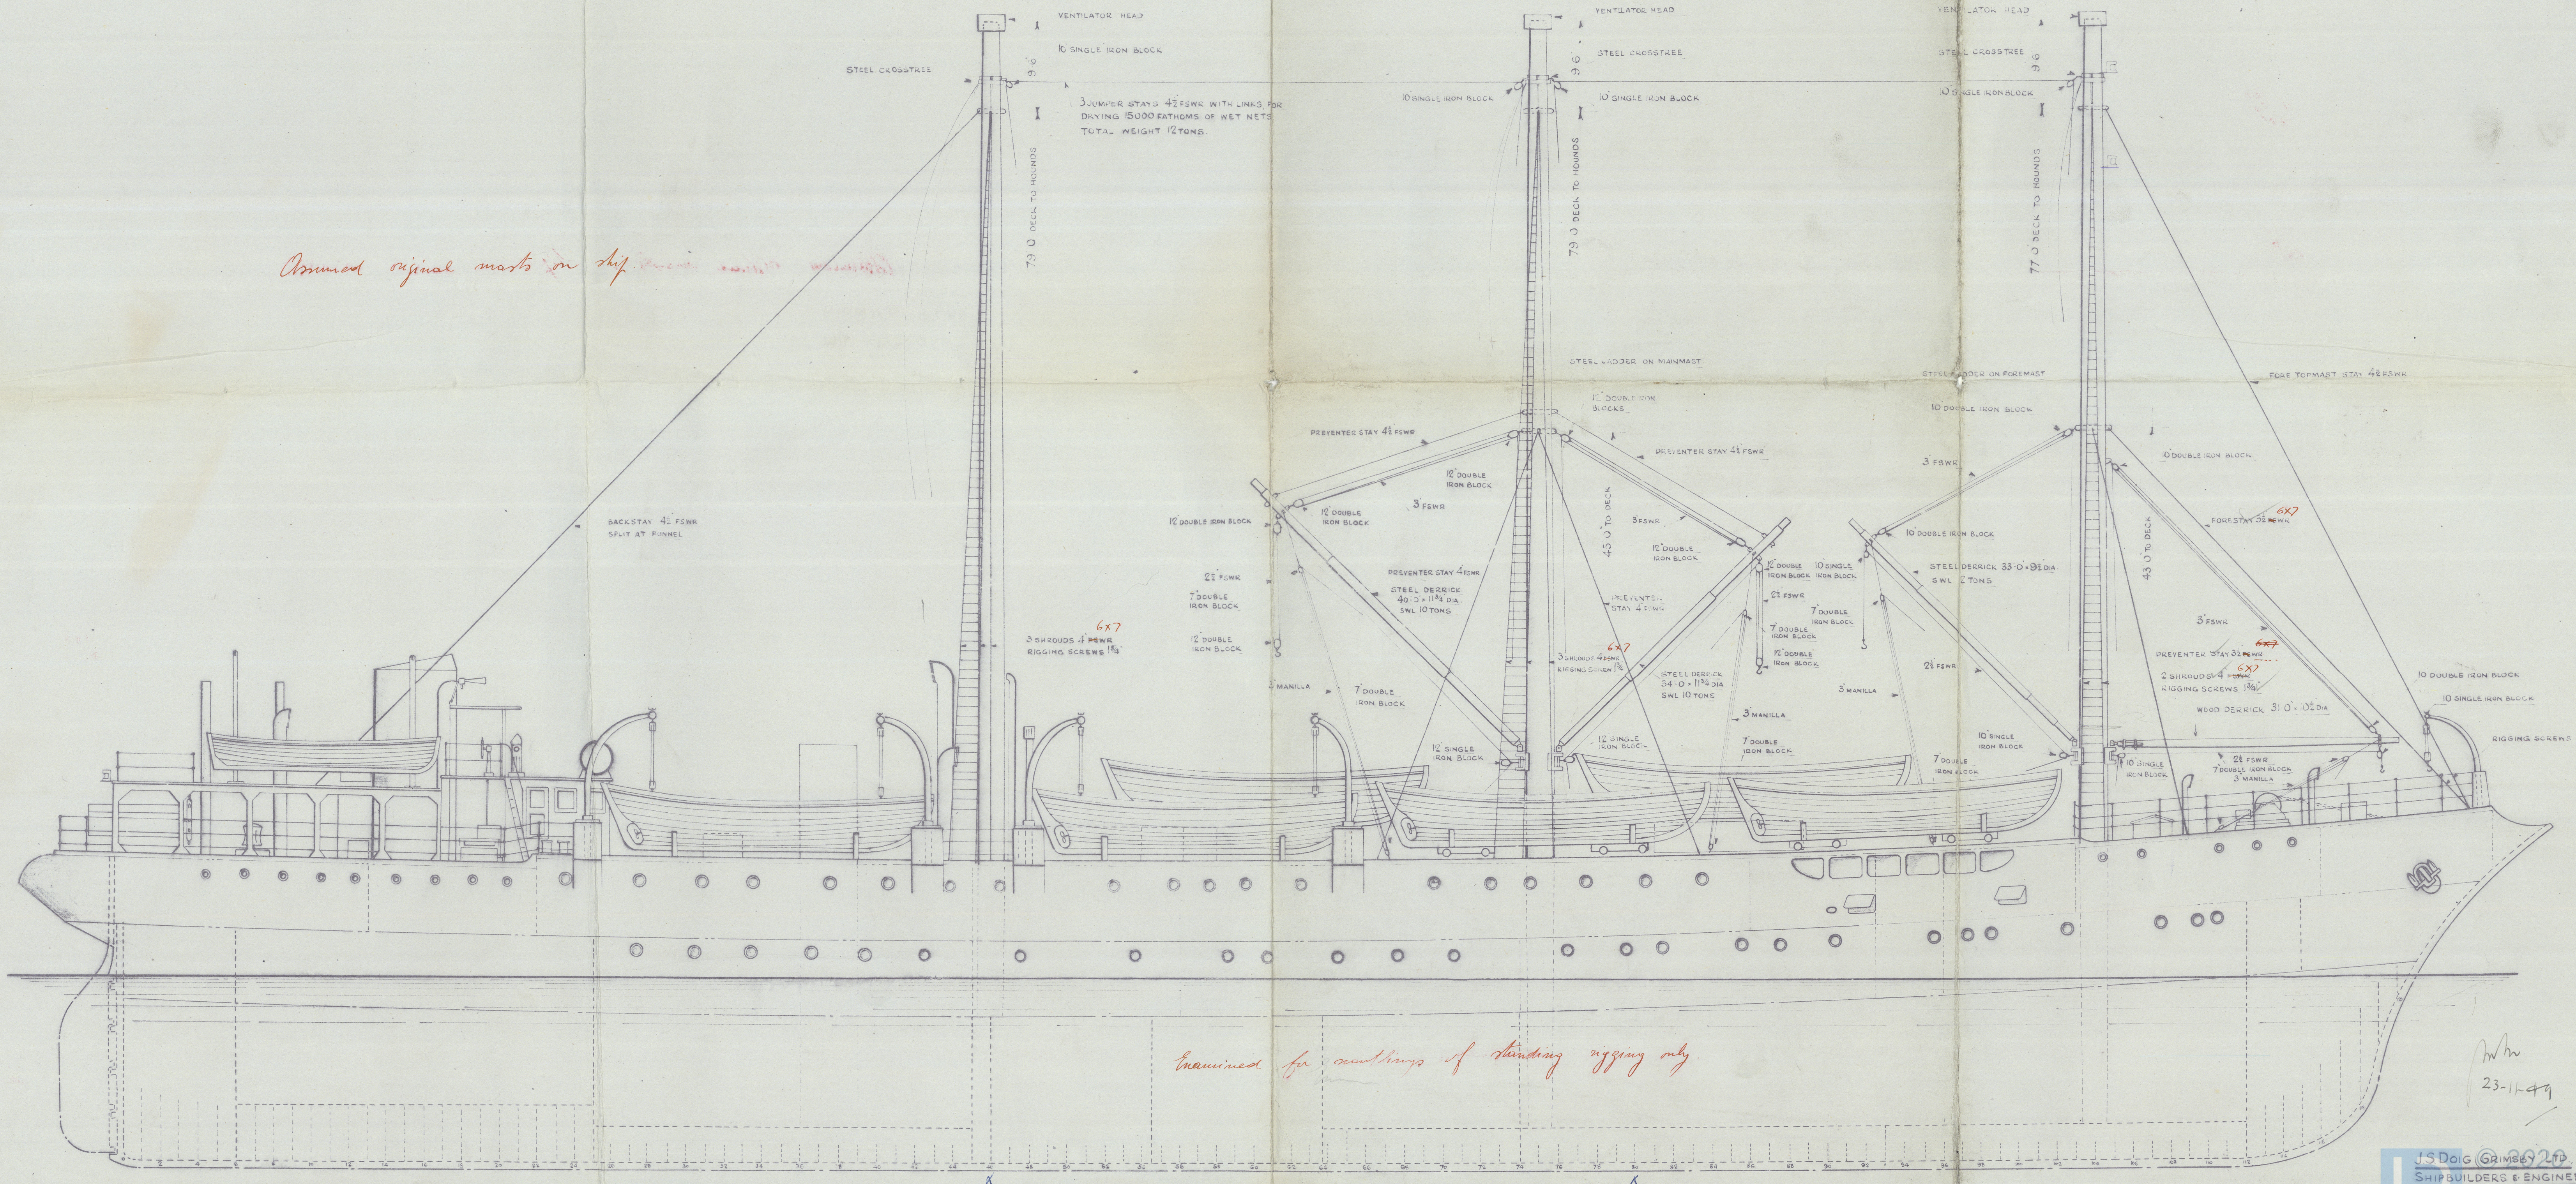

Examined for soundings of standing rigging only.

mm
23-11-49


M/V "BADGER" 

M. African Queen

RIGGING PLAN

GRIMSBY 24353

RECORDS DEPT.,
LONDON

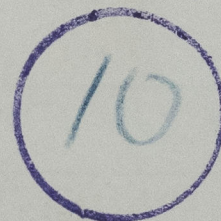

10/10/10

008628-008633-0010



© 2020

Lloyd's Register
Foundation