

OILTANKLIGHTER.

112'-0" X 26'-0" X 8'-3"

SCALE $\frac{1}{4} = 1'-0"$ $\frac{1}{2} = 1'-0"$


MIDSHIP SECTION.

CLASSE : BRITISH CORPORATION


To Class BS & Oil Barge with Oil Carrier
Rivers and Harbours Service

Equipment 2-5/2 cwt. Powers as stock
60 fath. 1 1/8" Cable.


17.0.30

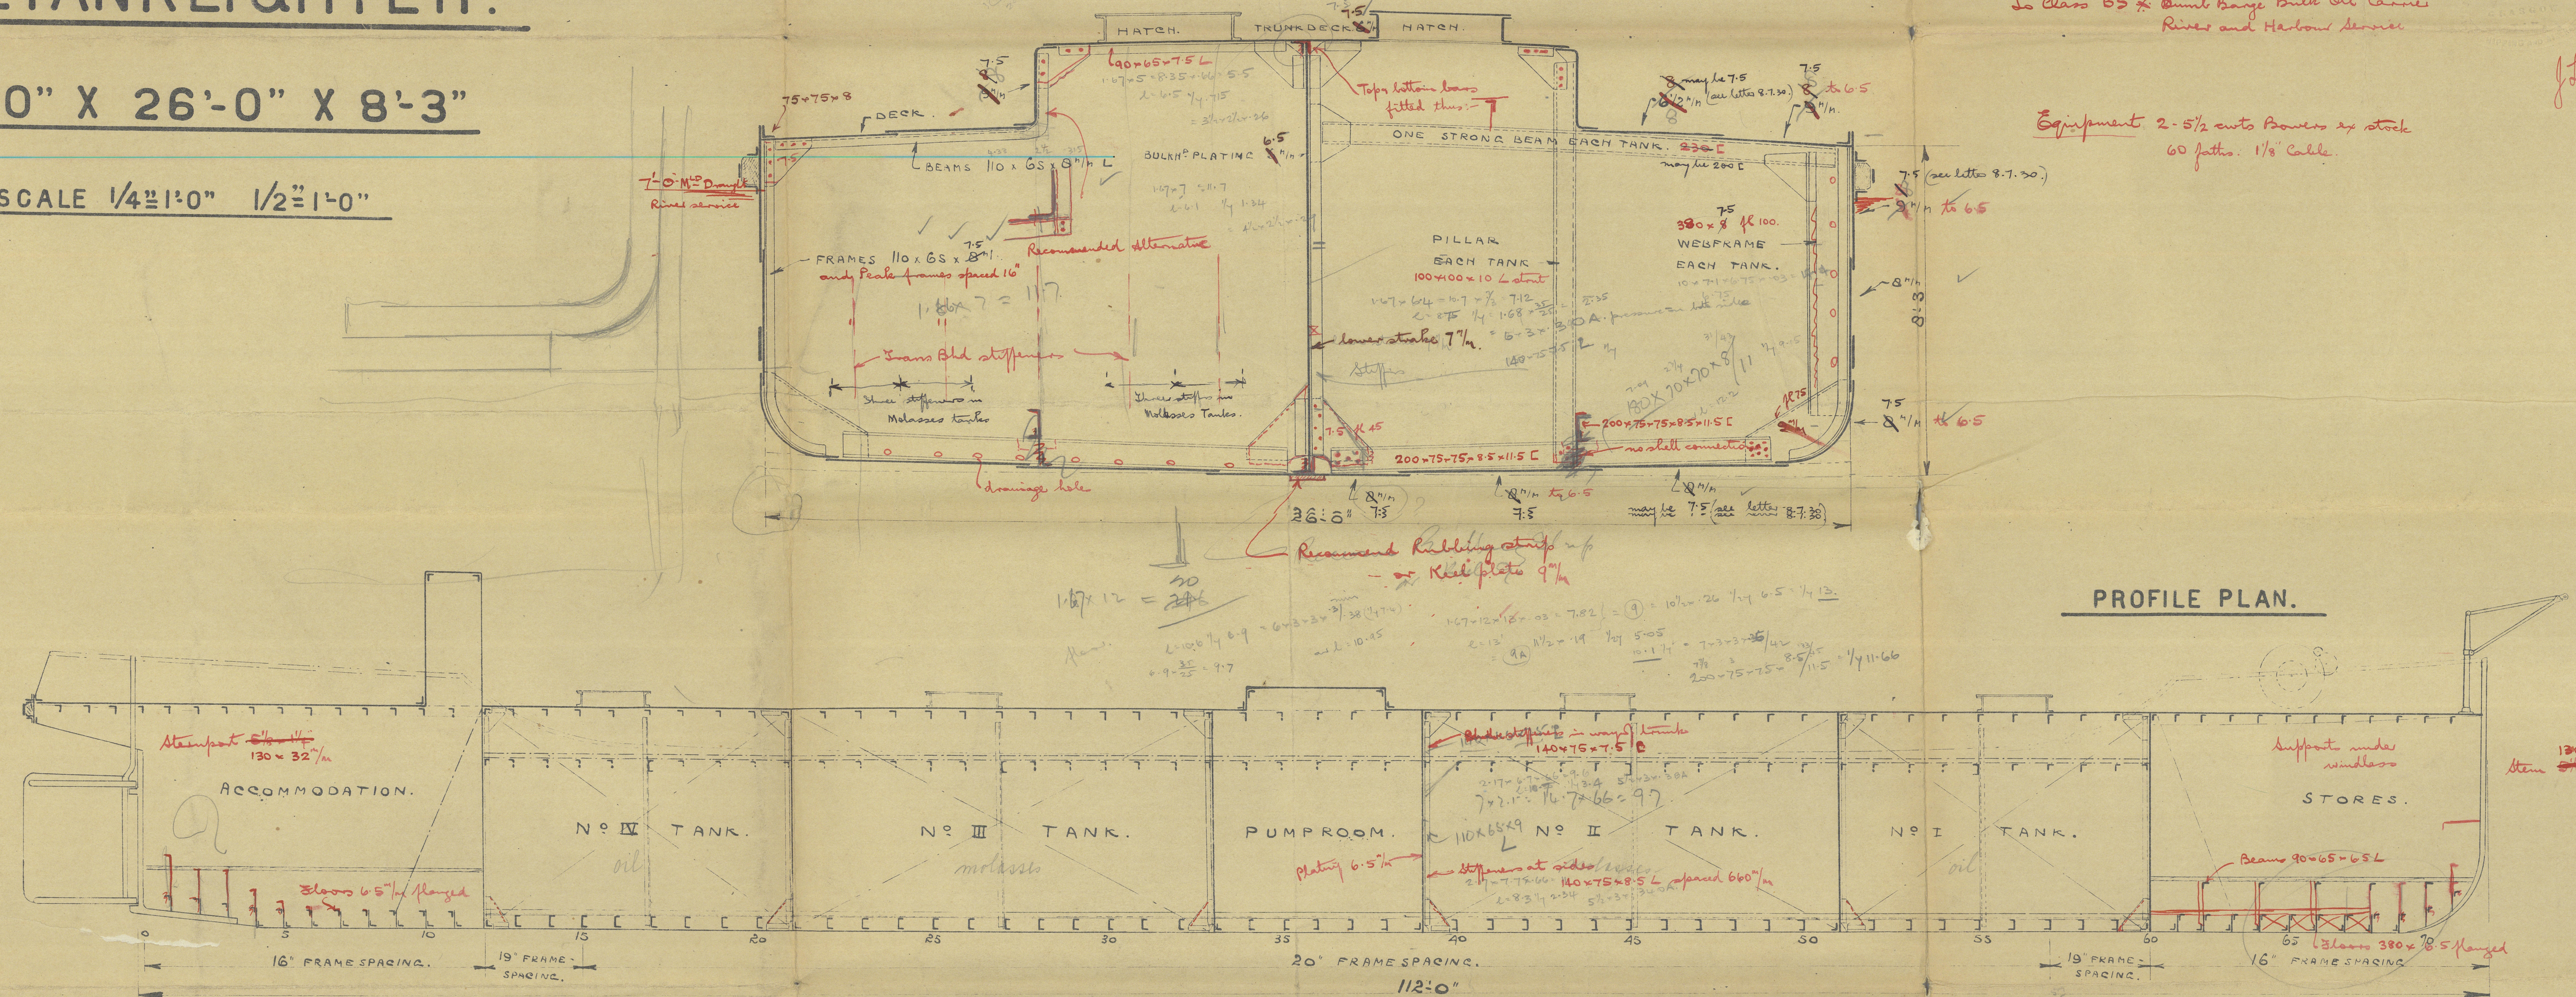

PROFILE PLAN.

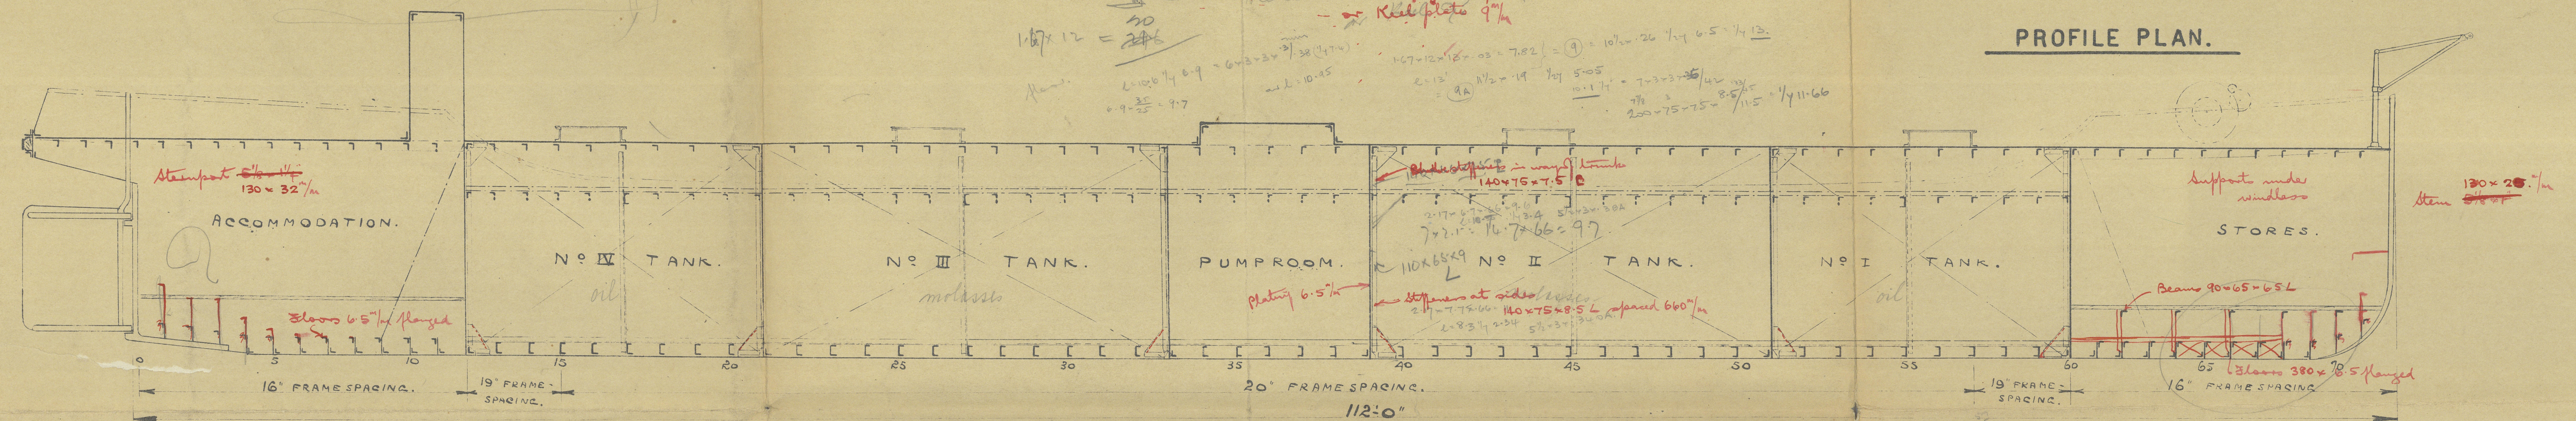

DECKPLAN.

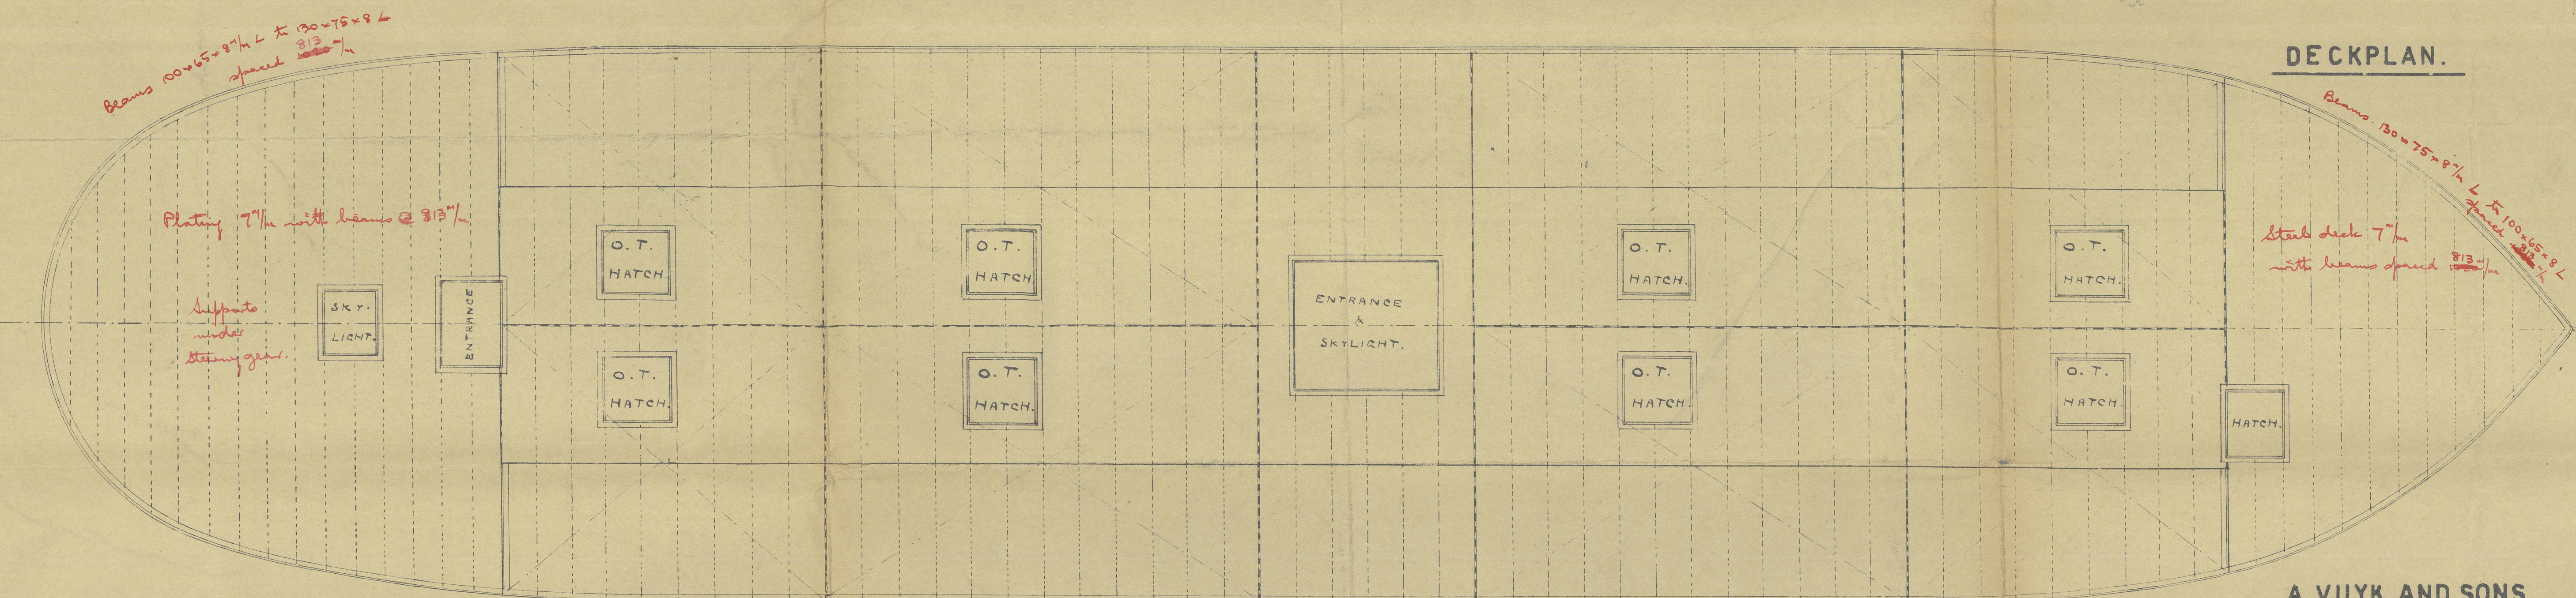

A. VUYK AND SONS.
SHIPBUILDERS.
CAPELLE A.D. YSSEL. HOLLAND.

1623


Section, Profile & Deck.
Rotterdam, Trop. Oil Barge.

112'-0" x 26'-0" x 8'-3"

17-6-30.

now N. Nuyk & Sons N^o 603 to 606.

*JOANX VERITY, NORAH, MARY.

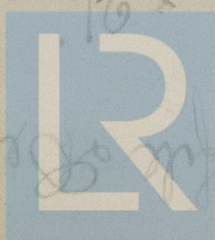

© 2020

Lloyd's Register
Foundation