


11 SEP 1930

30
Approved J. H. per m. l. 2.
12.9.30.

SCALE 3" = 1'-0"

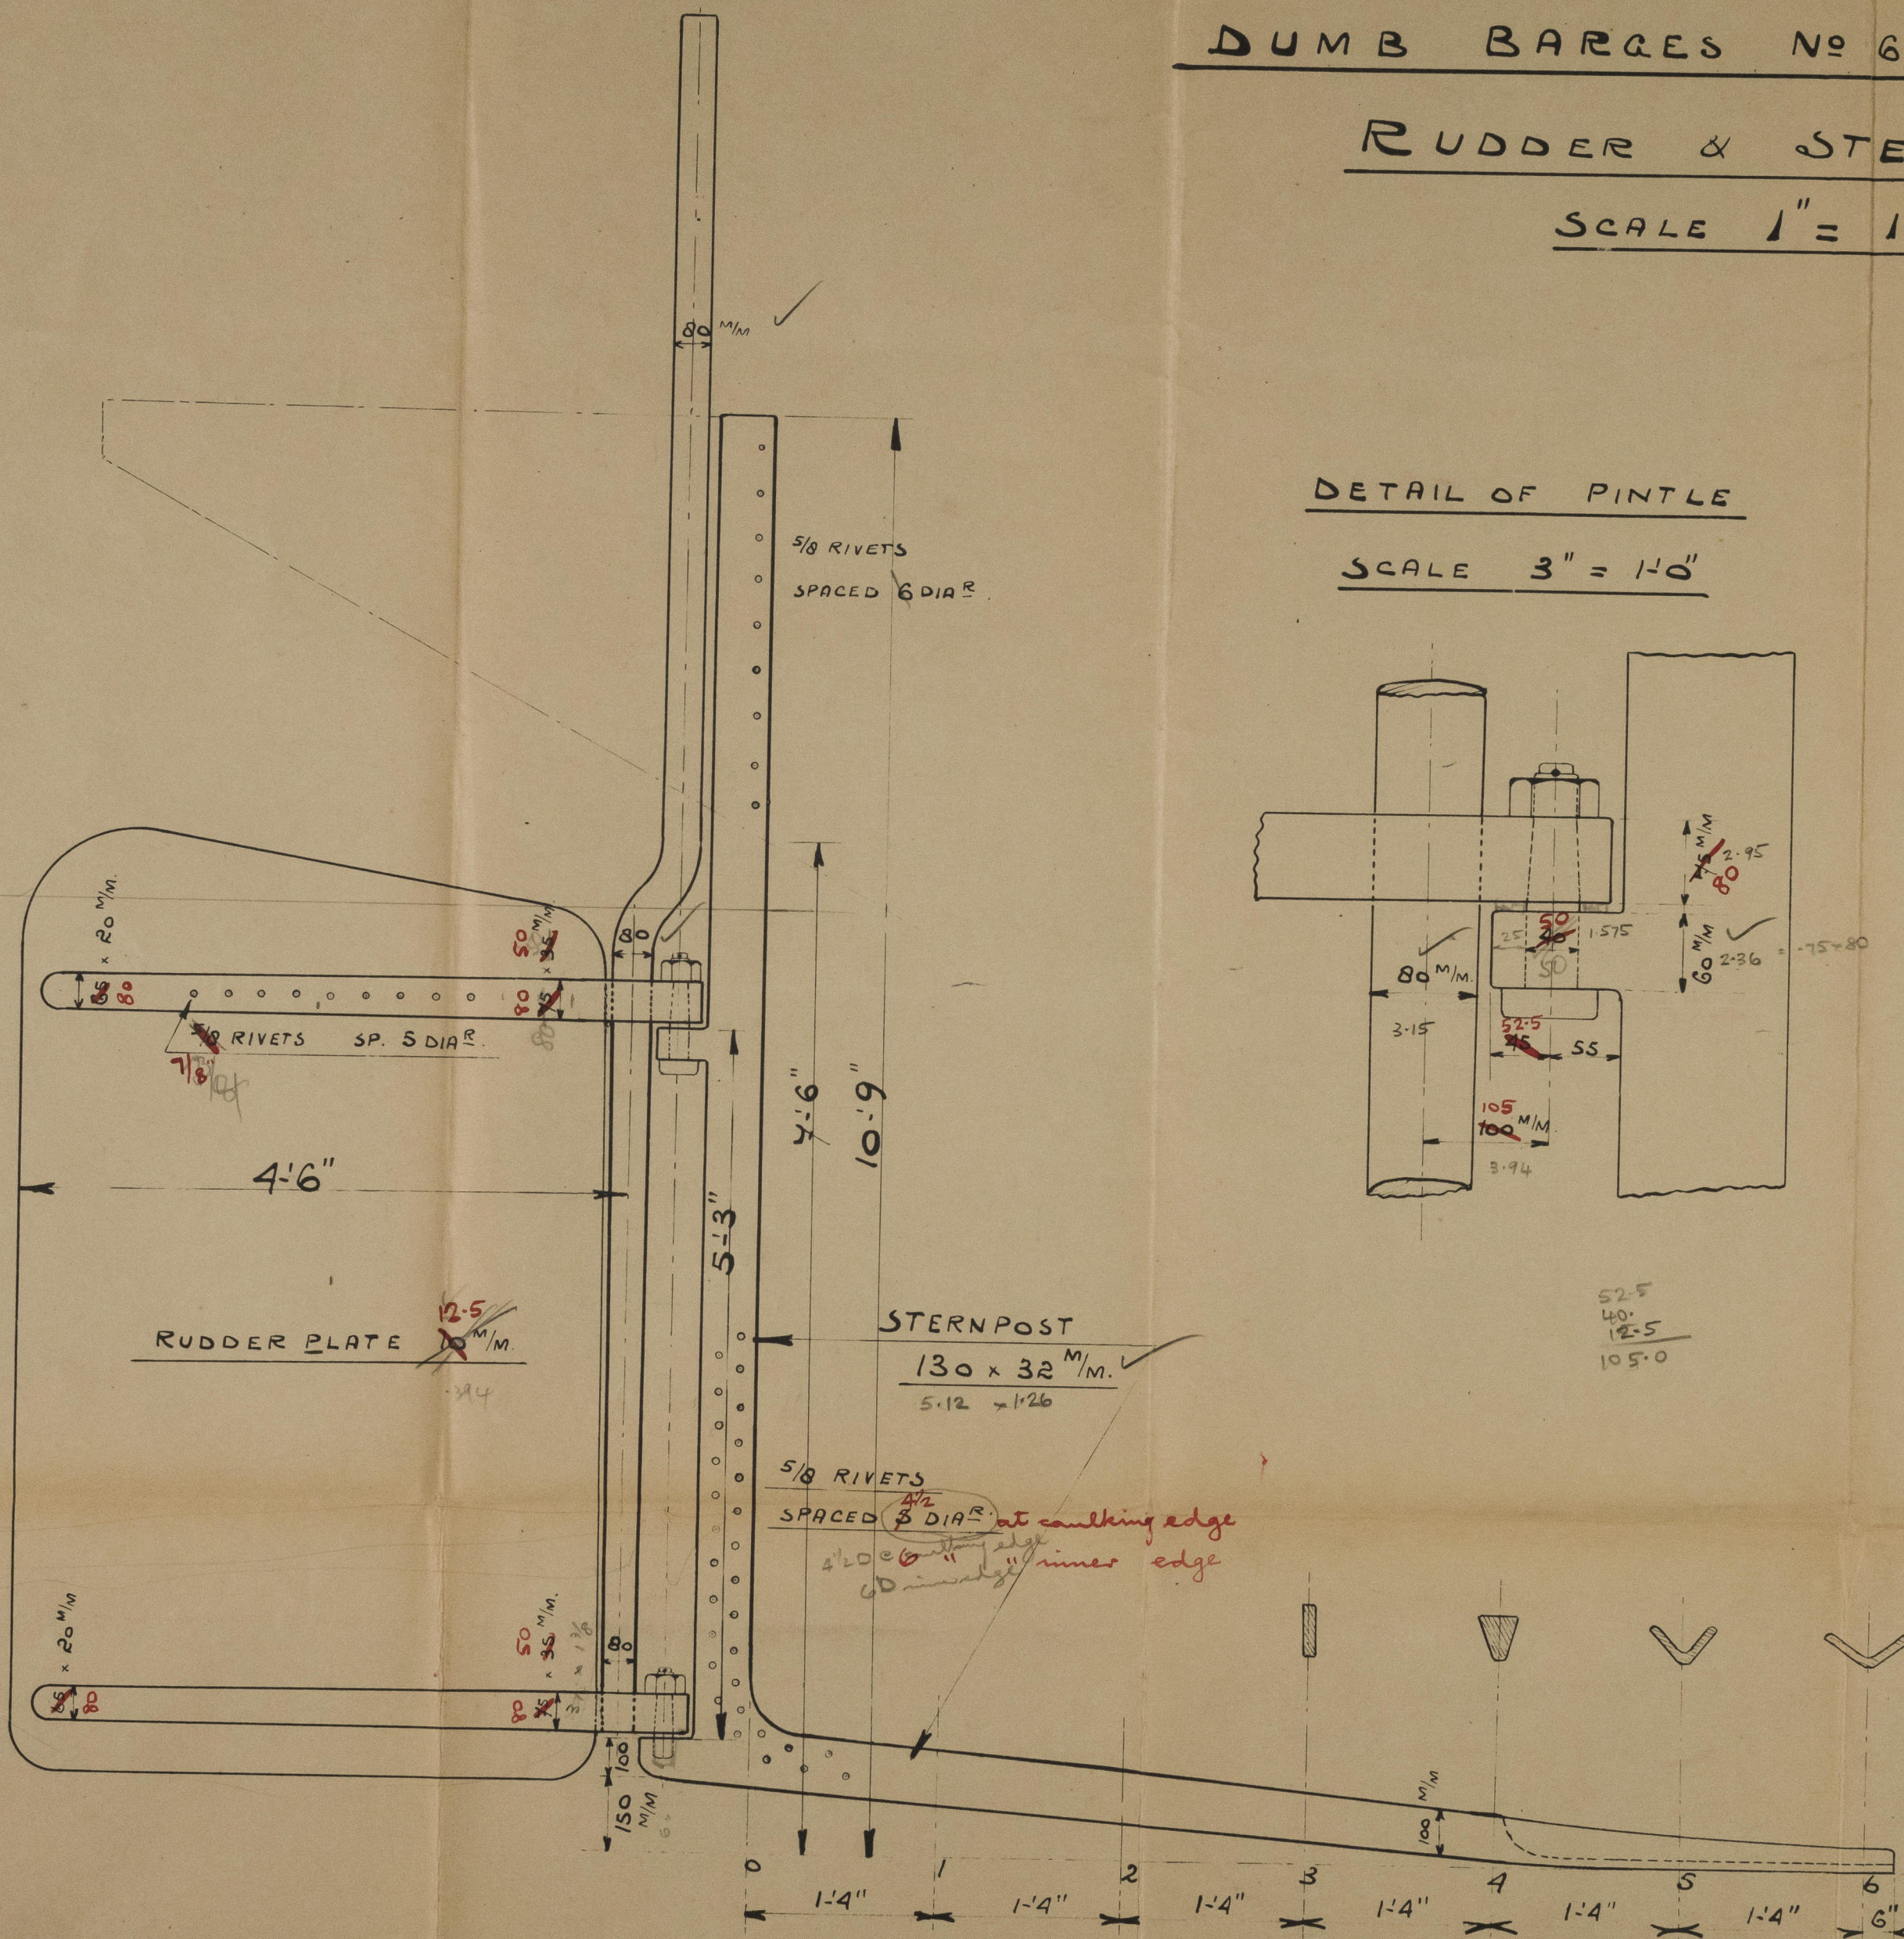

A. TUYK & SONS
SHIPBUILDERS
CAPELLE A/DYSSSEL HOLLAND.

3

Rudder & Sternpost.

A. Hugh & Sons.

N^o 603-H-5-16

12-9-20.

603. JOAN

604. VERITY

605. NORAH.

606. MARY.

008628-008633-0338

bag

A. Hugh & Sons 603-6

Rudder & Sternpost



© 2020

Lloyd's Register
Foundation