




Orientation des cuves N° 3.4.7.8.9.13.14.17.

Cuve en tôle de 5<sup>m/m</sup> partout

(Plating joints electrically welded.)

Echelle 1/50





Marseille le 15 juillet 1936

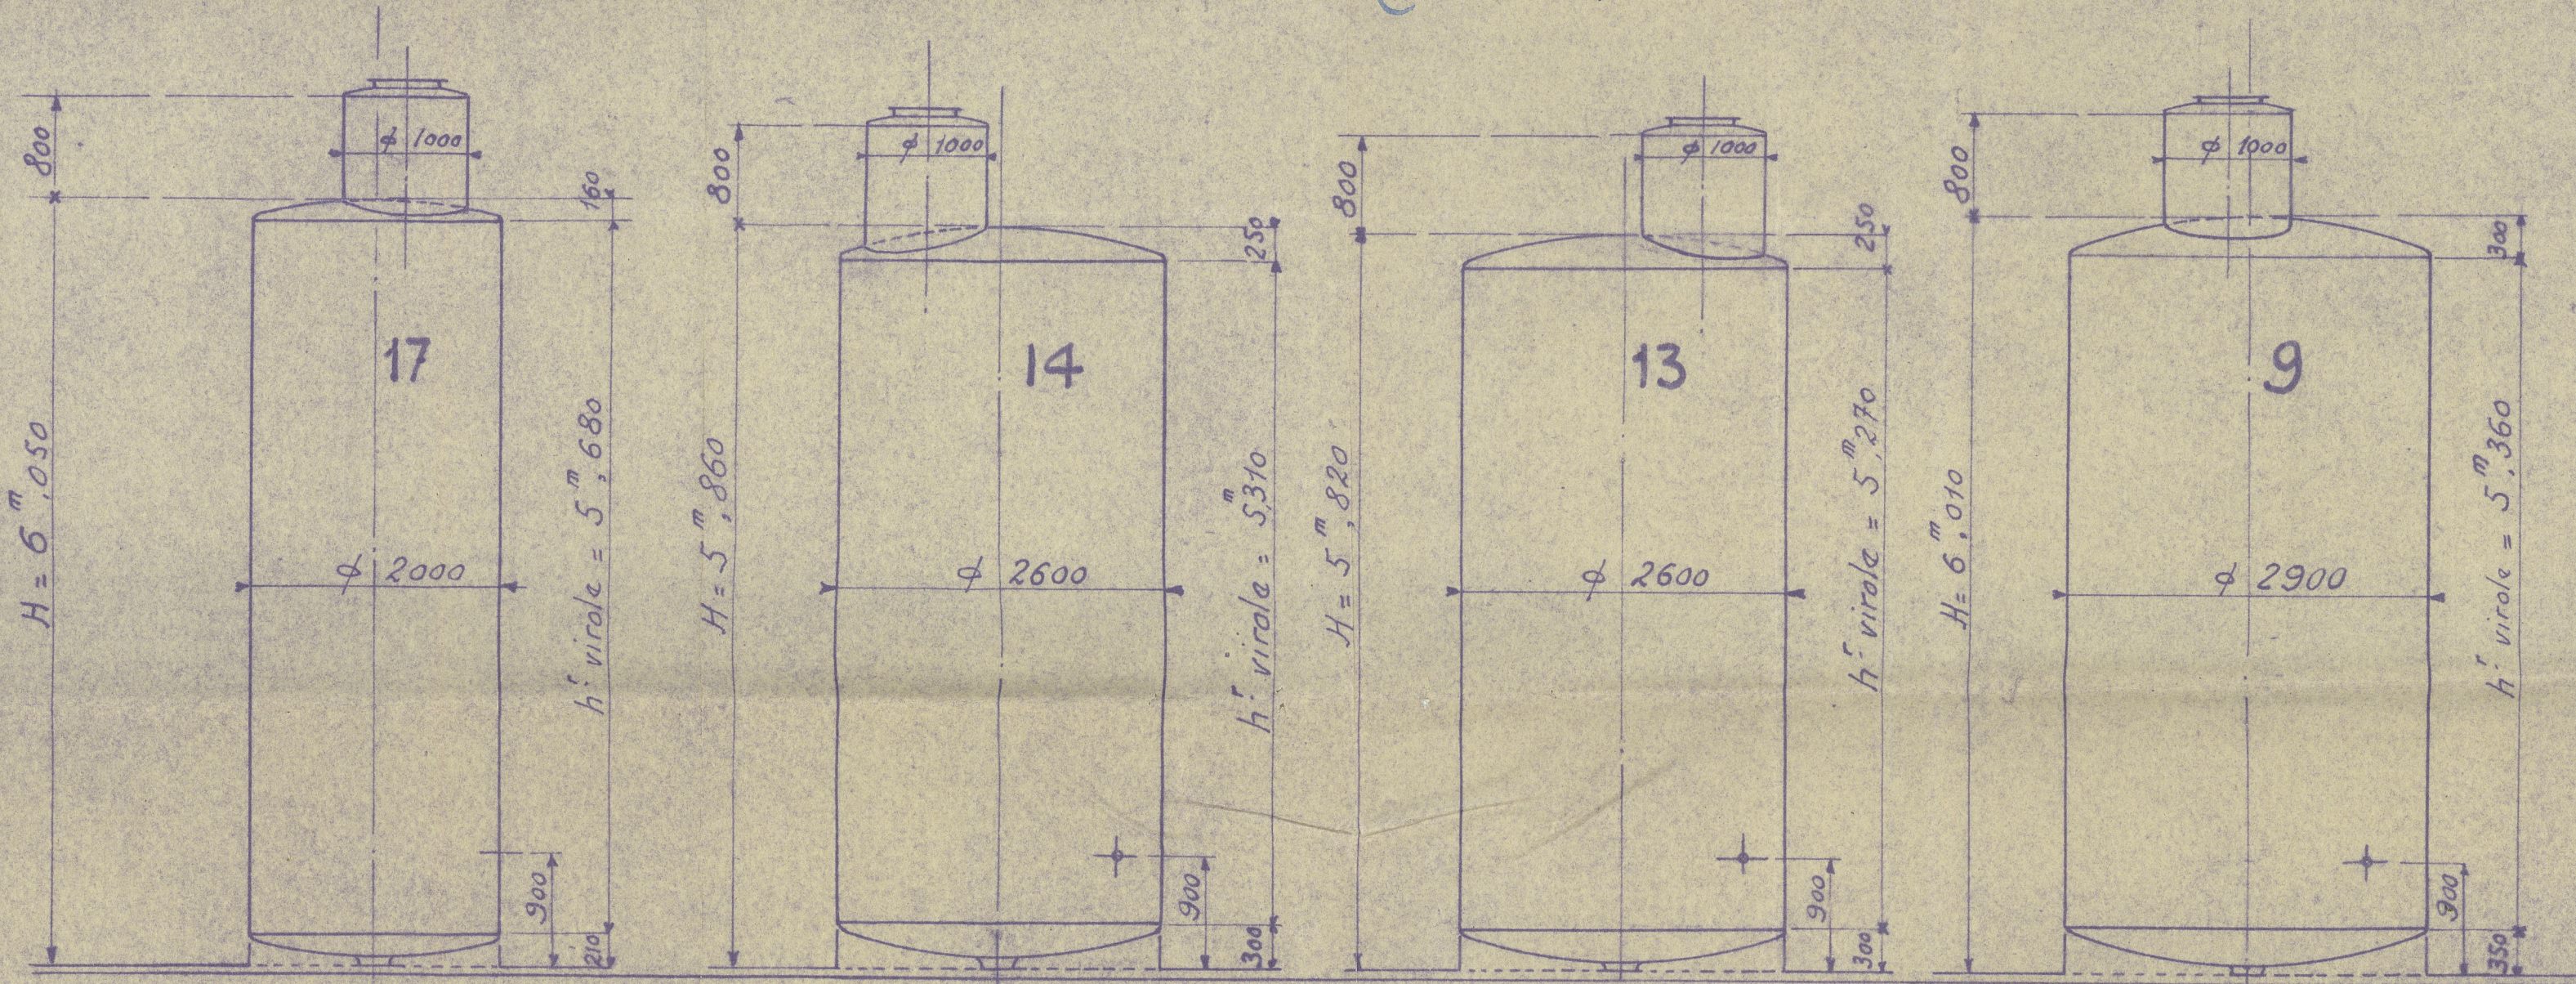

Tanks to be tested to maximum pressure which could be experienced when filling or emptying.

Storage arrangements to Surveyor's satisfaction




Notation Carrying name in Portable tank

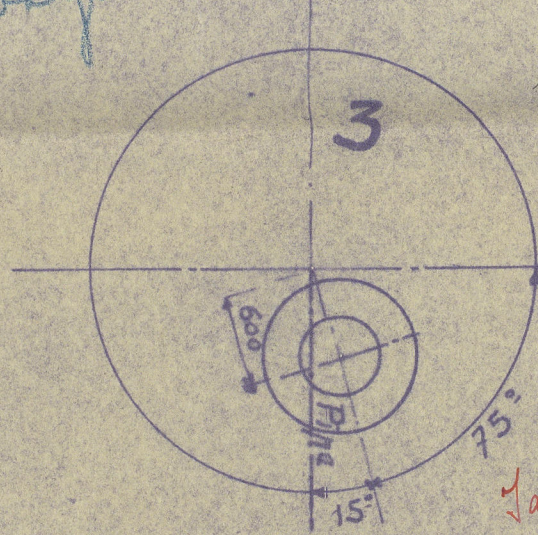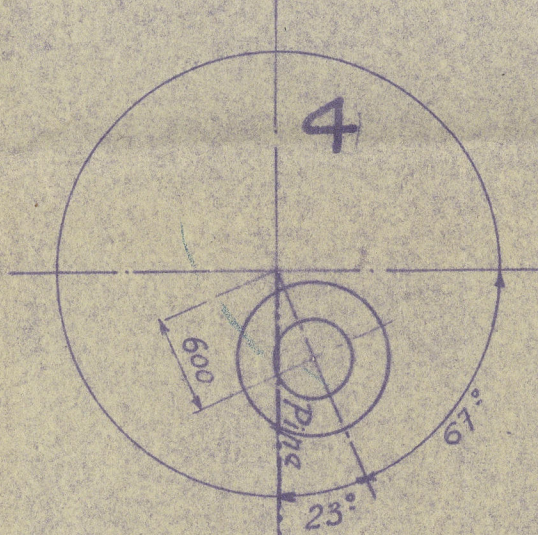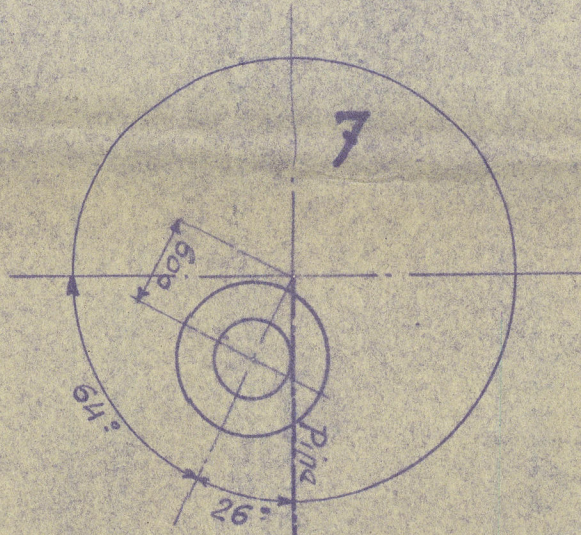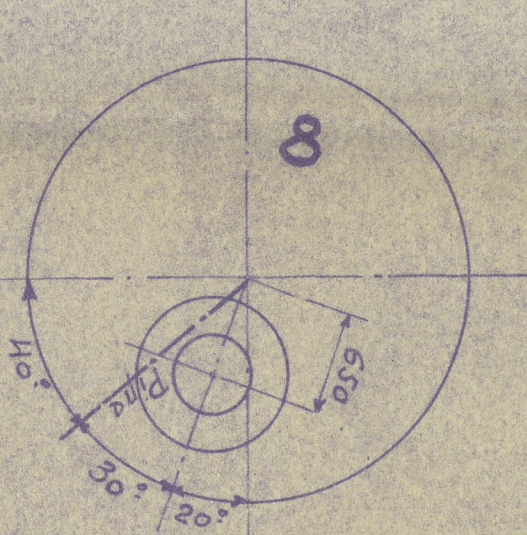









Tanks to be tested to maximum pressure which can be experienced.

Storage arrangements to Surveyor's satisfaction

Notation Carrying name in Portable Tanks.

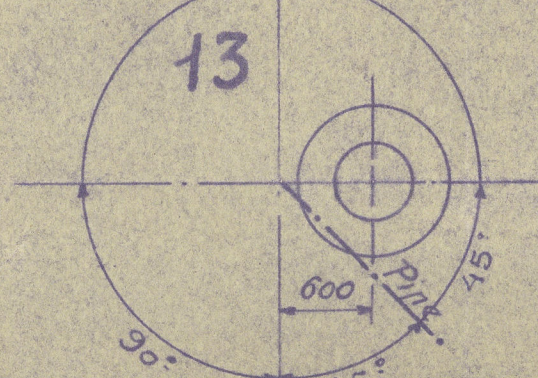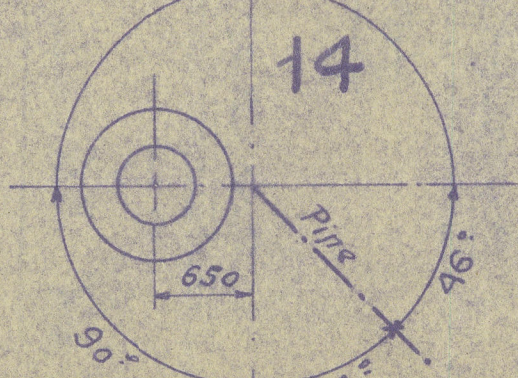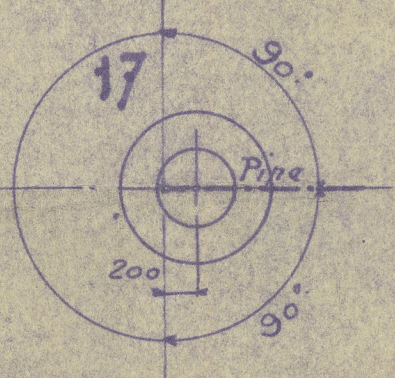

Axe de symétrie

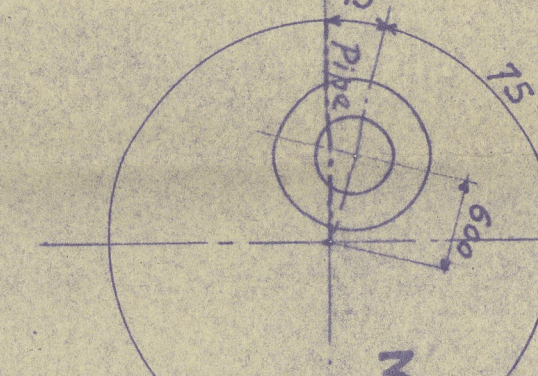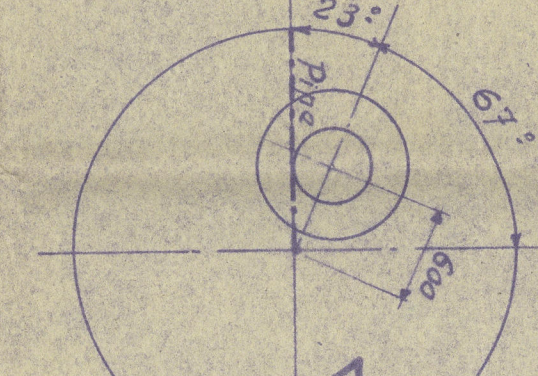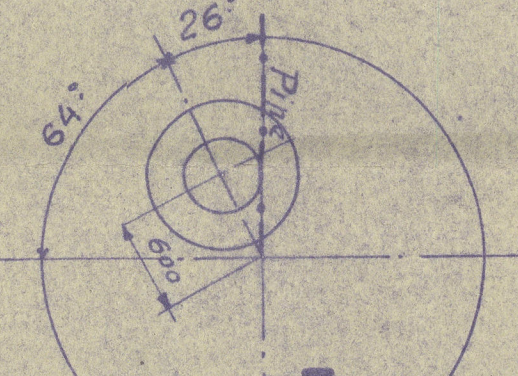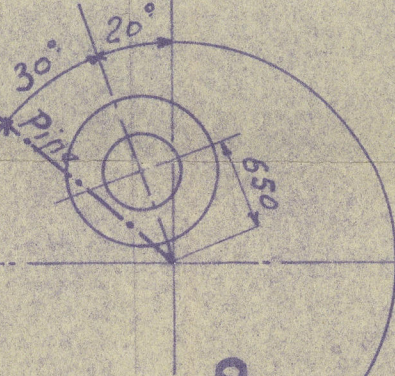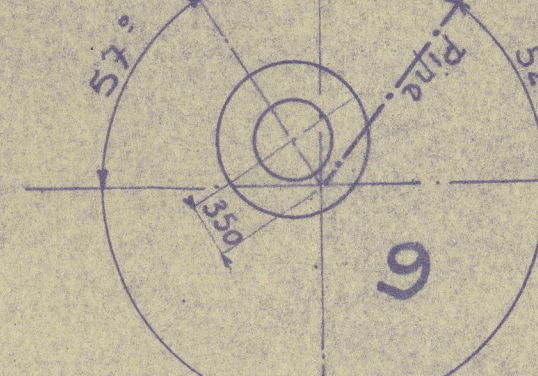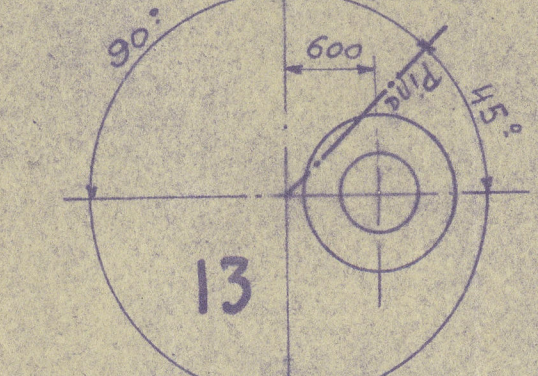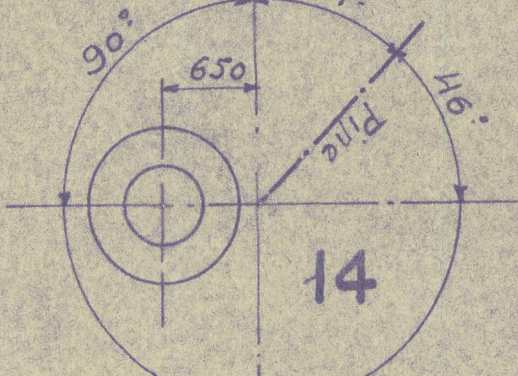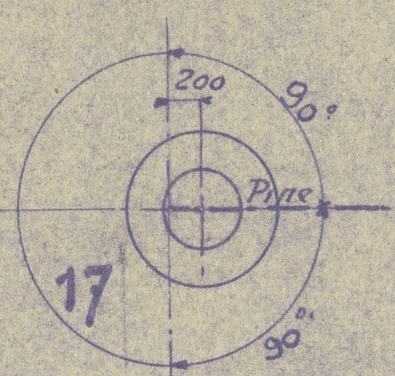




①

Portable Tanks


for

Carrage of wine.

St. Simeon Bernadette.

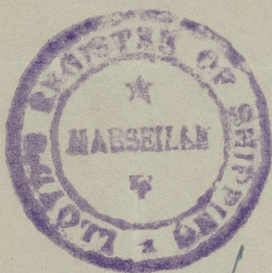

17.7.36.

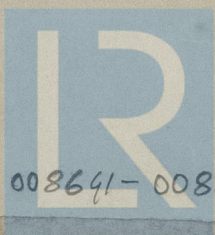

© 2021

Lloyd's Register  
Foundation

008641-008647-0165