


Office

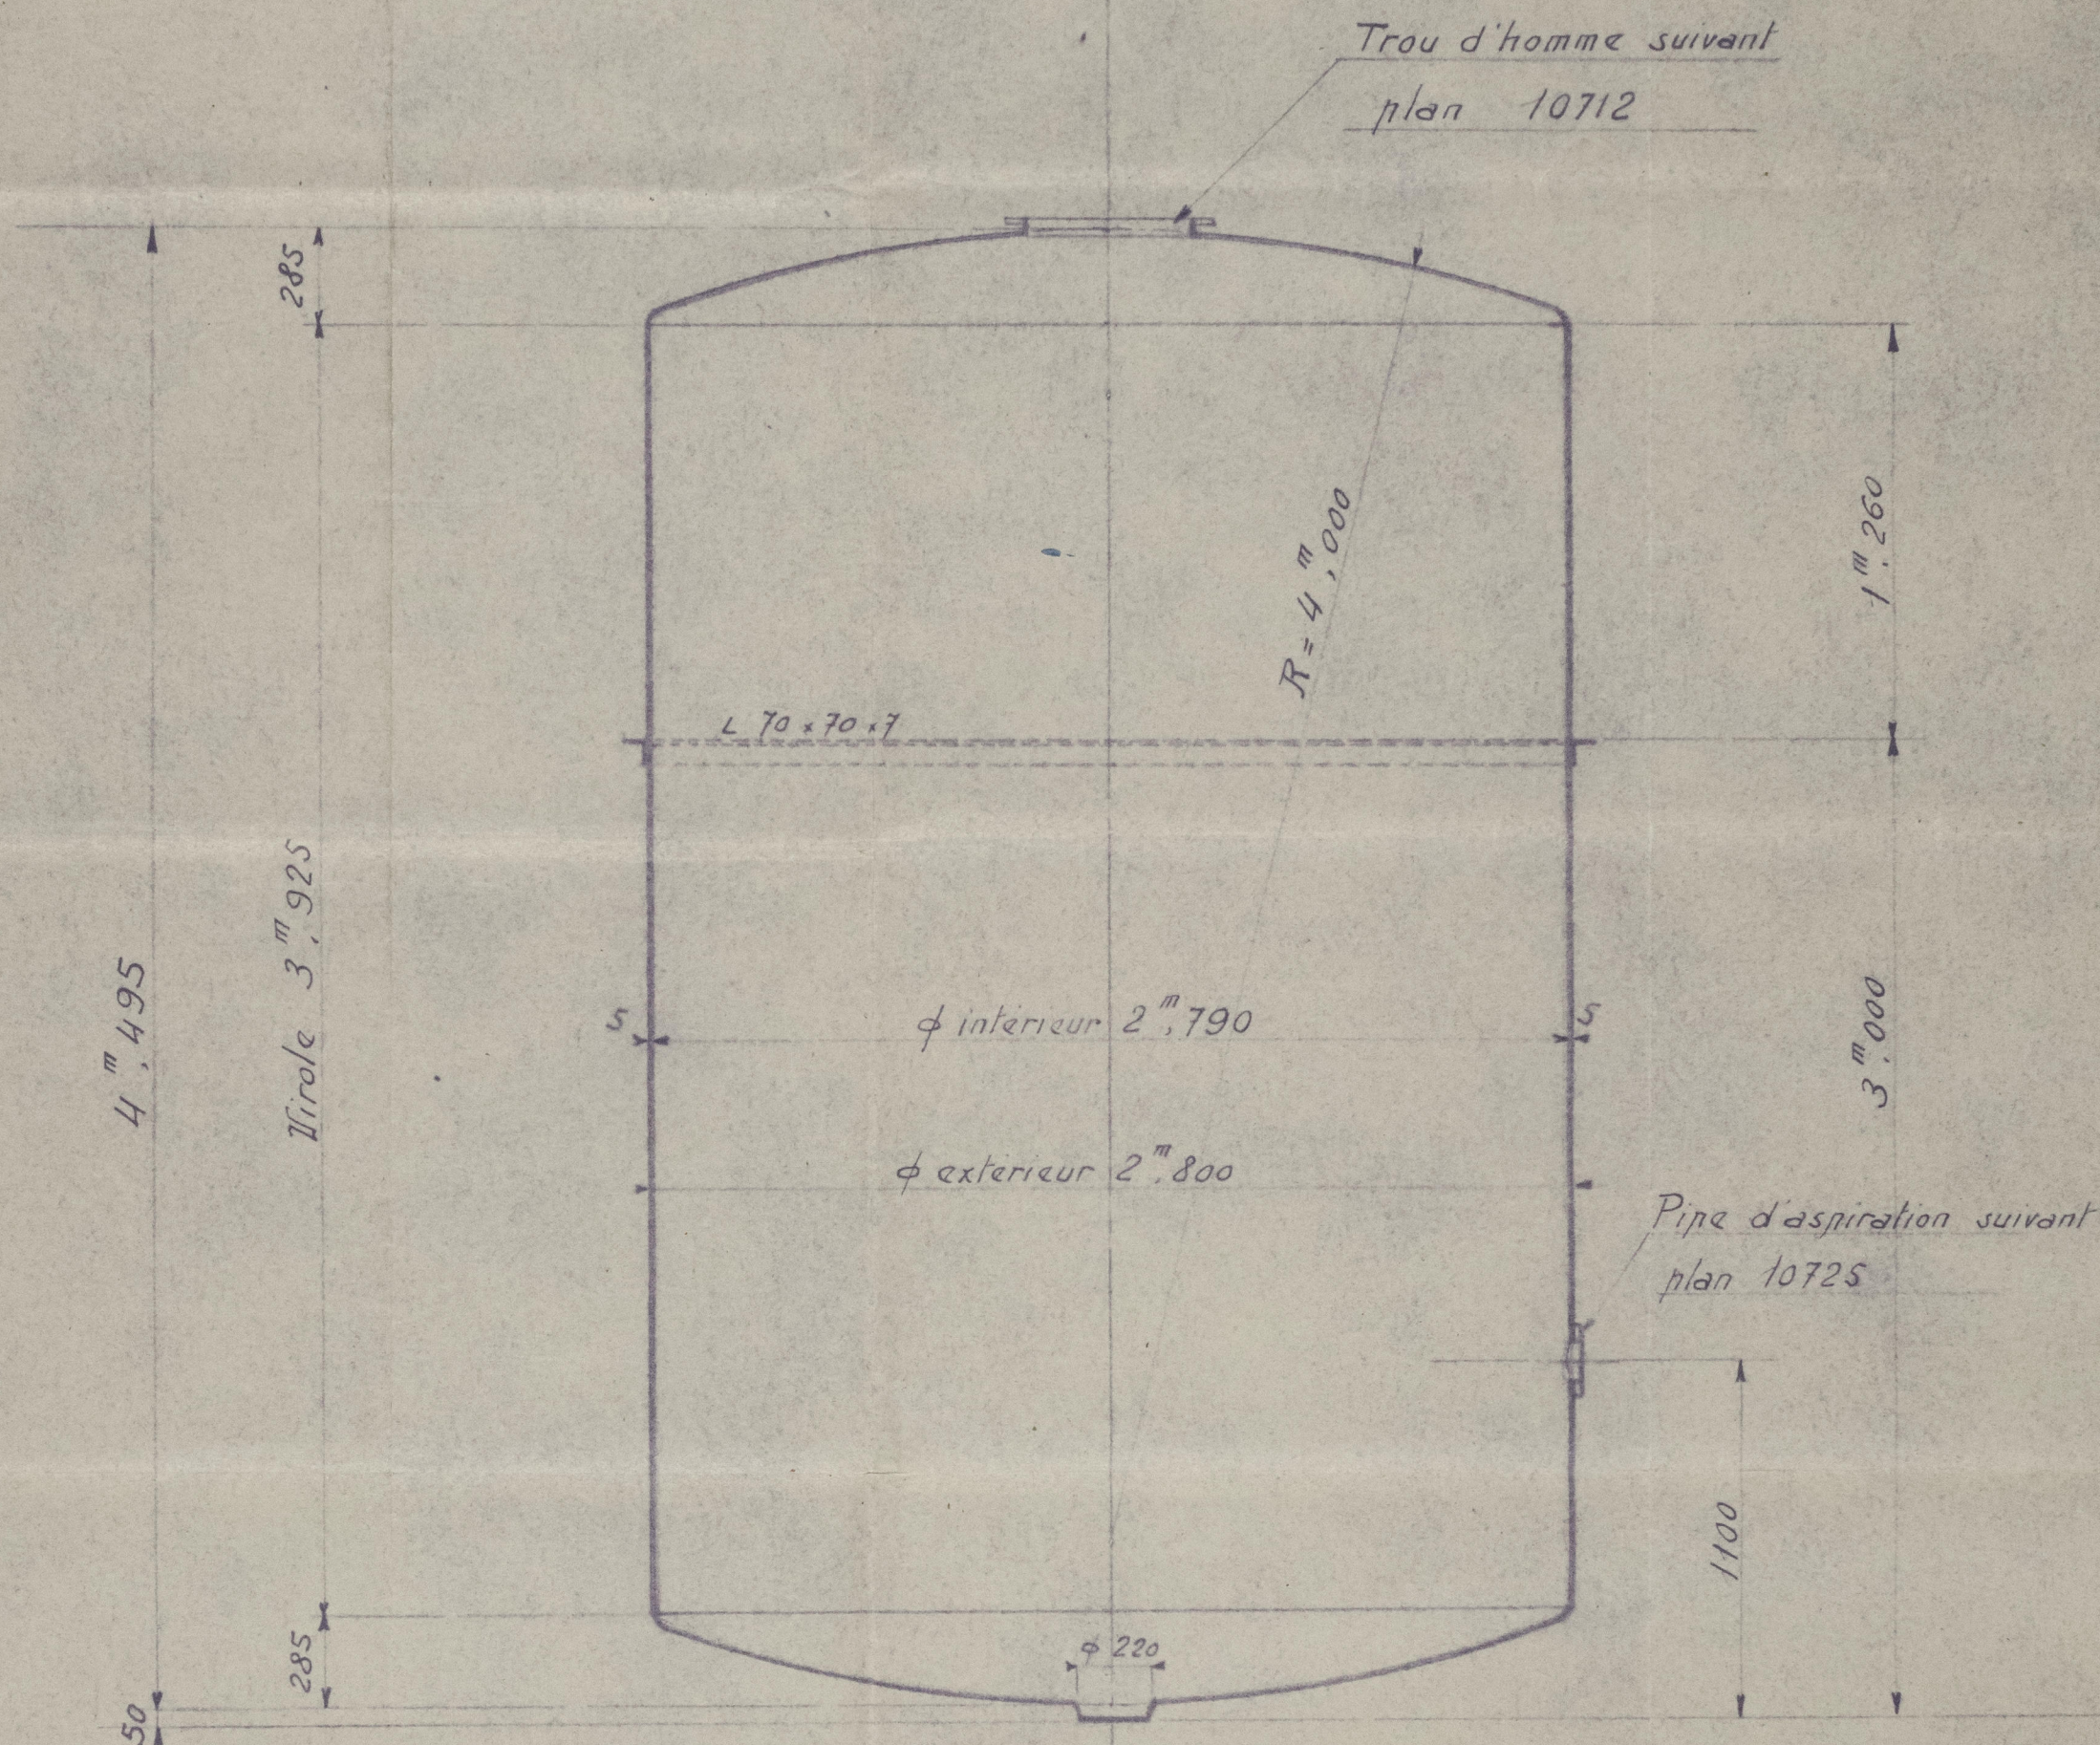

Société des Ateliers TERRIN - Marseille.

S^{te} Tunisienne d'affrètement
et d'armement


SS "S^{te} Bernadette"

4 cuves émaillées de 259 hl.

Echelle $\frac{1}{20}$


Marseille le 7/11/1936

10843

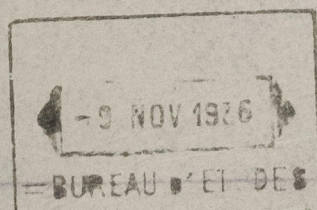

Tanks to be tested to maximum pressure
which can be experienced in service.

Storage arrangements to surveyor's satisfaction

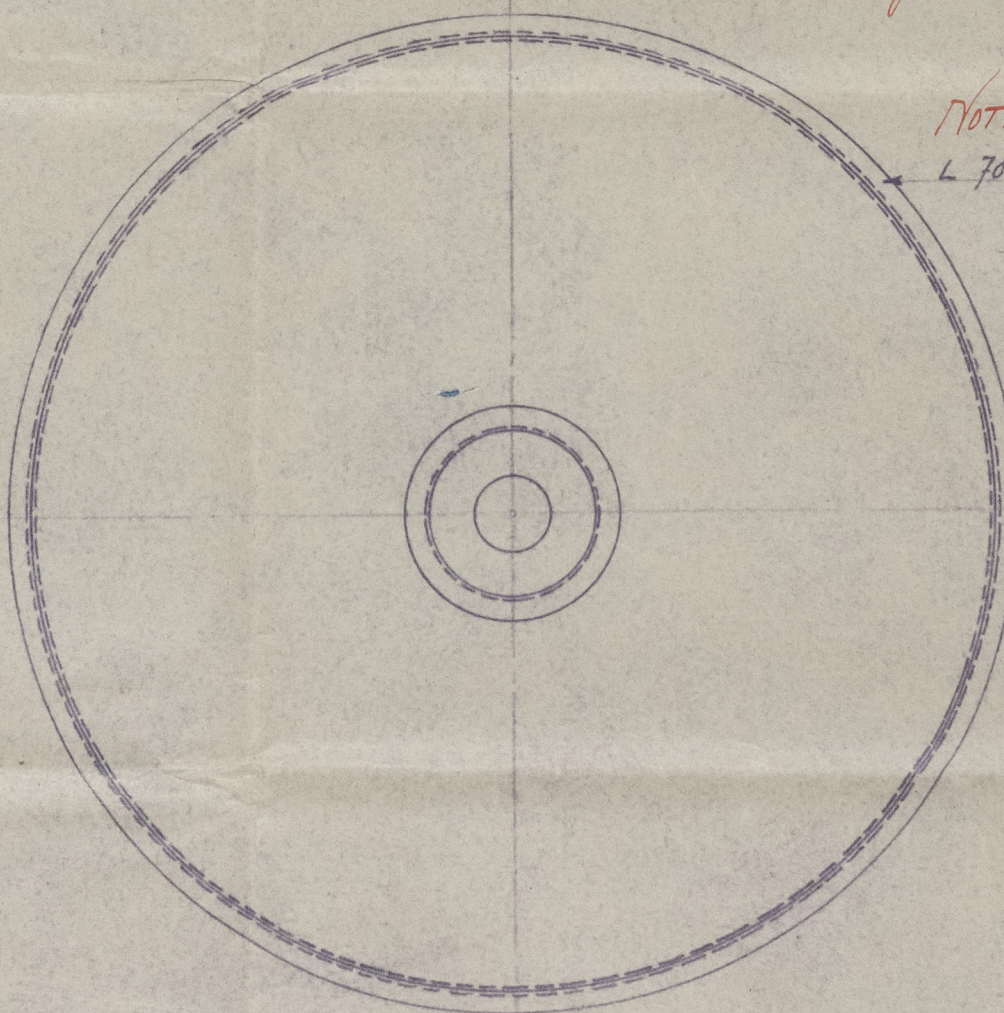

NOTATION: - Carrying wire in portable tanks
L 70 x 70 x 7 Soudure
discontinue.



27/11/36

Lloyd's Register
Foundation

008641-008647-0167

Portable tank
for


Carriage of wine.

(On deck.)

H. Saint Germaine.



27.11.36.

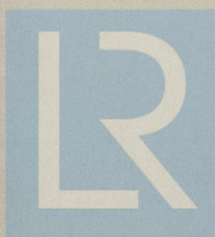

© 2021

Lloyd's Register
Foundation

008641-008647-0167