

S/S " S A I N T E   B E R N A D E T T E " .

Report No.1641.

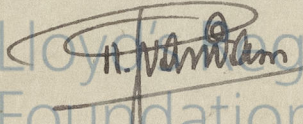
Thicknesses of plating in decimals of an inch ascertained by drilling.

KE.	<u>Amidships.</u>			<u>Forward.</u>			<u>Aft.</u>	
	Port.	Star'd.		Port.	Star'd.		Port.	Star'd.
D. Sheer strake	.48	.46	J.	-	-		.47	.47
ECK Sheer Strake	.54	.53	H.	.35	.34		.36	.35
STRAKE below	.40	.40	G.	.35	.34		.34	.33
" "	.40	.40	F.	.35	.35		.35	.34
" "	.39	.39	E.	.34	.35		.34	.34
BILGE "	.39	.39	D.	.35	.35		.33	.33
" "	.40	.40	C.	.35	.35		.35	.35
" "	.41	.40	B.	.35	.35		.35	.34
" "	.40	.40	A.	.35	.34		.35	.35
KEEL	.50	.50		.46	.45		.45	.45
FOC'LE Sides	-	-		.27	.27		-	-



© 2021

ALGIERS, 8th March, 1946.


  
H. J. van der Ham
   
Lloyd's Register
   
Foundation

008641 - 008647 - 209