



30.7.06

Load stated to be 2 tons
 $19 \times 2 \times 14 = 268$
 $\frac{268}{268} = 1.5 \text{ cwt/ft.}$
27

Full, Tween Decks
 $\frac{268 \times 6.5}{50} = 35 \text{ tons}$

SS N° 31

ADDITIONAL TWEENDECKS

FOR 28 AFT


SCALE 1/100

25/7/06

3895

RMS

Forecastle lengthened 1100 wms. July 1948
See Stockholm Rpt No 6960 and approved plan.

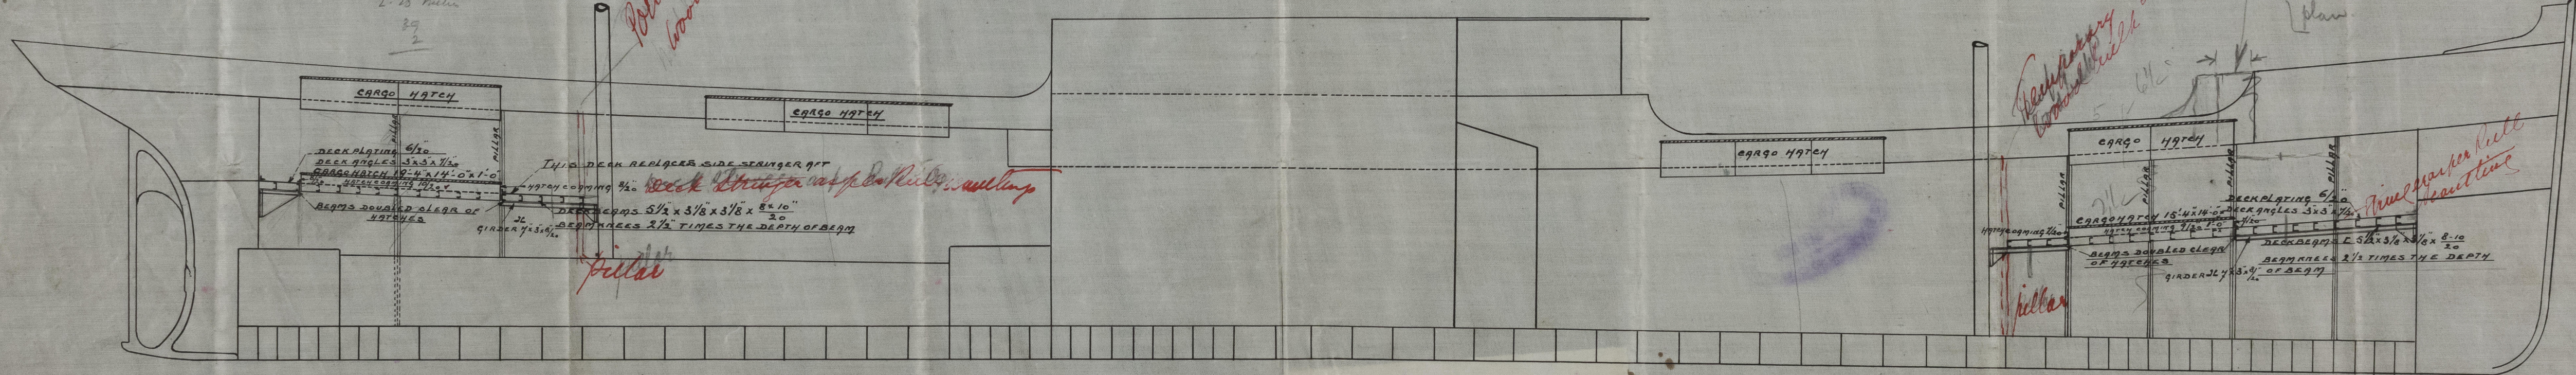

30.7.06



© 2021

Lloyd's Register
Foundation

008648-008555-00