


S. S. N^o 398

= SCALE $\frac{1}{8}$ = ONE FOOT

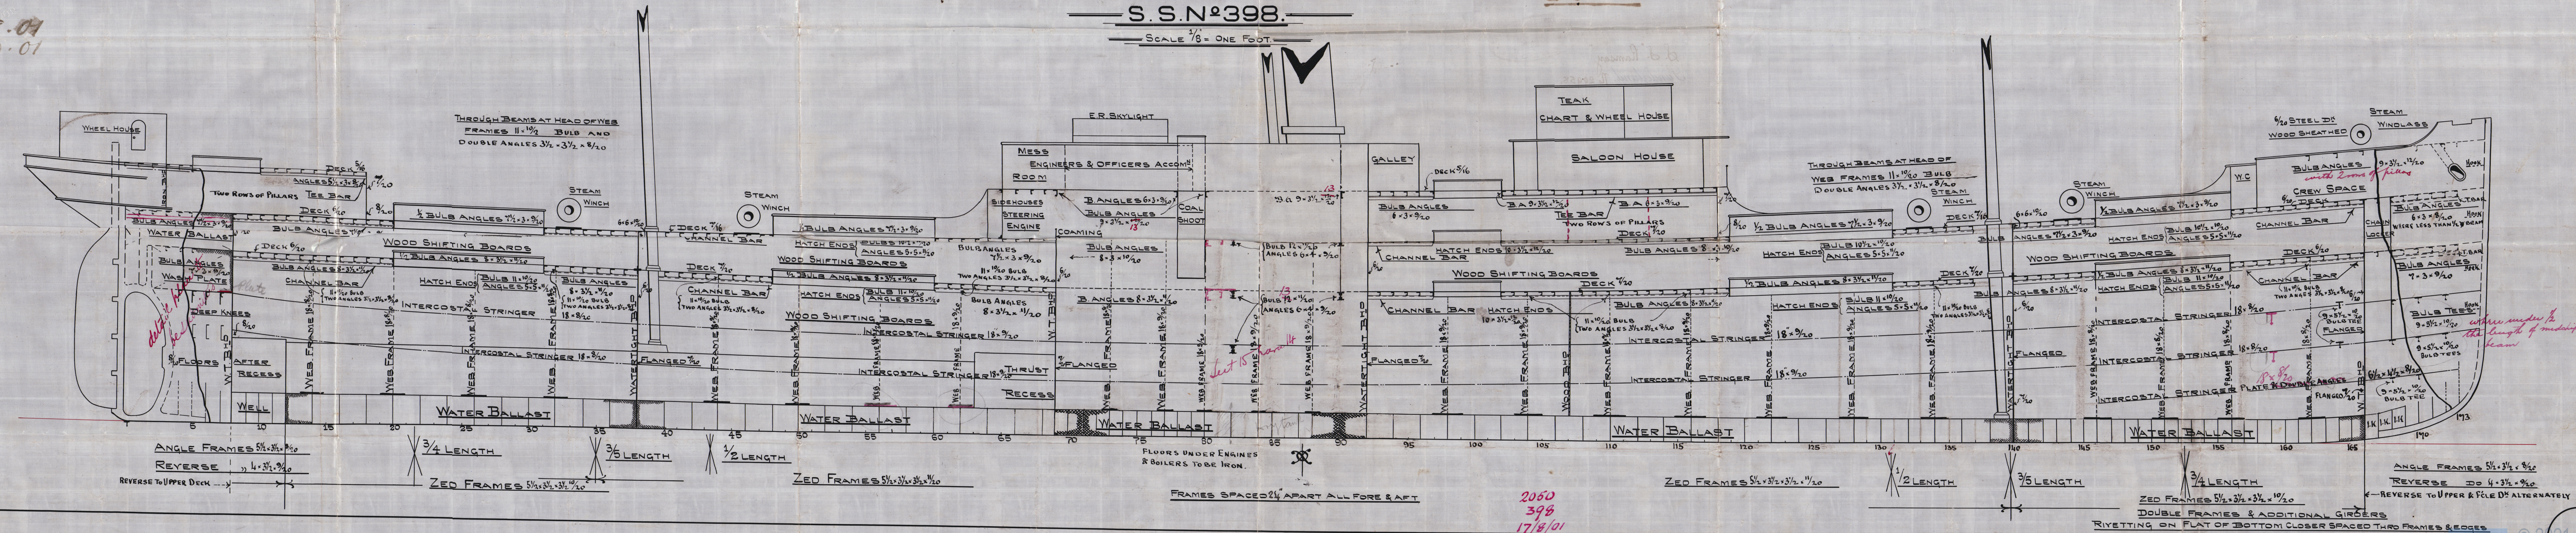

PROFILE

J. L. Thompson & Co^o

Nº 398

S. S. Ramsay
Sunderland. No 20958.