

# VESSELS N<sup>os</sup> 894-5-6.

## FLY SHOWING REVISED LONGITUDINAL PROFILE &

## CONSTRUCTIONAL DECKS.

SCALE 1/8 IN. TO ONE FOOT.




18.9.22


The British Corporation  
Glasgow  
14<sup>th</sup> Sept 1922

Approved. Agt J.L.H. (M)


### PART PROFILE

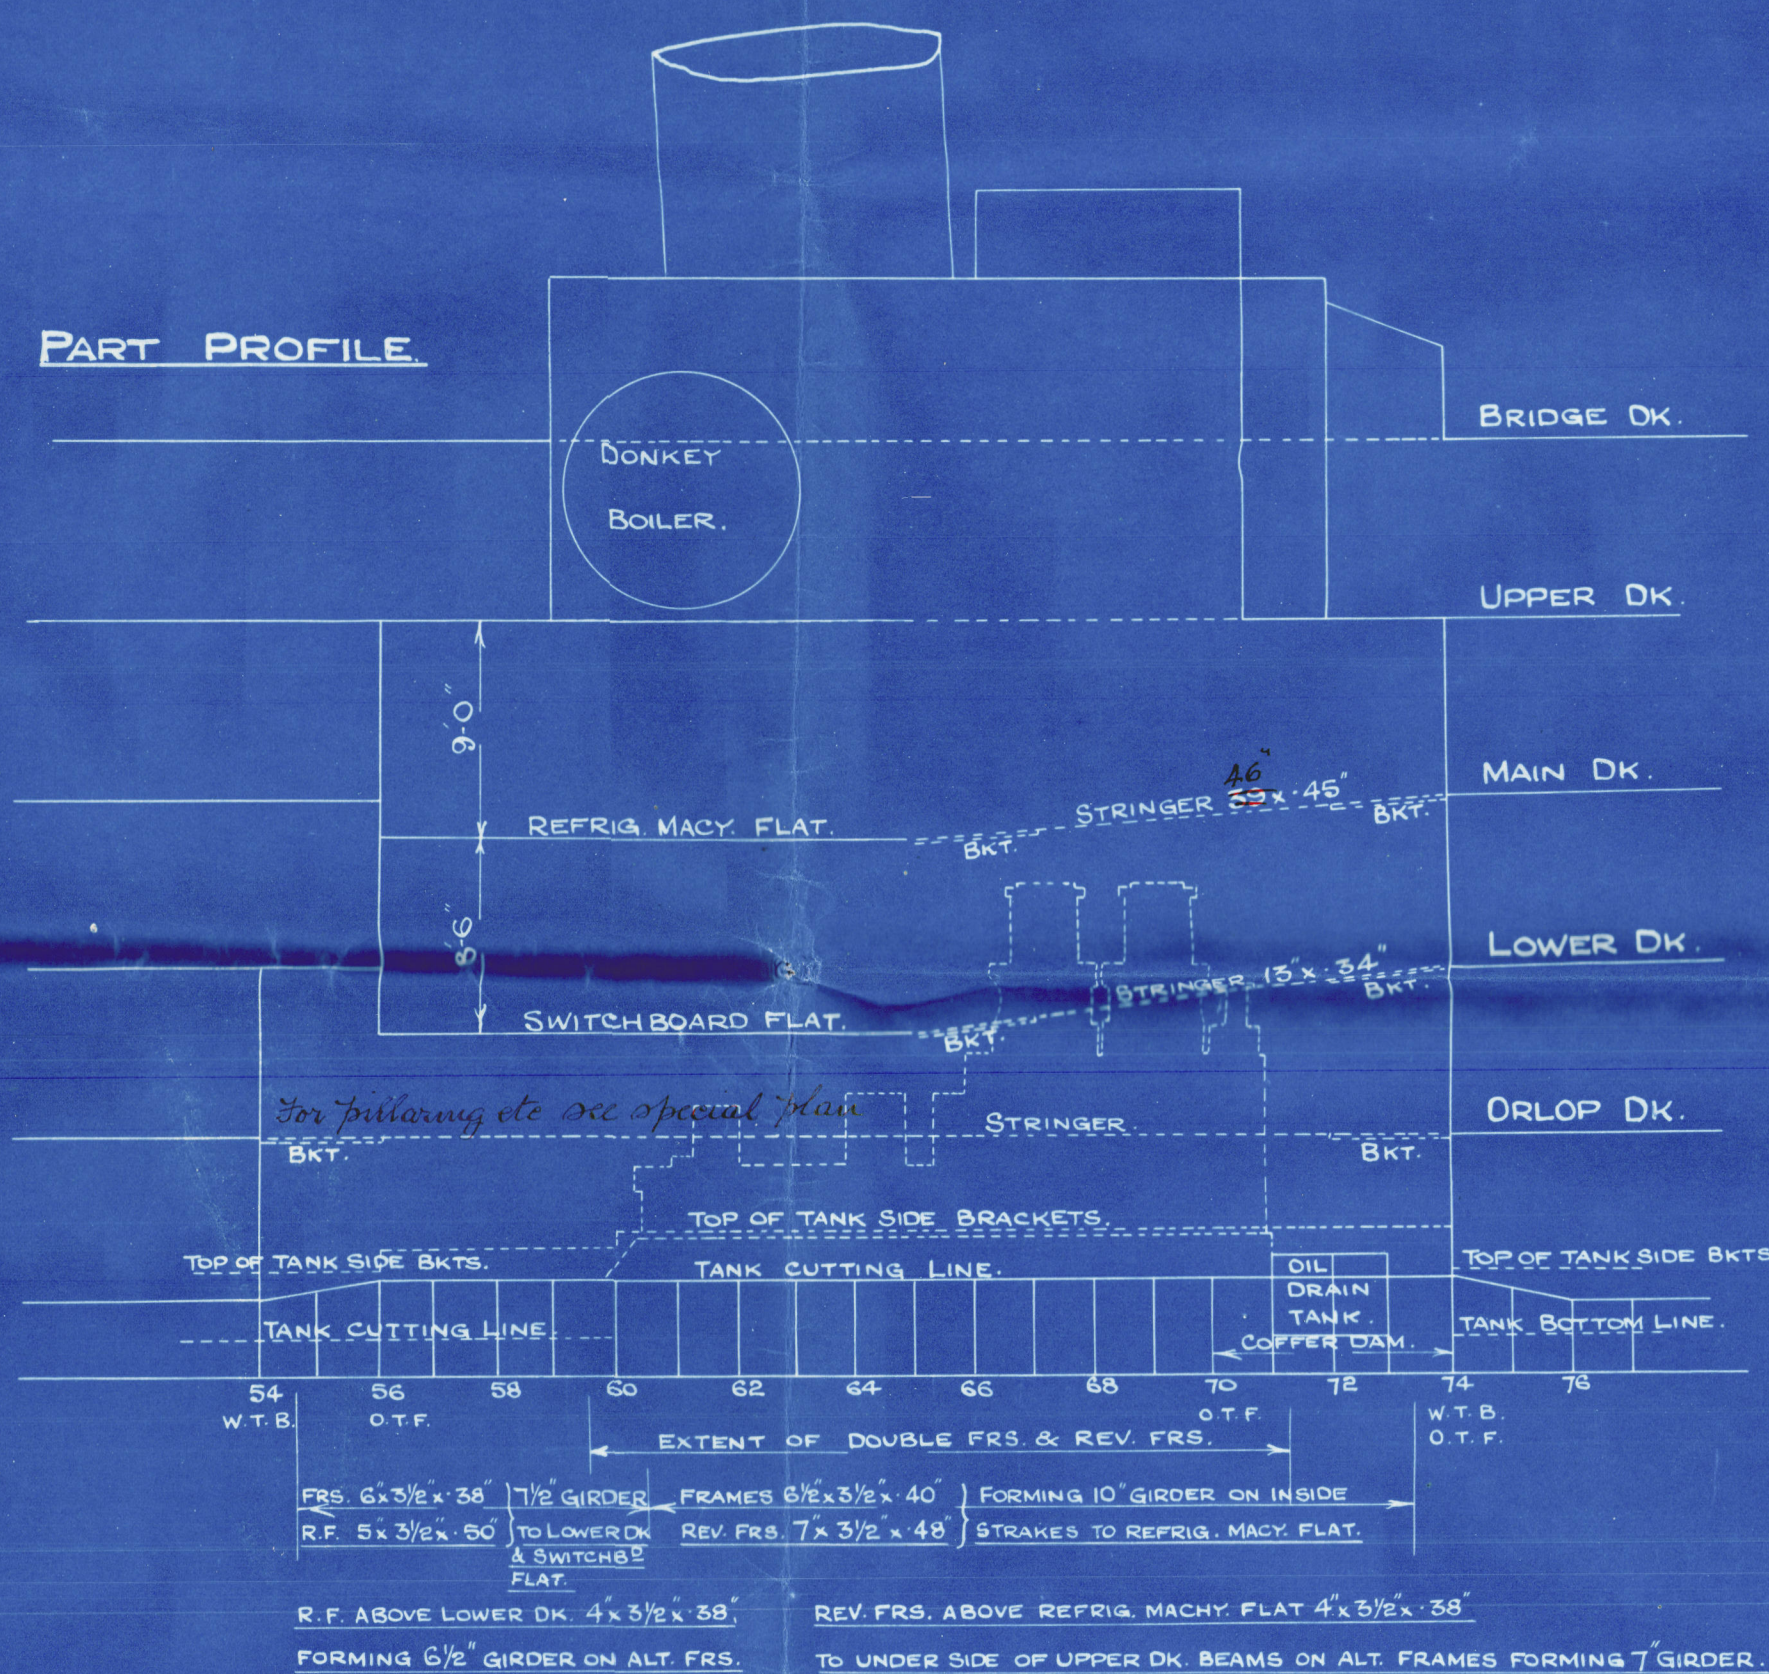


### BRIDGE DECK.

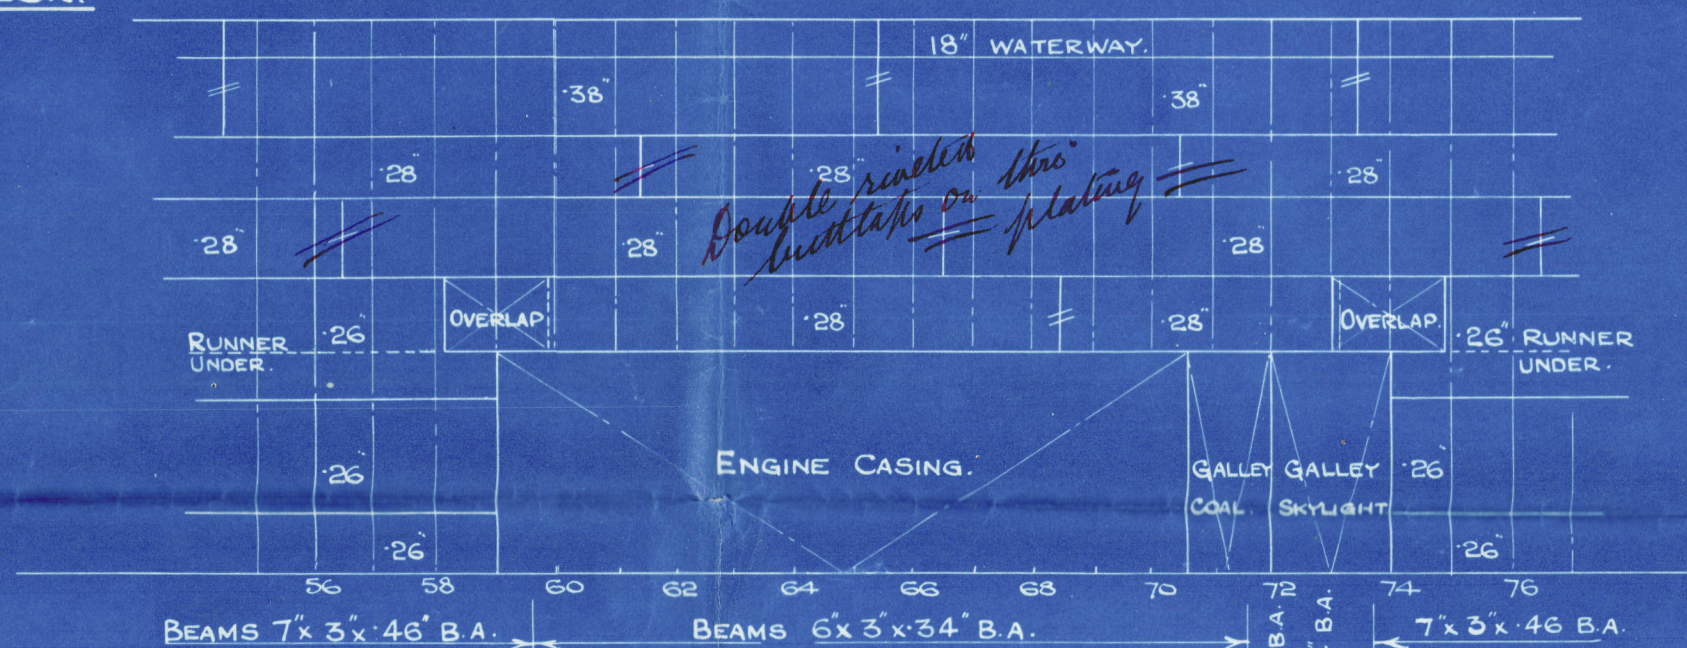



### UPPER DECK.

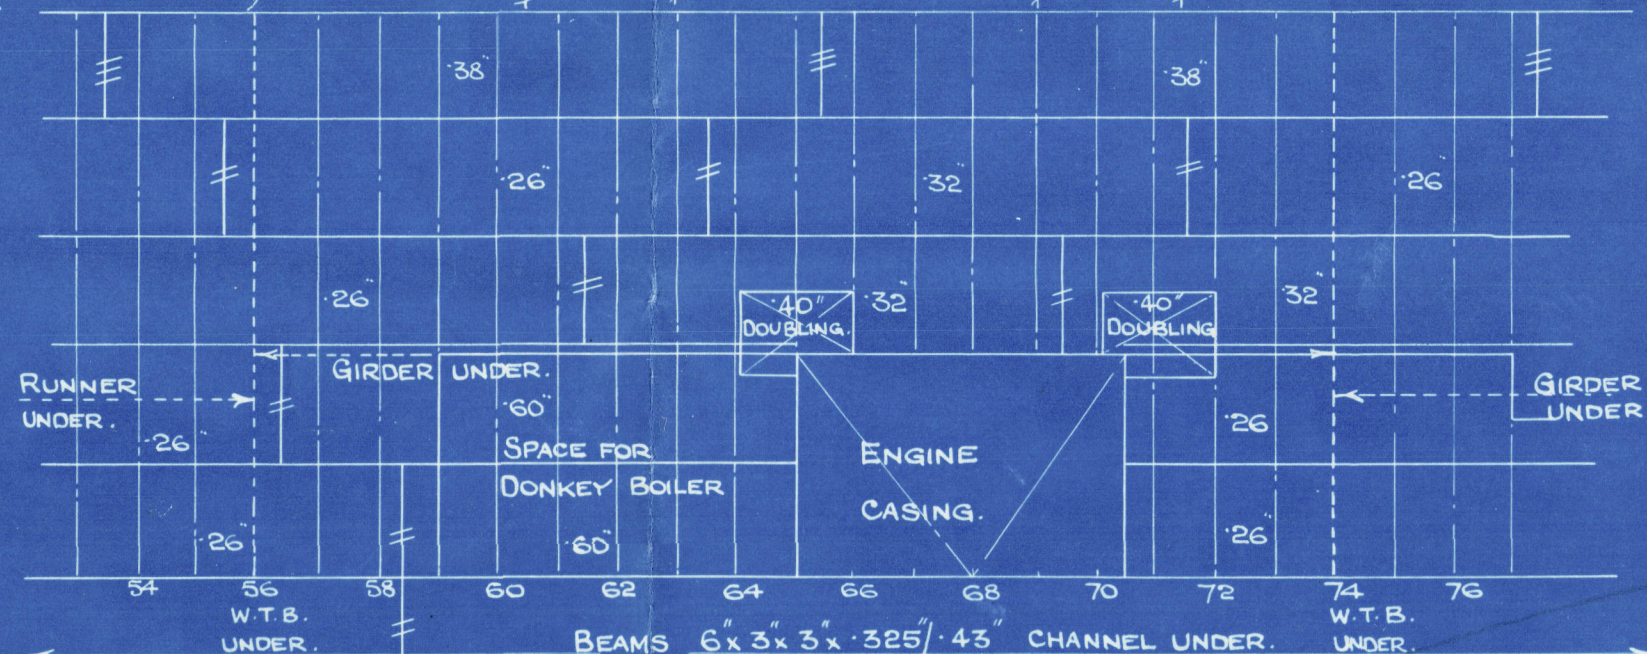

### MAIN DECK

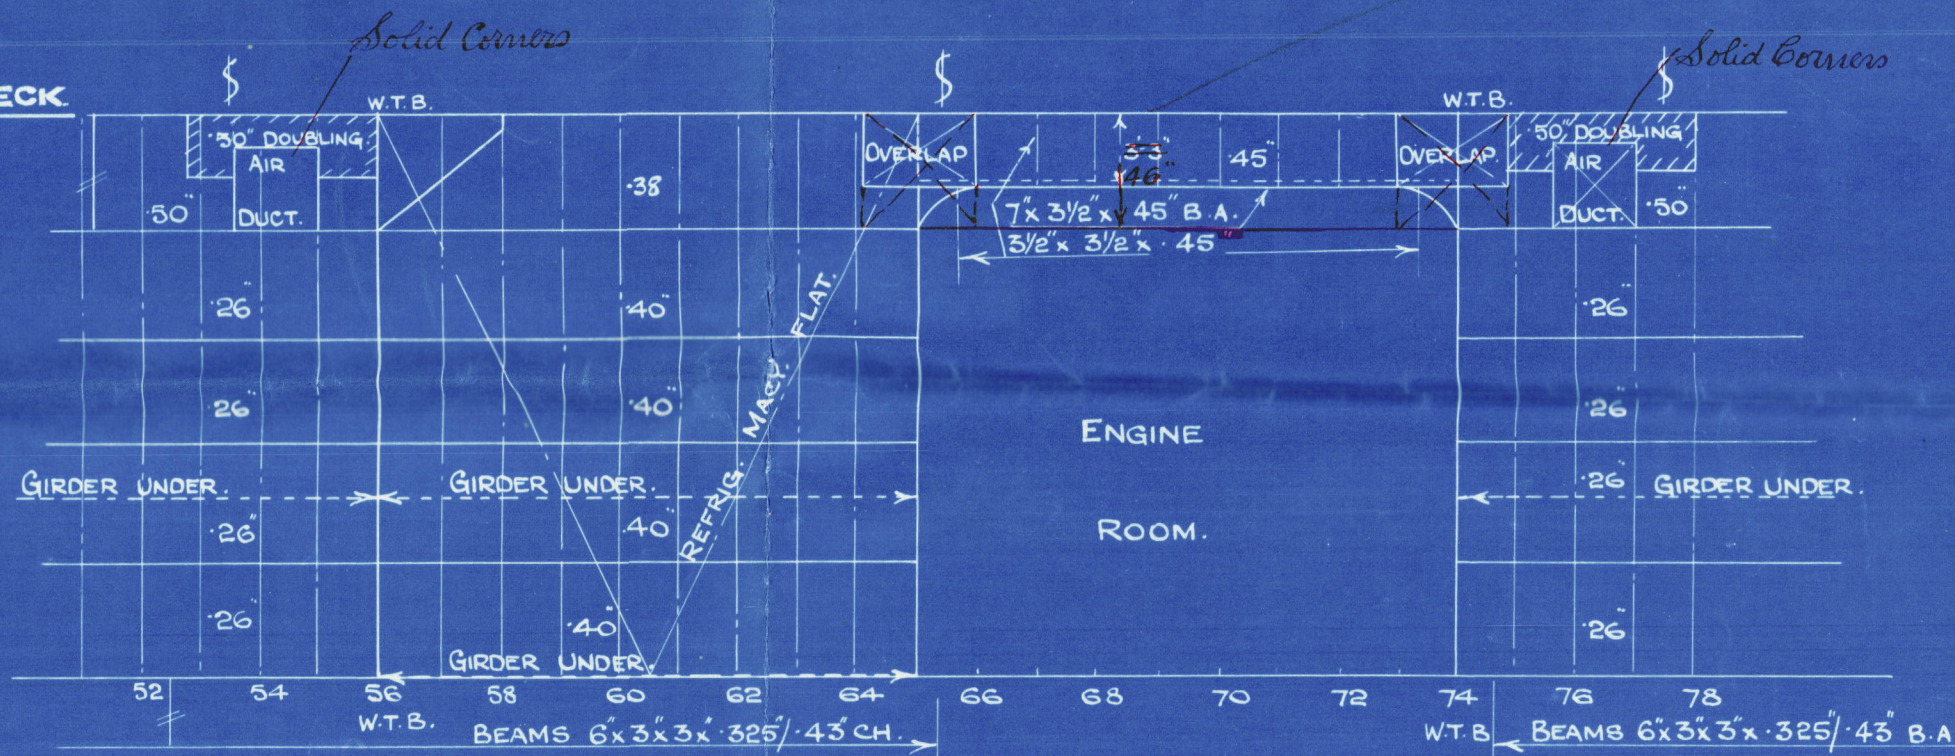

### LOWER DECK

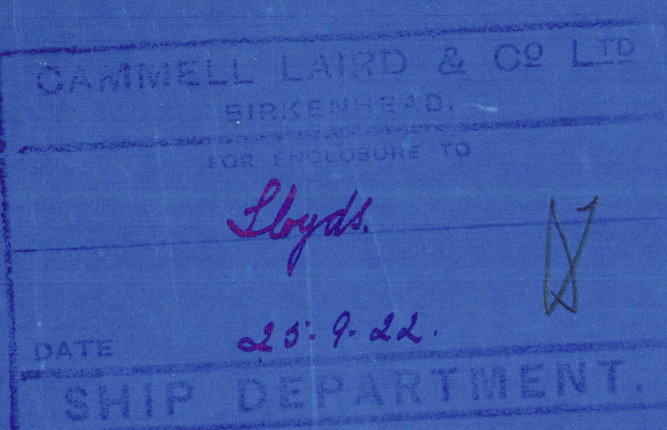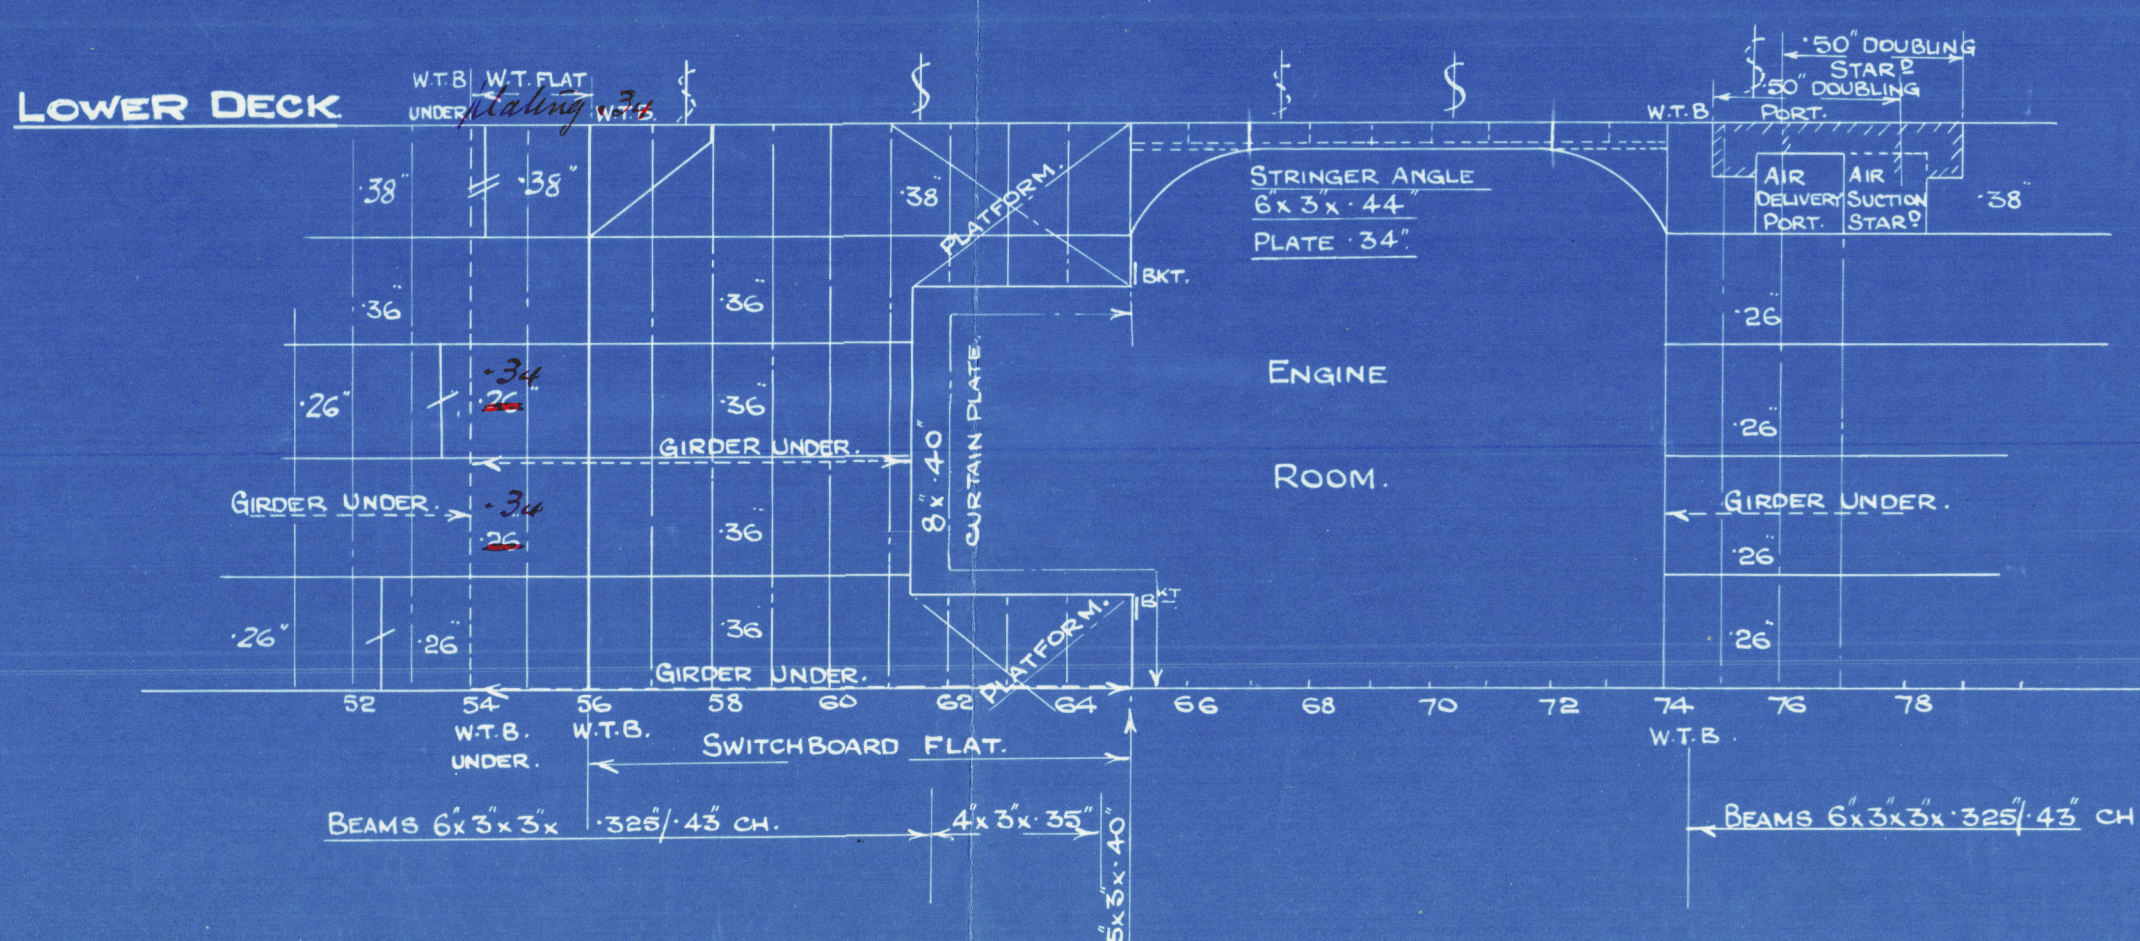

British Corporation 13.9.22

27.9.22

Lloyd's Register  
Foundation



Copy.

Shy showing Revised Longitudinal  
Profile & Constructional Decks.

Messrs Cammell Lairds

N<sup>o</sup> 894-5-6.

S. S. La Playa

LIVERPOOL:

Report No. 86378

S. S. La Marea

LIVERPOOL:

Report No. 86683

S. S. La Perla

LIVERPOOL:

Report No. 88816



© 2021

Lloyd's Register  
Foundation

002656-008668-0063