


~No 894-5-6~

MIDSHIP SECTION

DIMENSIONS 325'-0" x 48'-0" x 31'-9" TO UPPER DECK

SCALE 1/2" = 1 FOOT

CAMMELL LARD & CO LTD
HULL
FOR ENDORSING TO
Lloyd's
DATE 9-23
SHIP DEPARTMENT.

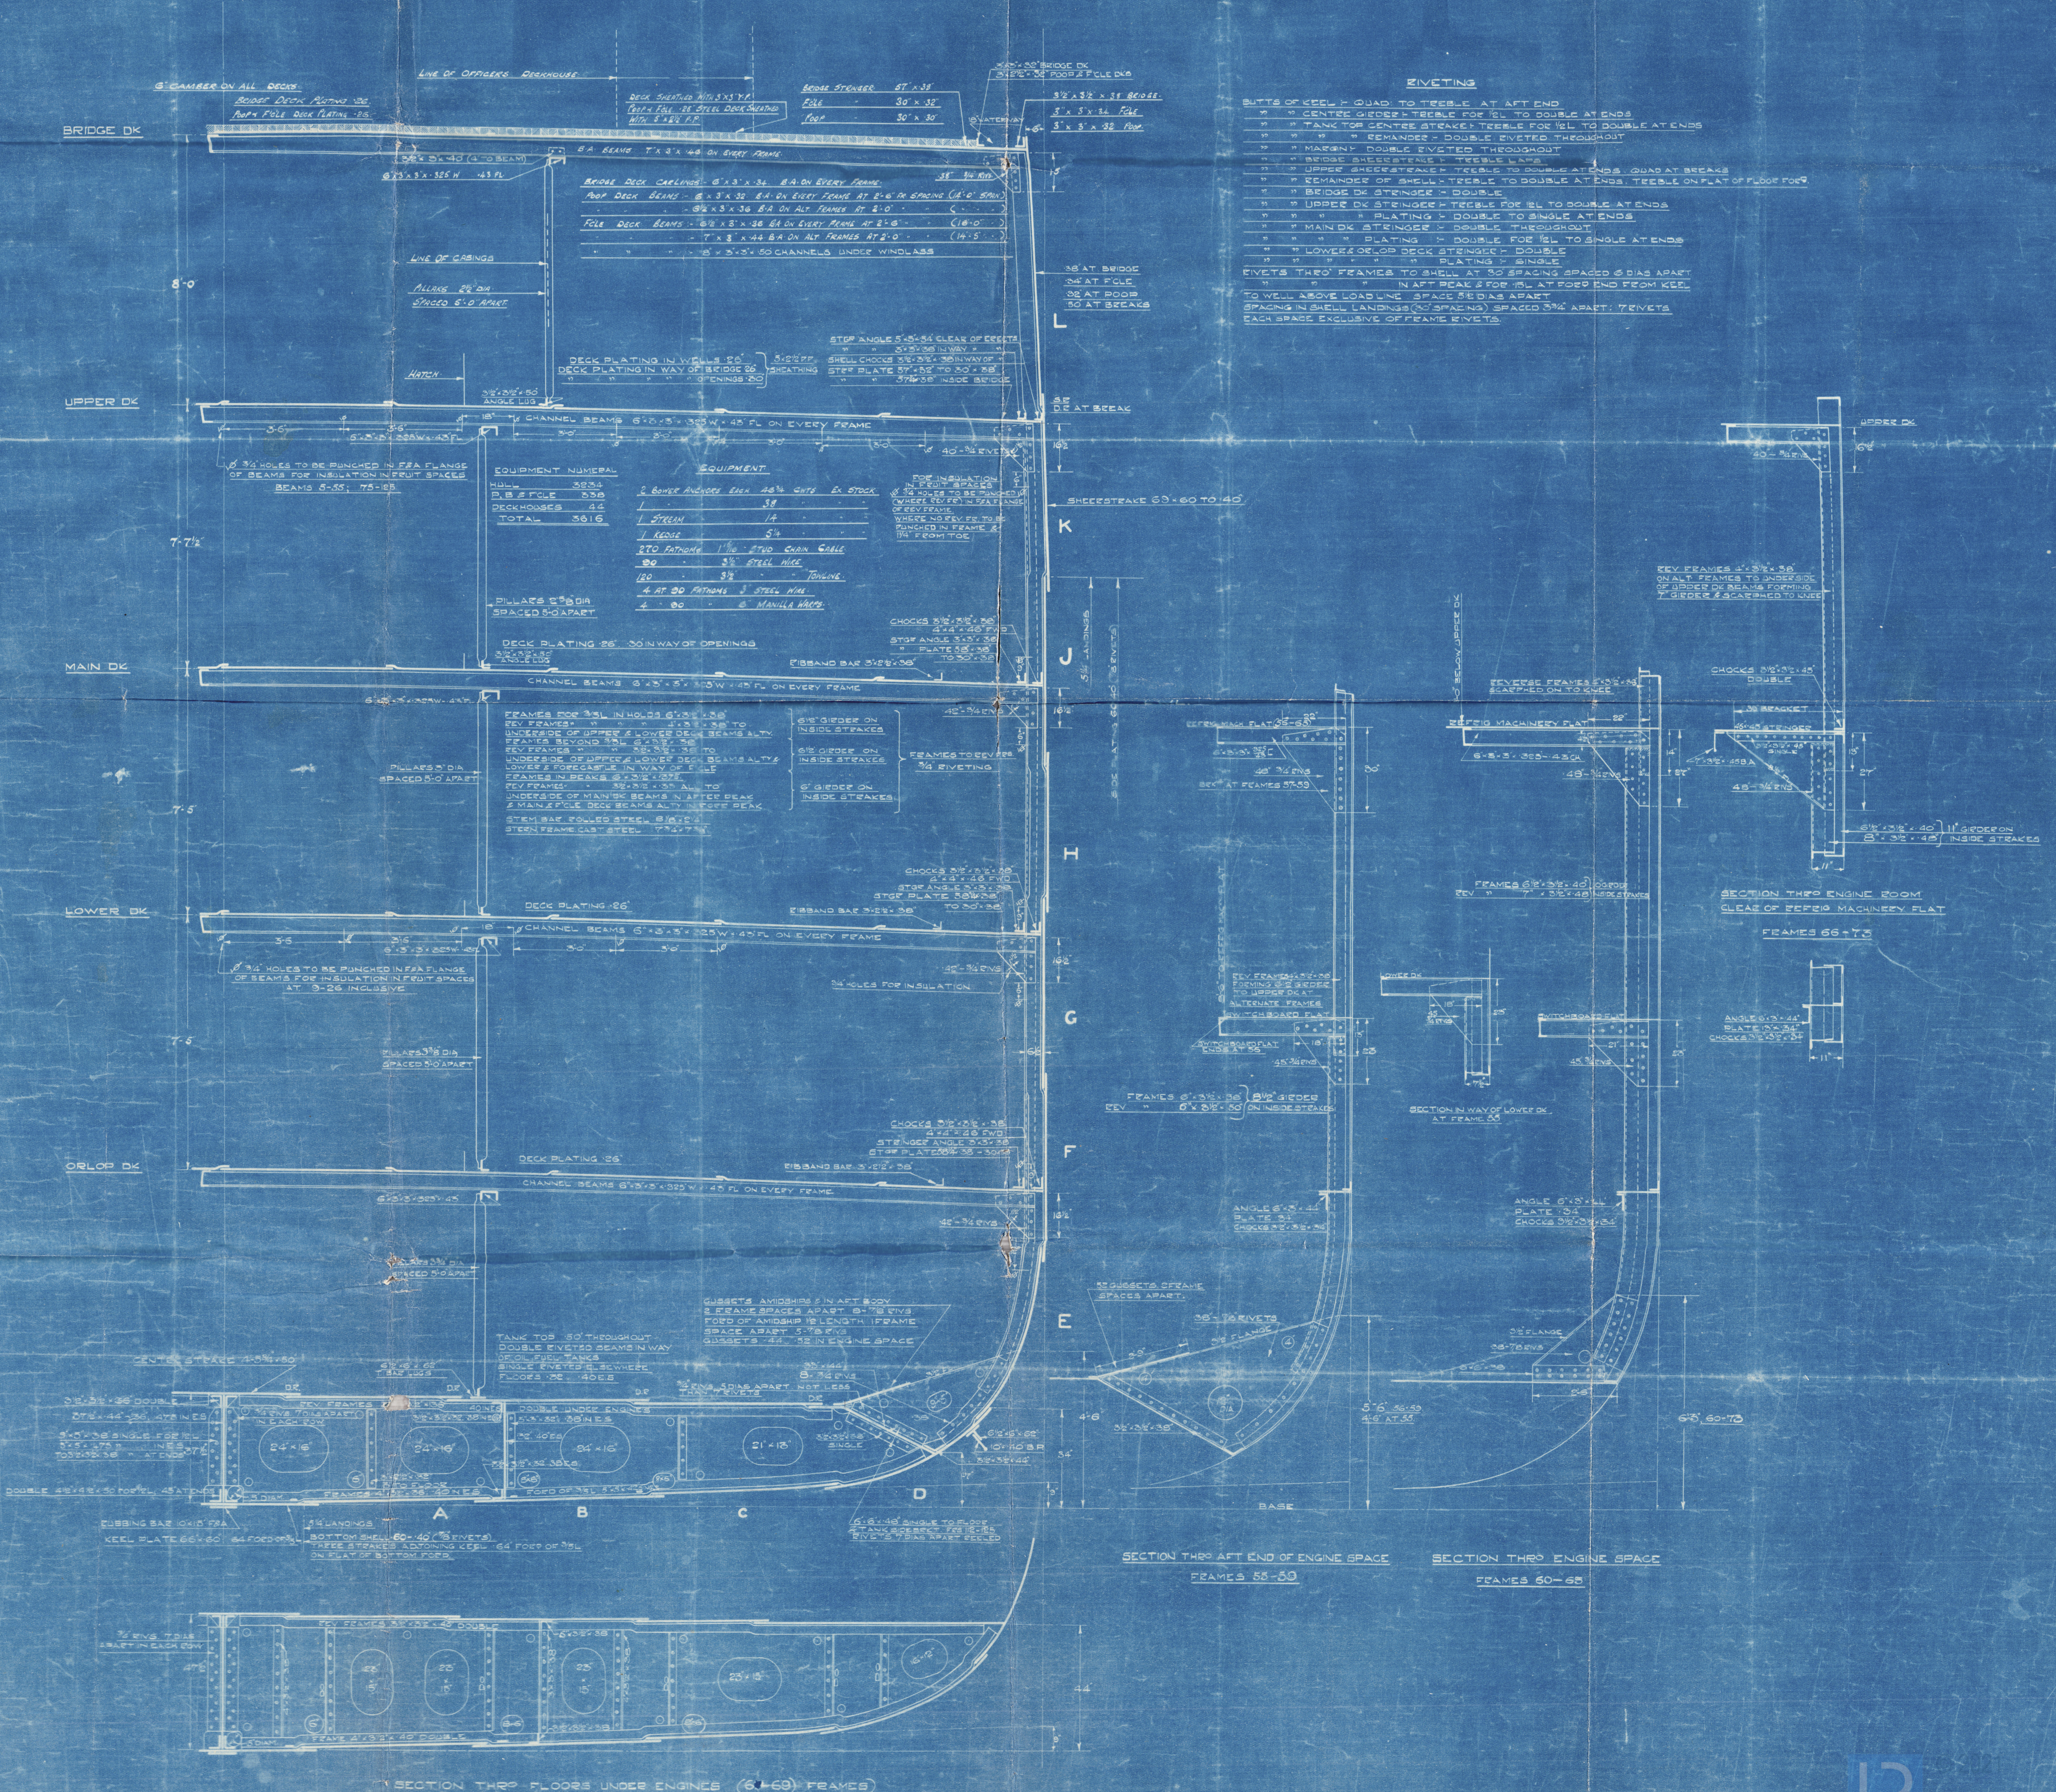

Midships Section (as built)

S. S. LA PLAYA

Mess Cammels Laird's Yard No 89H.

✓

S. S. *La Playa*
LIVERPOOL
Report No. *86378.*



© 2021

Lloyd's Register
Foundation

008656-008668-0064