

M.V. EMPIRE GROSVENOR.  
MIDSHIP SECTION AS FITTED.

SCALE  $\frac{1}{2}$ " = ONE FOOT.

DIMENSIONS.

LENGTH BET. P.P.<sup>s</sup> 190 FT 0 INS.

BREADTH MOULDED 32 FT 0 INS.

DEPTH MOULDED 14F 9 INS.

CLASS LLOYDS 100.A.1. CARRY PETROLEUM IN BULK.

WITH FREEBOARD CORRESPONDING TO A SUMMER  
MOULDED DRAFT OF 13 FT 0 1/2 INS.

## NUMERALS.

|                     |       |
|---------------------|-------|
| D                   | 14.75 |
| $L \times D$        | 2803  |
| $L \times (B + D.)$ | 8883  |
| $L \div D$          | 12.88 |

EQUIPMENT.

2 BOWER ANCHORS STOCKLESS EACH 2 1/4 CWTs

|   |                              |    |   |
|---|------------------------------|----|---|
| 1 | BOWER ANCHOR STOCKLESS SPARE | 18 | " |
|---|------------------------------|----|---|

|          |           |                 |
|----------|-----------|-----------------|
| 1 STREAM | EX. STOCK | 5 $\frac{3}{4}$ |
|----------|-----------|-----------------|

210 FTHMS 1 3/8" STUD LINK CABLE

60 " 3 1/4" 6x12 FLEXIBLE STEEL WIRE. STREAM.

90 " 3' " " " TOW WIRE.

90     "     2 $\frac{1}{4}$ "     "     "     "     HAWBERS.



90 " 134 " " " " WARPS.

STEM 6" 1 1/2"

FRAMING IN PEAKS SPACED 22"

" ELSEWHERE " 22 1/2

BULB ANGLES ARE N.B.S.

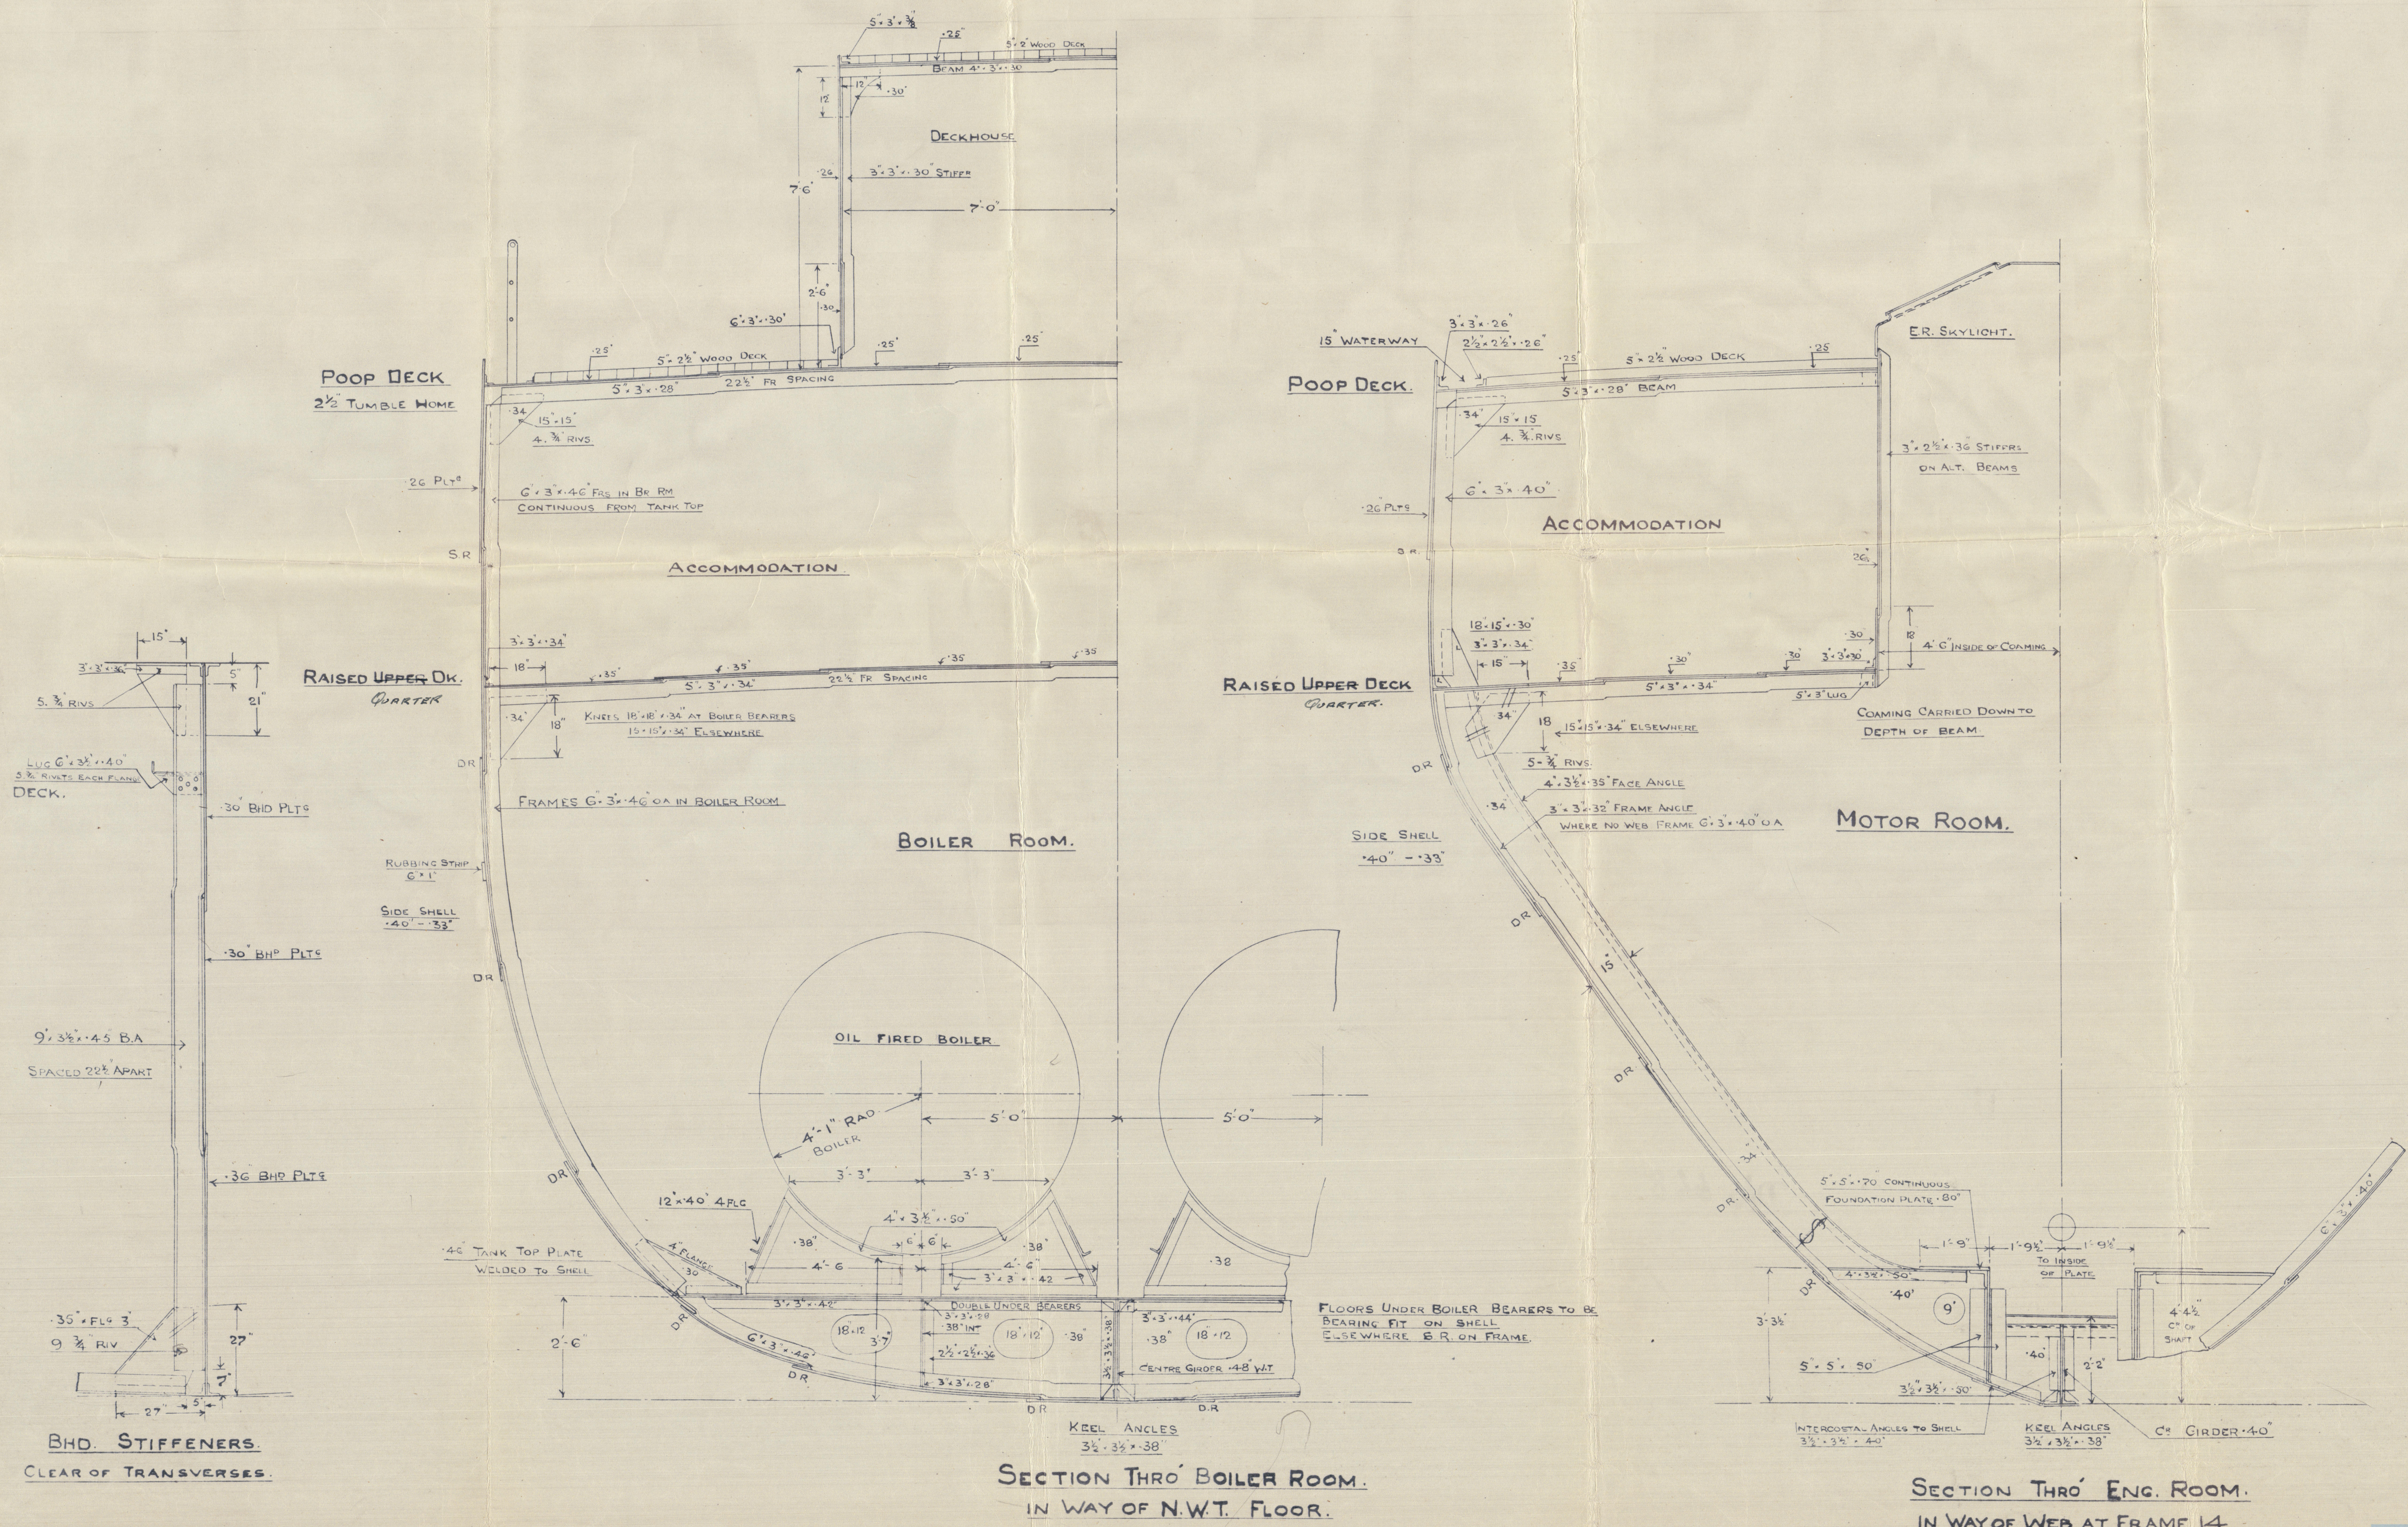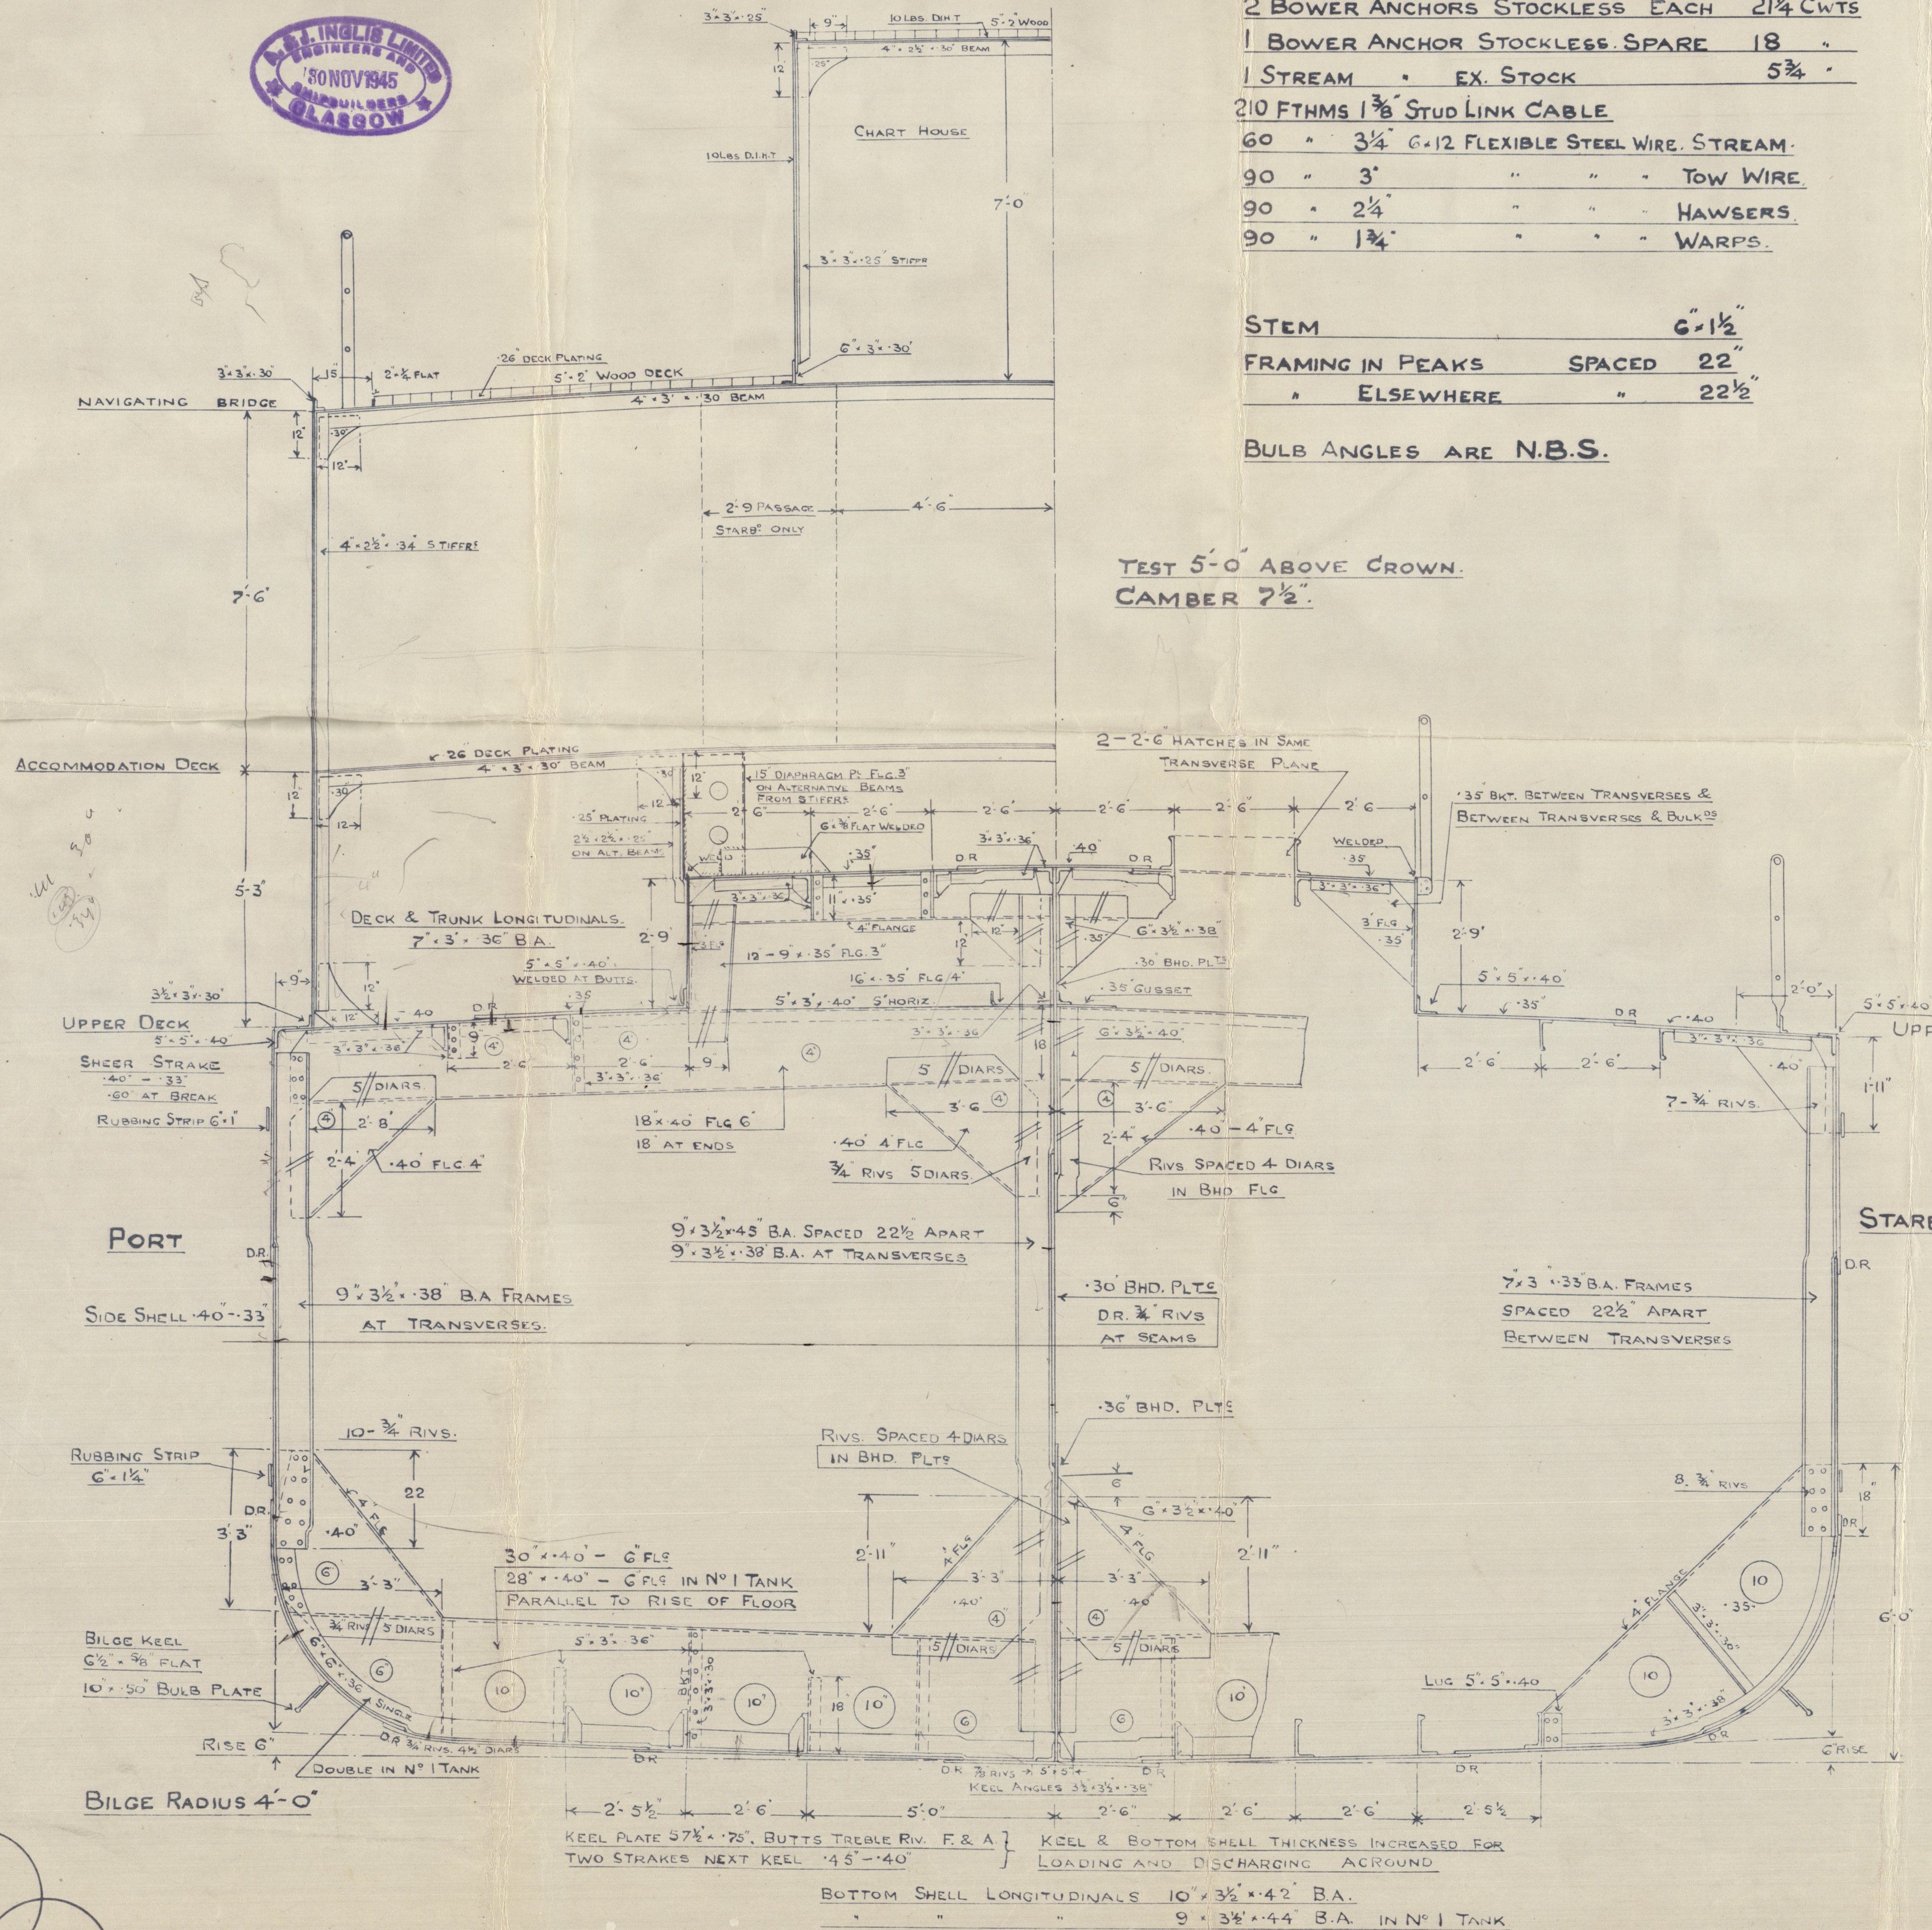



A. S. Pules

Nº 1302

Empire Provenor



Madship Section (as built.)


(1)

*Memorandum*

ANLOR 62  
PERMINA 62

**D/S 668**

*Provenor*

*Memorandum*

1301

Rpt. 70041



© 2021

Lloyd's Register  
Foundation

008656-008662-0219