



Section Fr 104

I Deck	0.5 L			0.1 L
	Stringer	outside Hatchw.	inside Hatchw.	
Deckplating	33.0 ✓	33.0 ✓	8.0 ✓	see long section
Longitudinals	= 300 * 25 ✓			•
Stringer angles	↳ 250 * 25 ✓			•

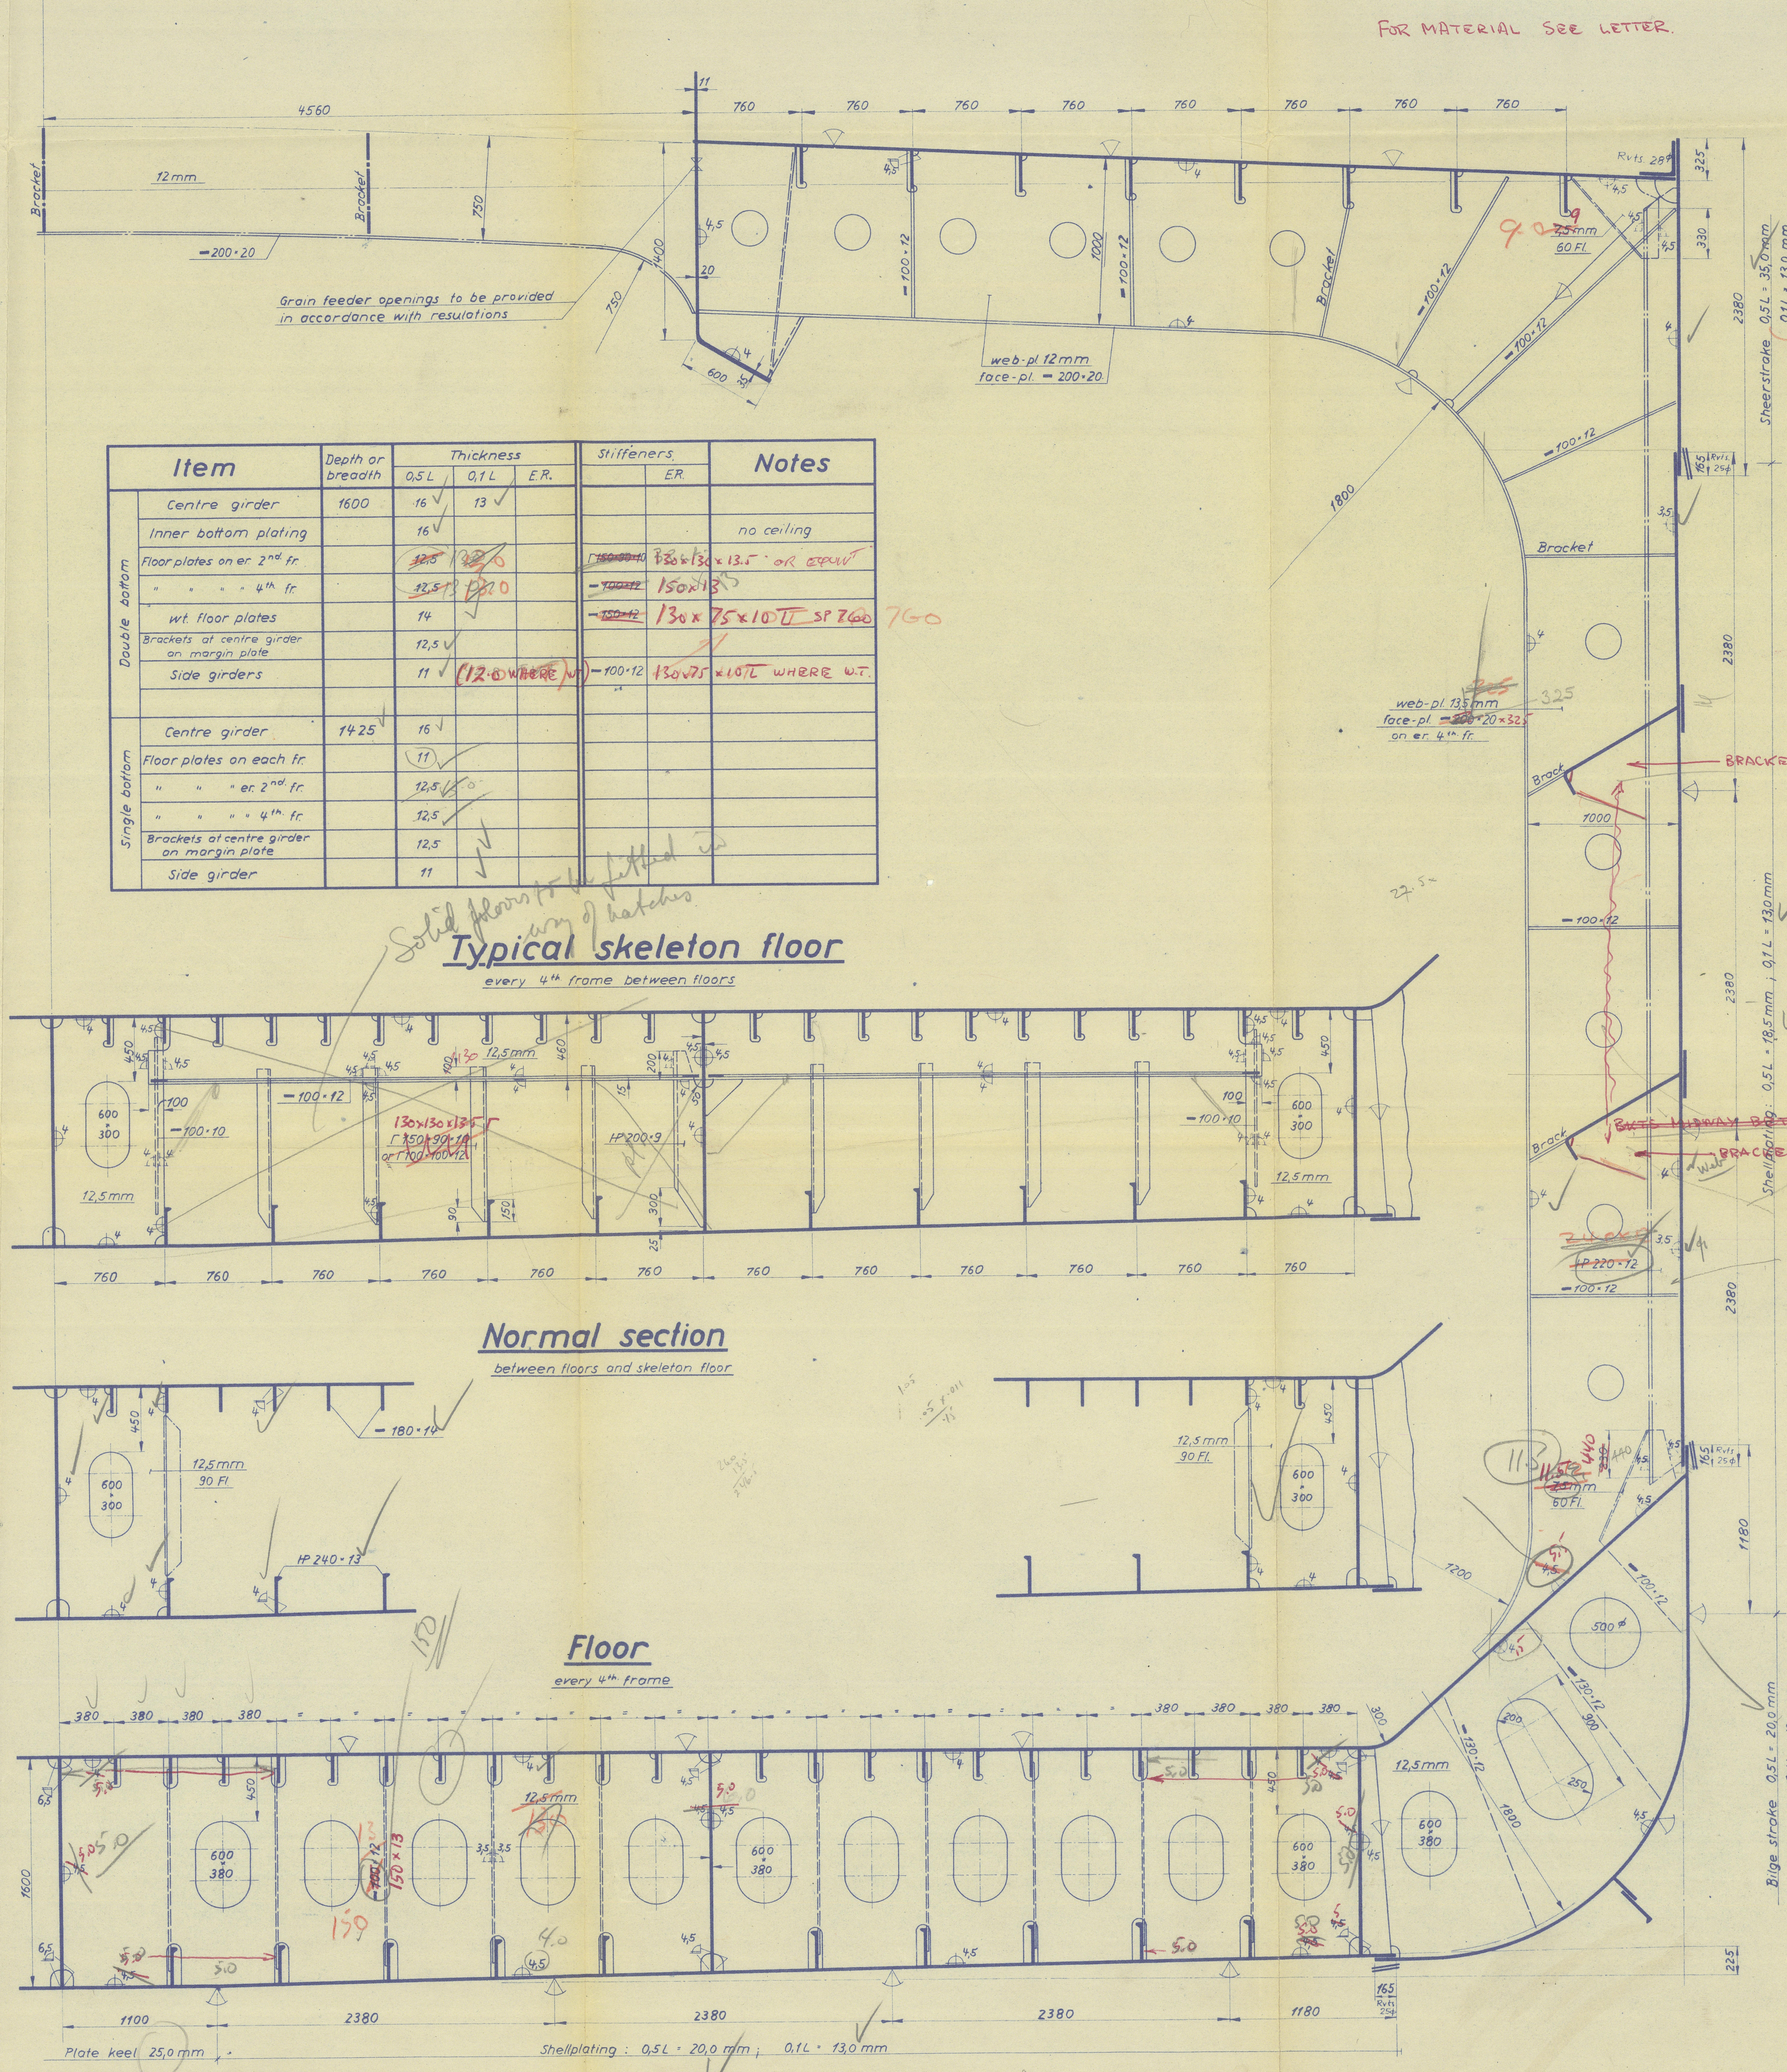

Section Fr. 159

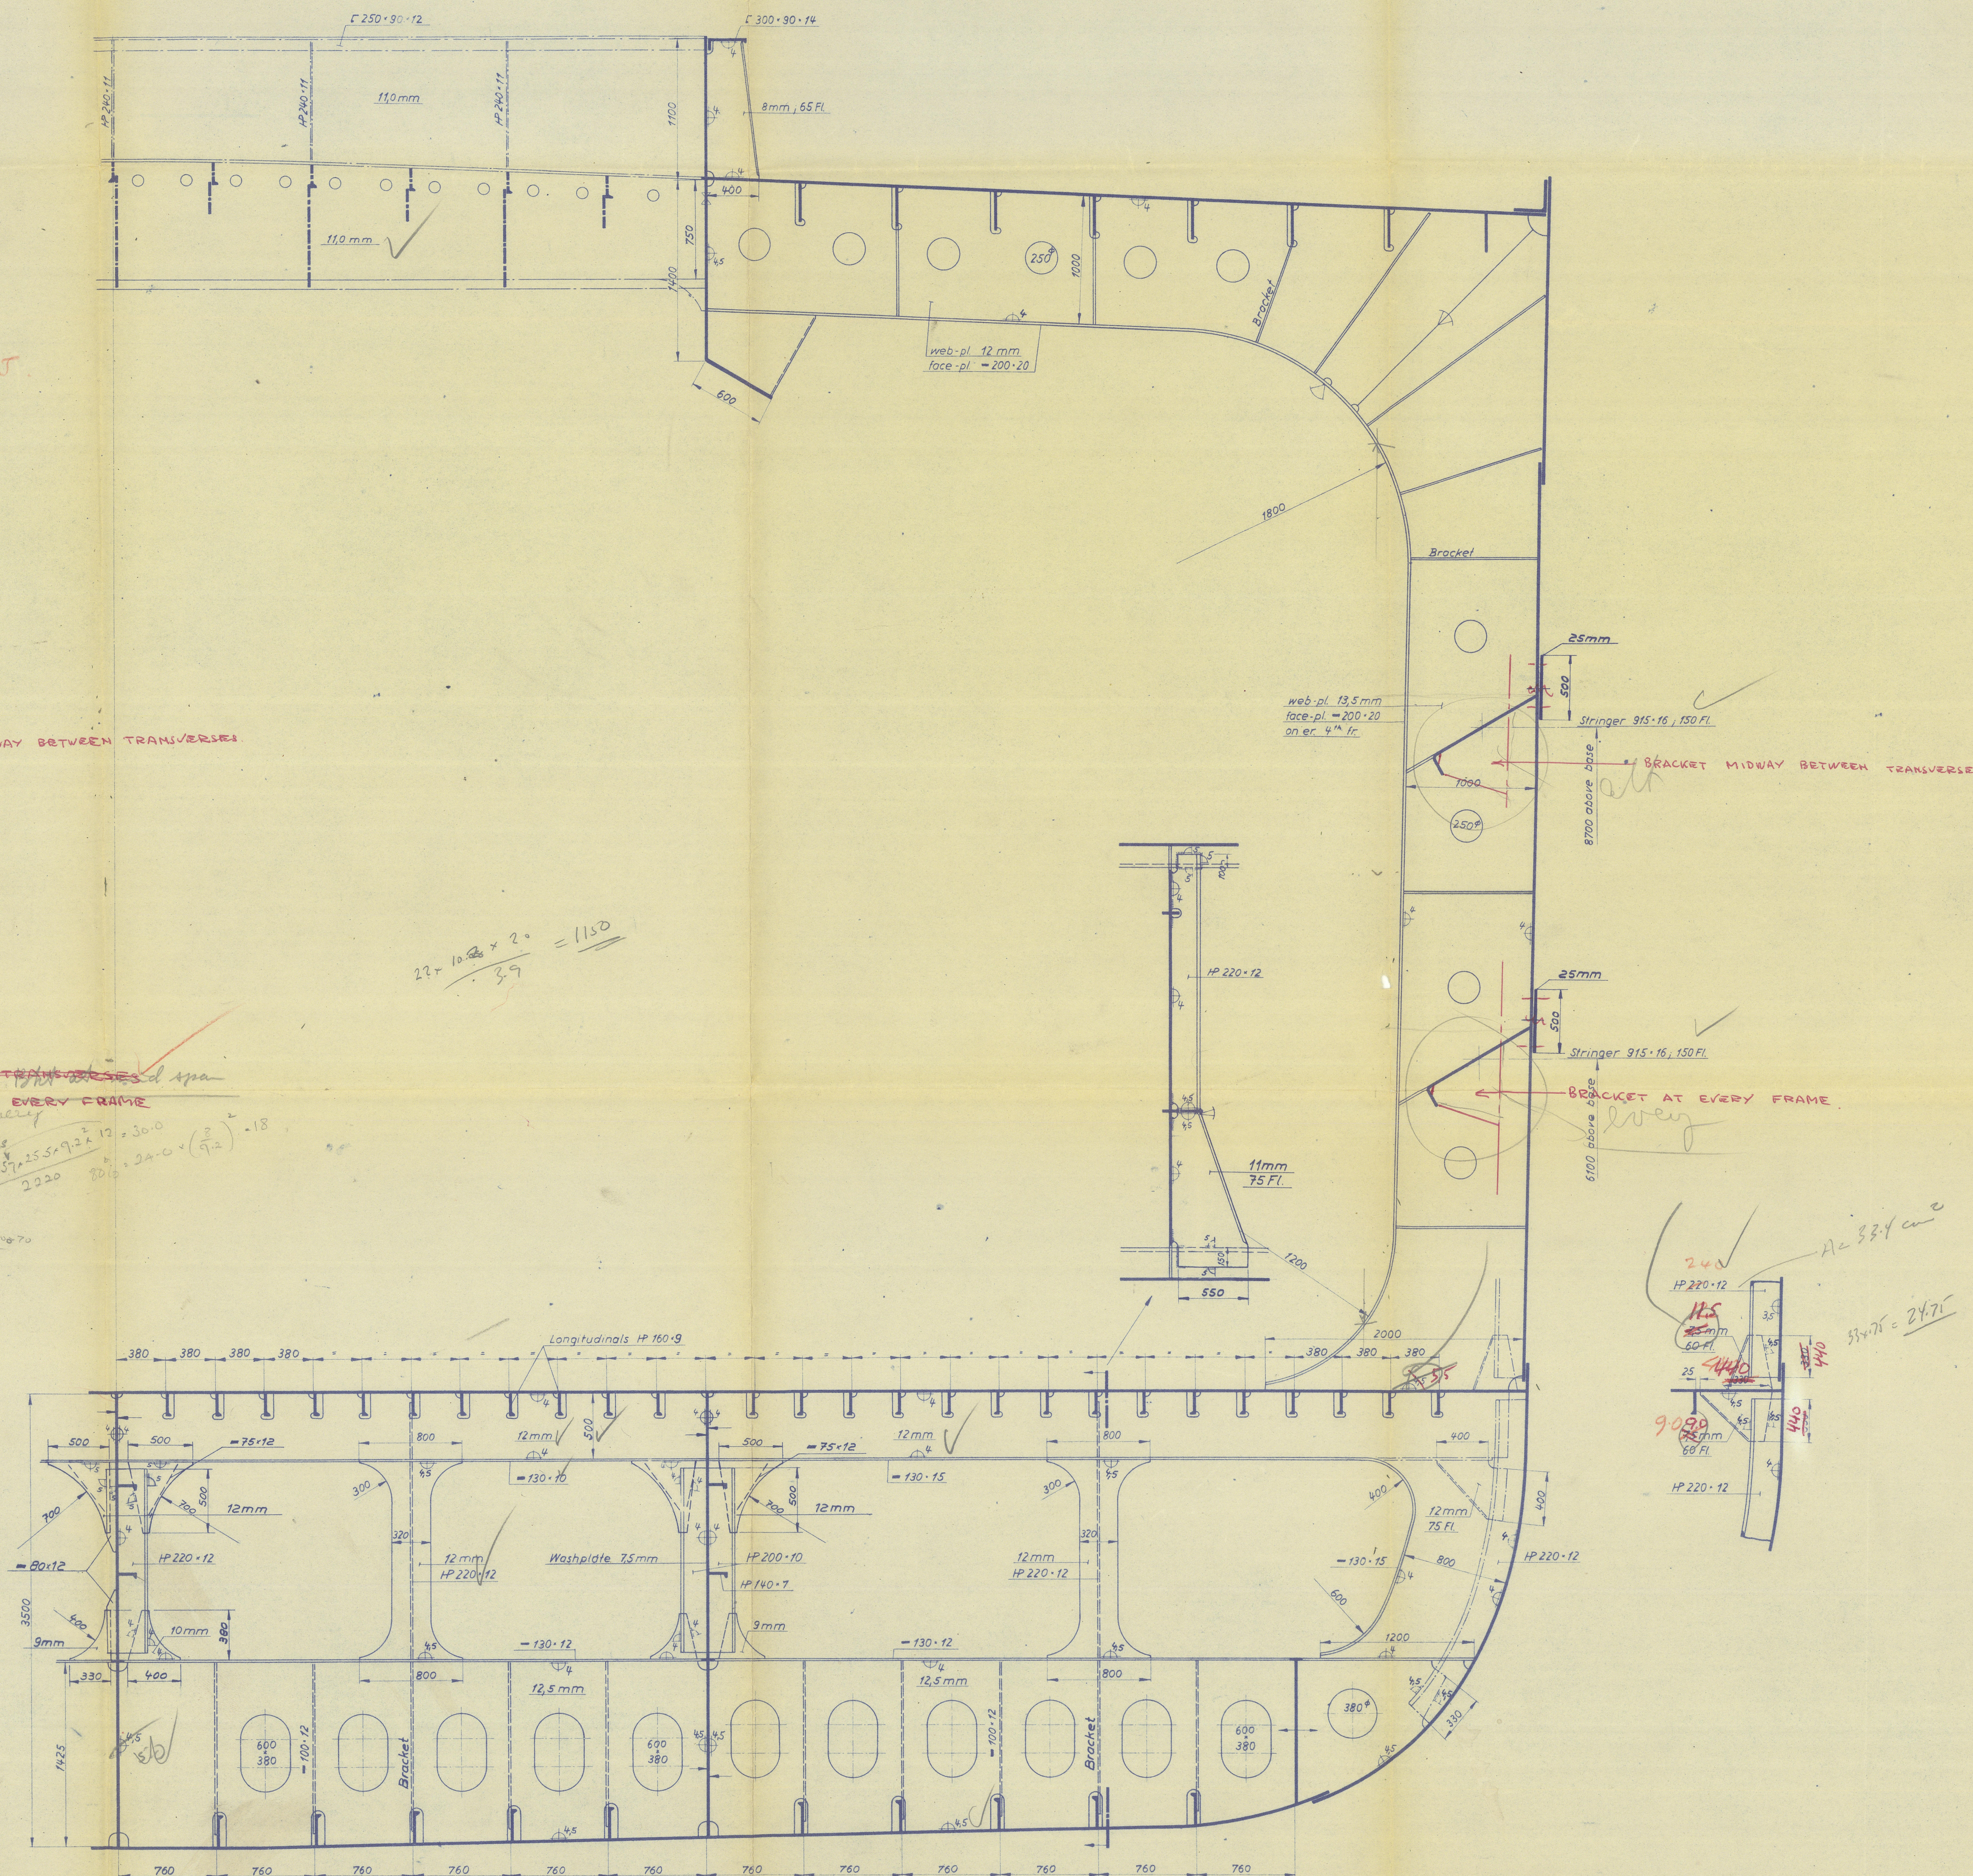

Dimensions

<i>Length between PP</i>	<i>169,164 m</i>
<i>Breadth moulded</i>	<i>22,860 "</i>
<i>Depth</i>	<i>12,649 "</i>
<i>Draught</i>	<i>8,992 "</i>

Equipment Nr. C46(S)

Bower anchors (stockless) 2 je 6398 kg

Spare bower anchors (stockless) 1 5445 kg

Stud link chain cable 600 m high strength 63,5 mm^ø

Towline 1 6*37 256m 51mm^φ

Hawfers (Manila) 5 ²⁰⁰ 165m 203mm circumference
or 5 ²⁰⁰ 6-12 165m breaktest 49500 Lbs.

Stream anchor (stockless) 1 2286 kg

" chain 6-37 1 192m 38 mm^φ

EQUIPMENT suitable for a numeral not exceeding 6225
is EQUIPMENT LETTER J+

Class: ^{100 A 1} ABS ✱ A1 (E) ✱ AMS

~~strengthened for heavy cargo~~ SEE LETTER

"Invicta ex Geo. G."

Corrected according to plan and letter of ~~28~~ of 12.5.60 & K. 24.5.60

		1		2		
--	--	---	--	---	--	---	--	---	--	---	--	---	--	---	--	---	--	---	--	----	--	----	--	-----	--	-----	--	------	--	------	--