
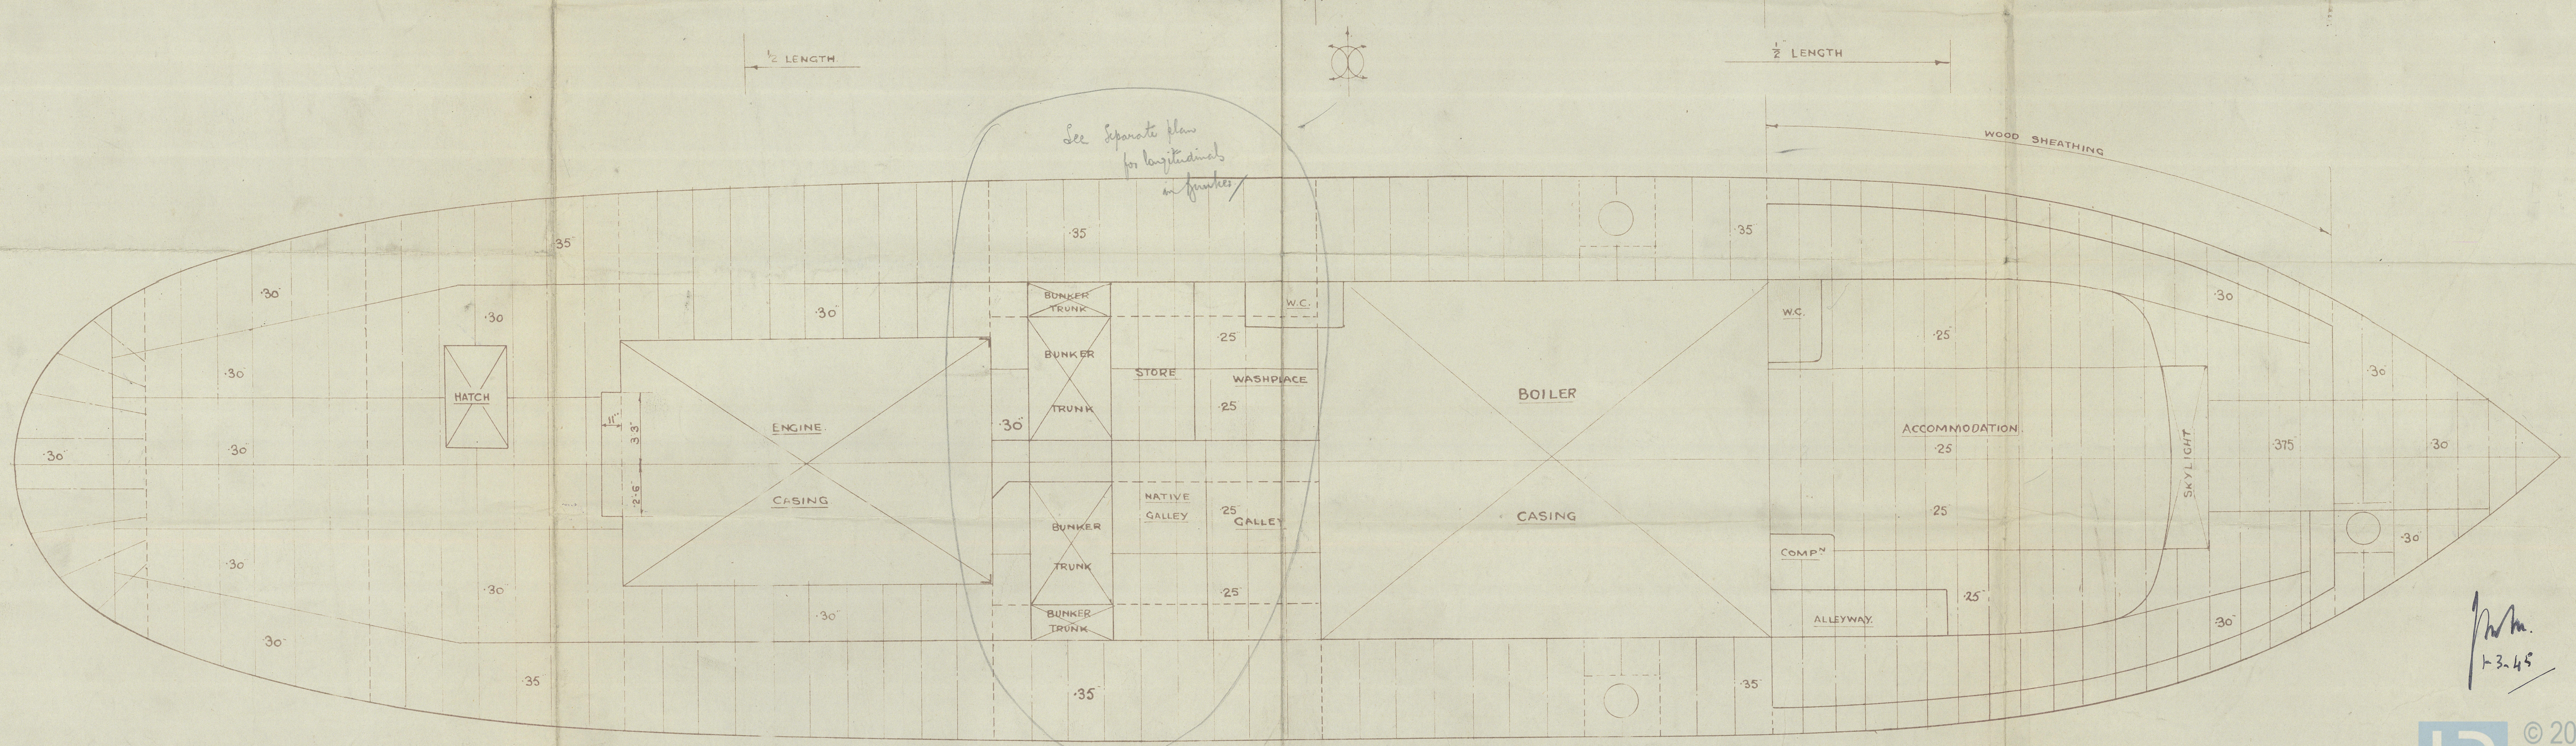
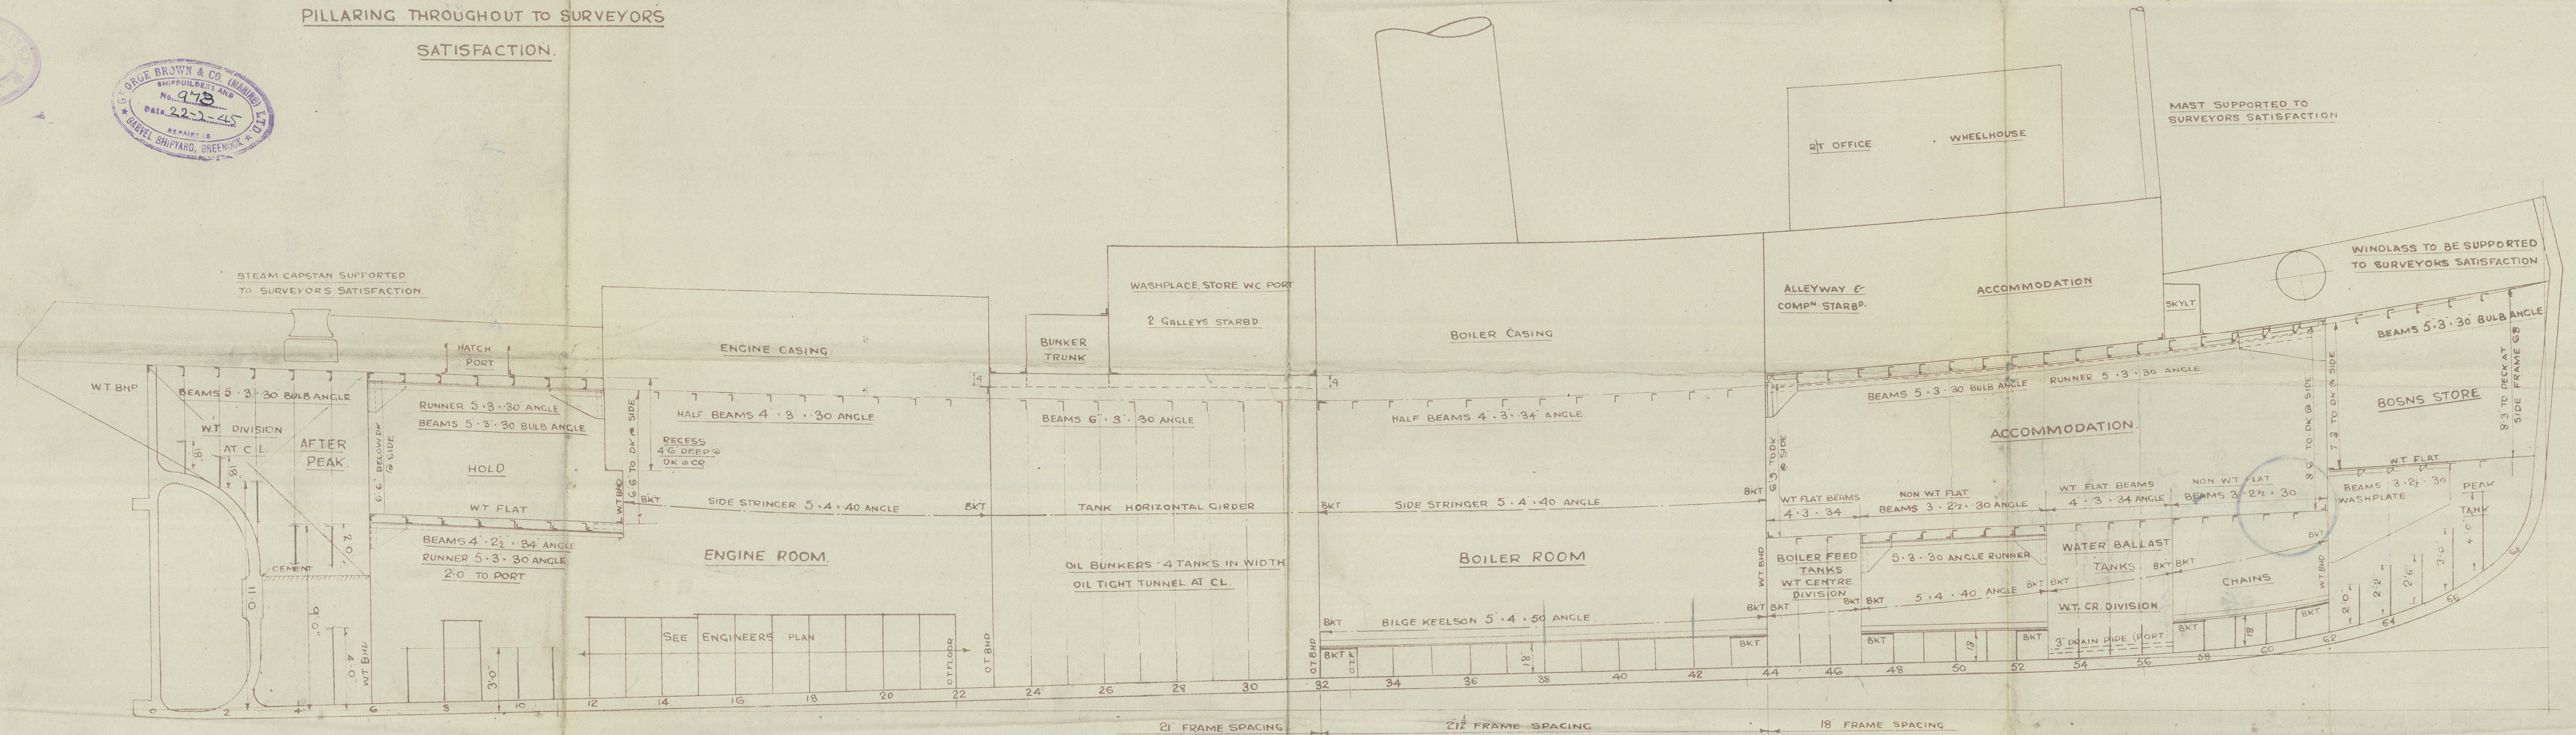


No 236. PROFILE & DECK PLAN

DIMNS: 115'-0" B.P. x 27'-6" MLD x 13'-6" MLD
TO CLASS 100 A1 FOR TOWING SERVICES

SCALE 1/4" = 1 FT.

PILLARING THROUGHOUT TO SURVEYOR'S
SATISFACTION.

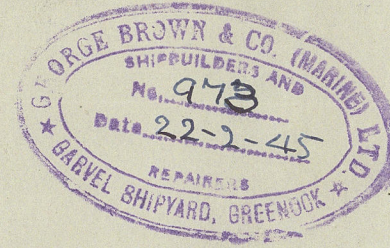


Handwritten signature and date: 1-3-45

(2)


George Brown
No 236

Profile & Feet

"EMPIRE LOLA" 



D. S. 310

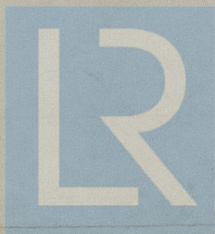

© 2021

Lloyd's Register
Foundation

008609 008678-0268