

EMPIRE LOLA

N<sup>o</sup> 236

## MIDSHIP SECTION

115'-0" B.P. x 27'-6" MLD x 13'-6" MLD.  
TO CLASS #100A.1 FOR TOWING SERVICES

SCALE: 1/2" = 1 FOOT.

### NUMERALS

L x D ----- 1552.5

L x (B x D) ----- 4715

D ----- 13.5

1/2 D ----- 8.5



### EQUIPMENT


1<sup>ST</sup> BOWER ANCHOR 7 1/4 CWTs. STOCKLESS

2<sup>ND</sup> BOWER ANCHOR 6 1/2 CWTs. STOCKLESS


150 FMS. 1 1/8" STUD LINK CABLE

60 FMS. 6" HEMP HAWSER

60 FMS. 5" HEMP WARP


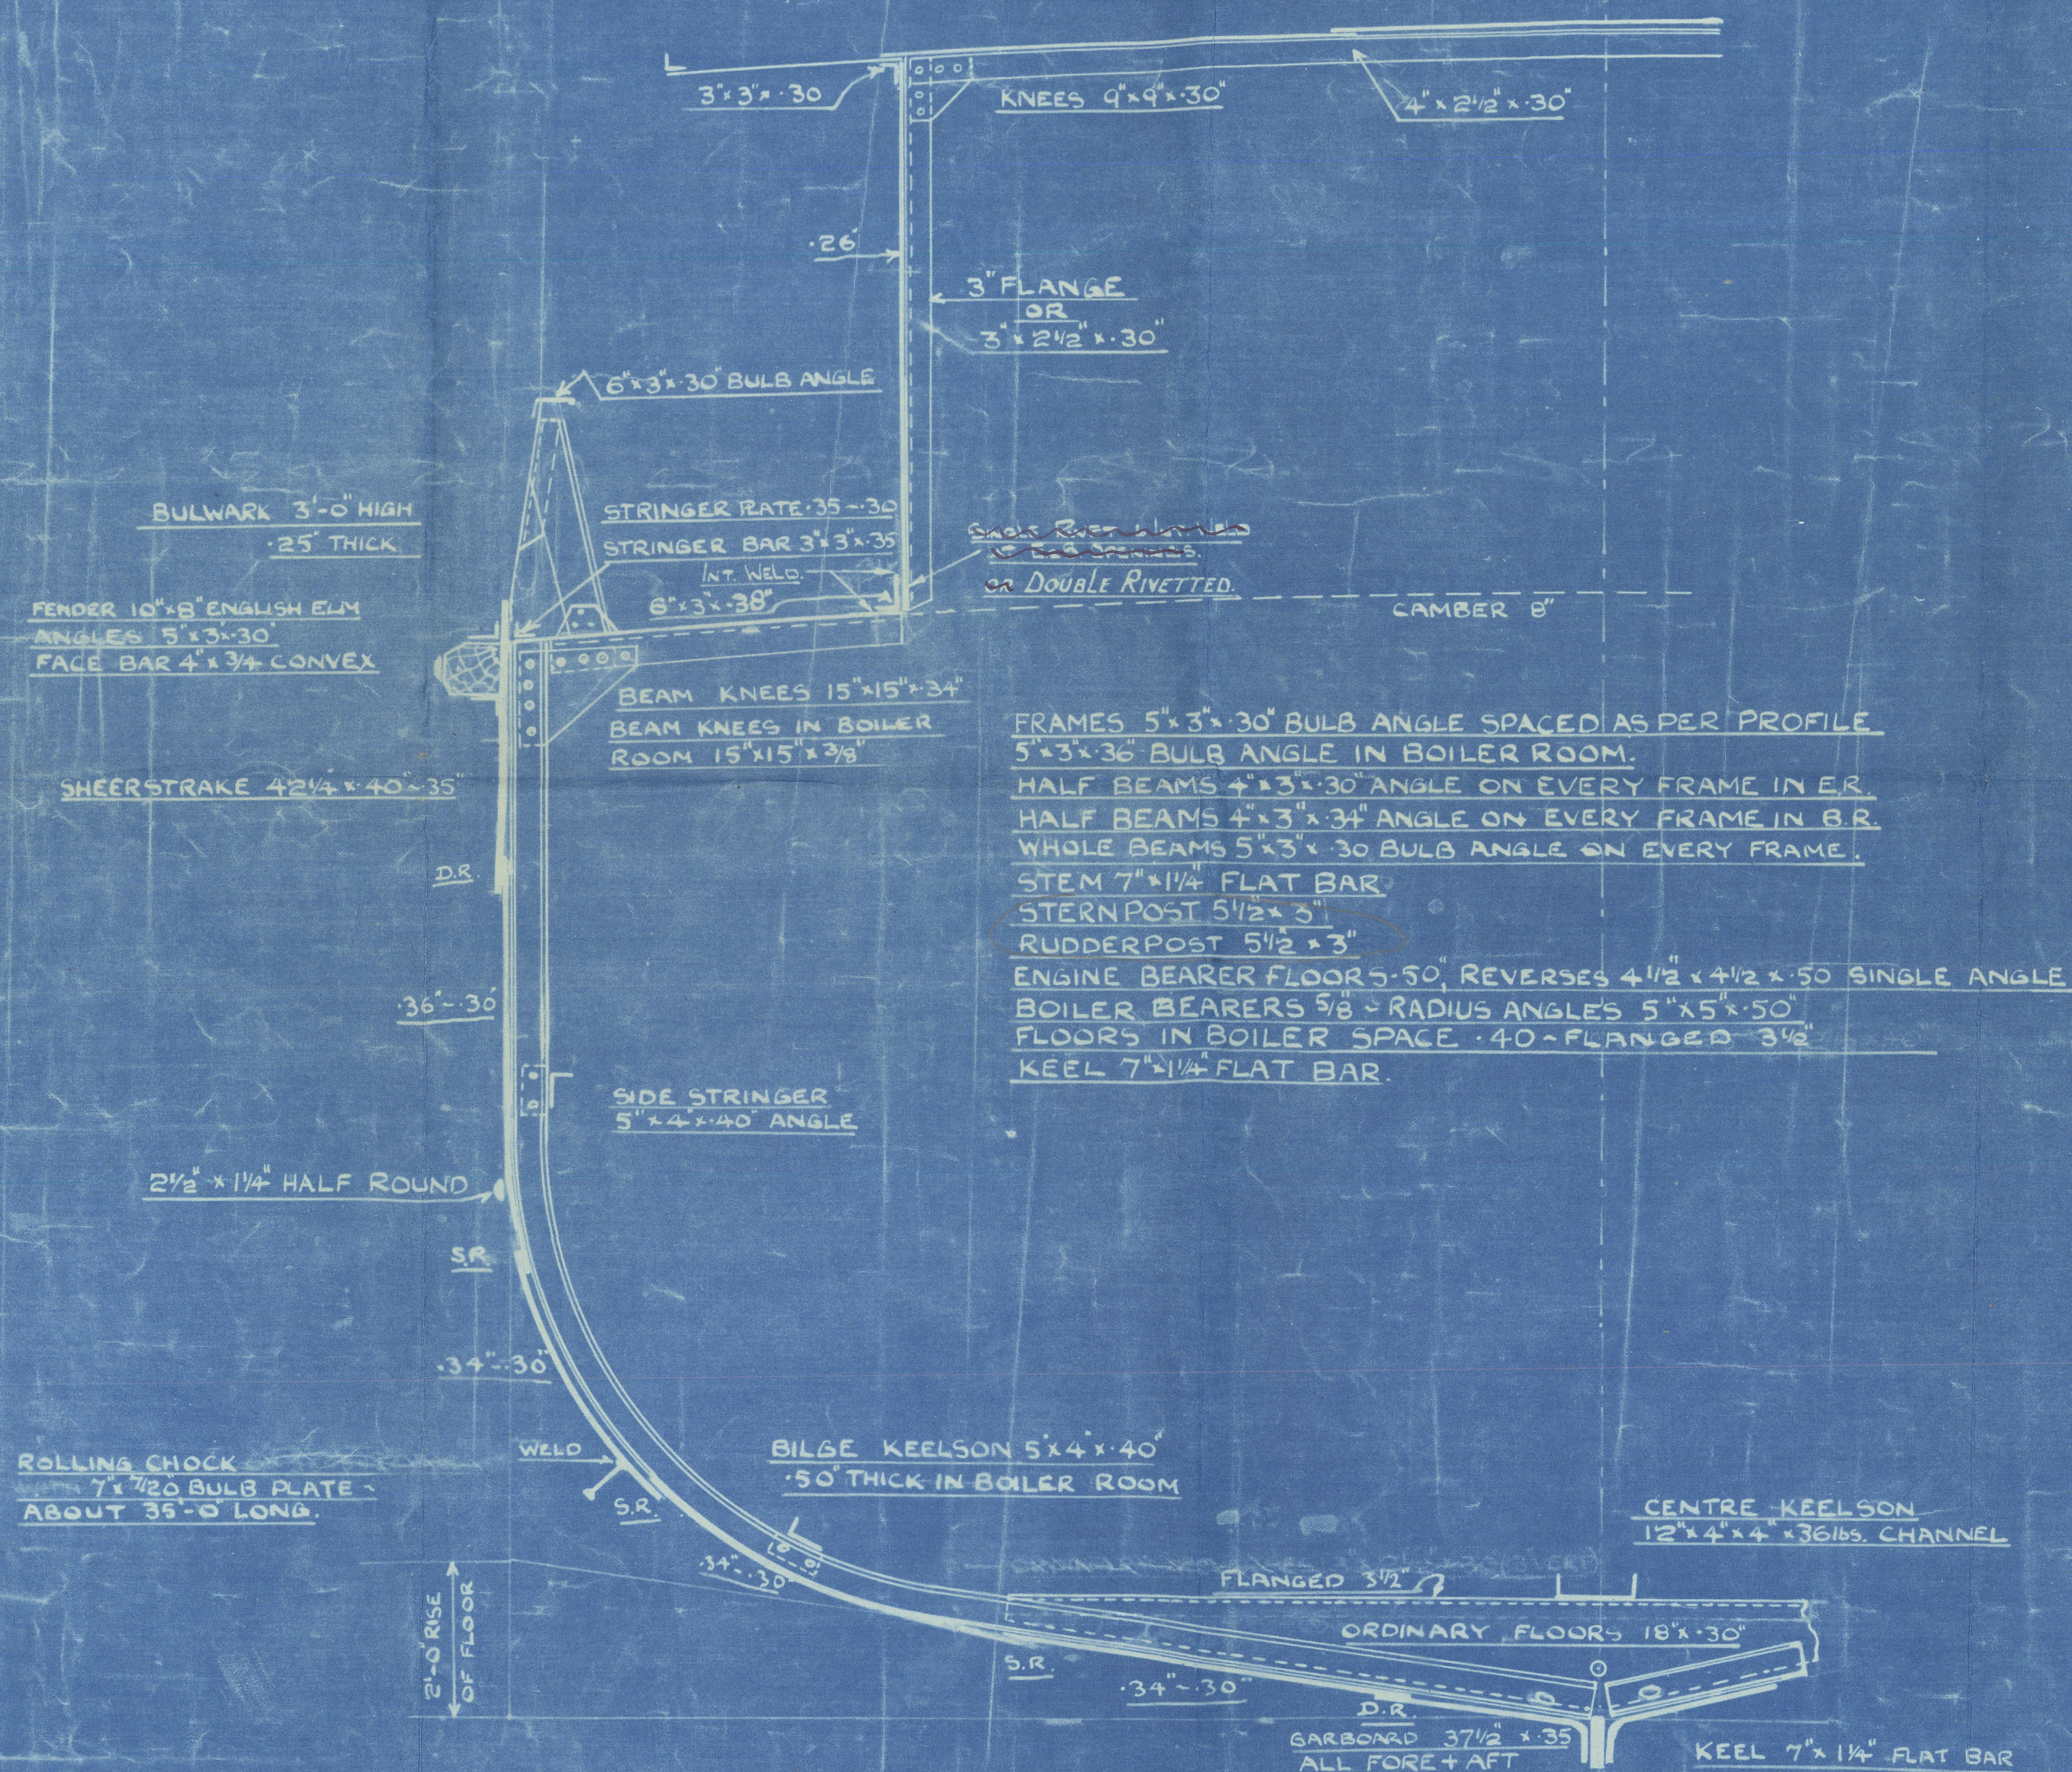


D.S. 310

EMPIRE LOLA. 

MIDSHIP SECTION

(AS FITTED)

 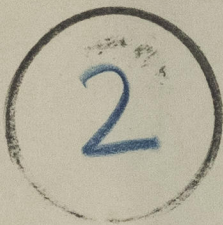

© 2021

Lloyd's Register  
Foundation

008669-008669