
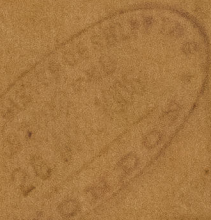



Earle's S. & E. C. Lim.

N^o 507.

Profile & Deck Plan

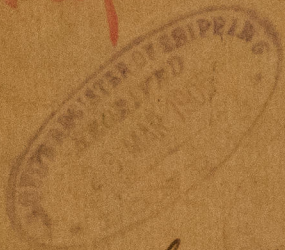

s/s Lord Curzon
Hall Report n. 17159

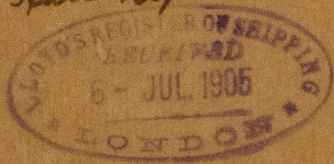


Beam 2 to fore deck
4 x 8 x 8 in all +

STEEL D. $\frac{5}{16}$

KNIFE LINE

Fore

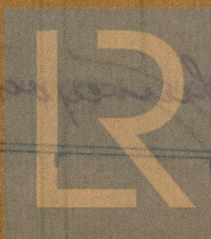

© 2021

Lloyd's Register
Foundation

008679-008690-0017