

M.V. "KOSEI MARU"

Nagasaki Report No.1882.

M.S. "KOSEI-MARU."


435'-0" x 58'-6" x 32'-10"

MIDSHIP SECTION.

SCALE $\frac{1}{4}$ " = ONE FT.

LLOYD'S CLASS \star 100 A. I.

(FINISHED PLAN)

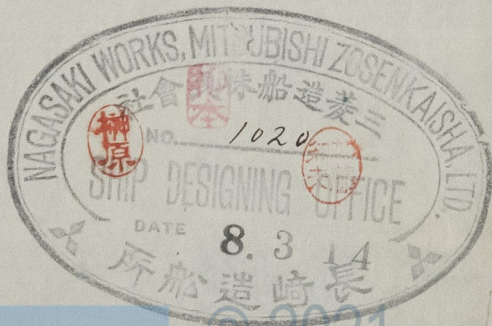

H. Kibara
26. 6th 1933

00369-008649-0003



© 2021

Lloyd's Register
Foundation

008649-008649-0003