






APPROVED

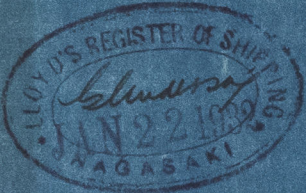

S. No 522

435'-0" x 58'-6" x 32'-10"


MIDSHIP SECTION

SCALE  $\frac{1}{4}$ " = ONE FT.

LLOYD'S CLASS + 100A.1


**'KOSEI MARU'**

*May 1882*

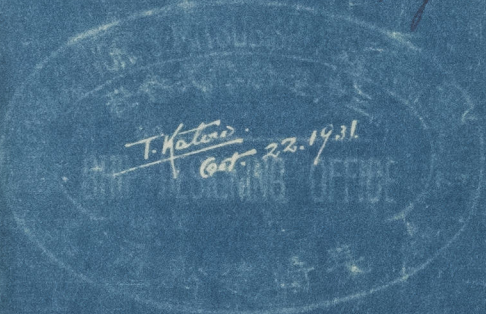

*6/11/31*

GEN. BOX No 1154

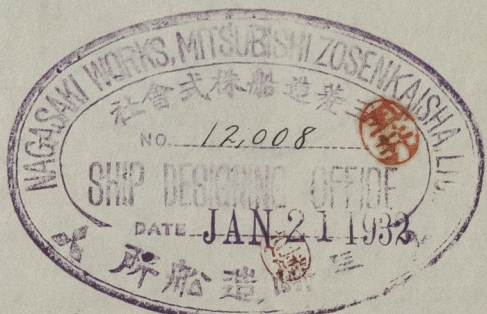

© 2021

Lloyd's Register

008 59140086 94-0004