




14.7.10
28.7.10
19.8.10
7.9.10
12.9.10
19.11.10
24.2.11

No 559 S. P.
380 - 53-3 MP - 29-b


1/8" = 1 ft.

To CLASS 100 Al Lloyds



PATENT CANTILEVER TYPE

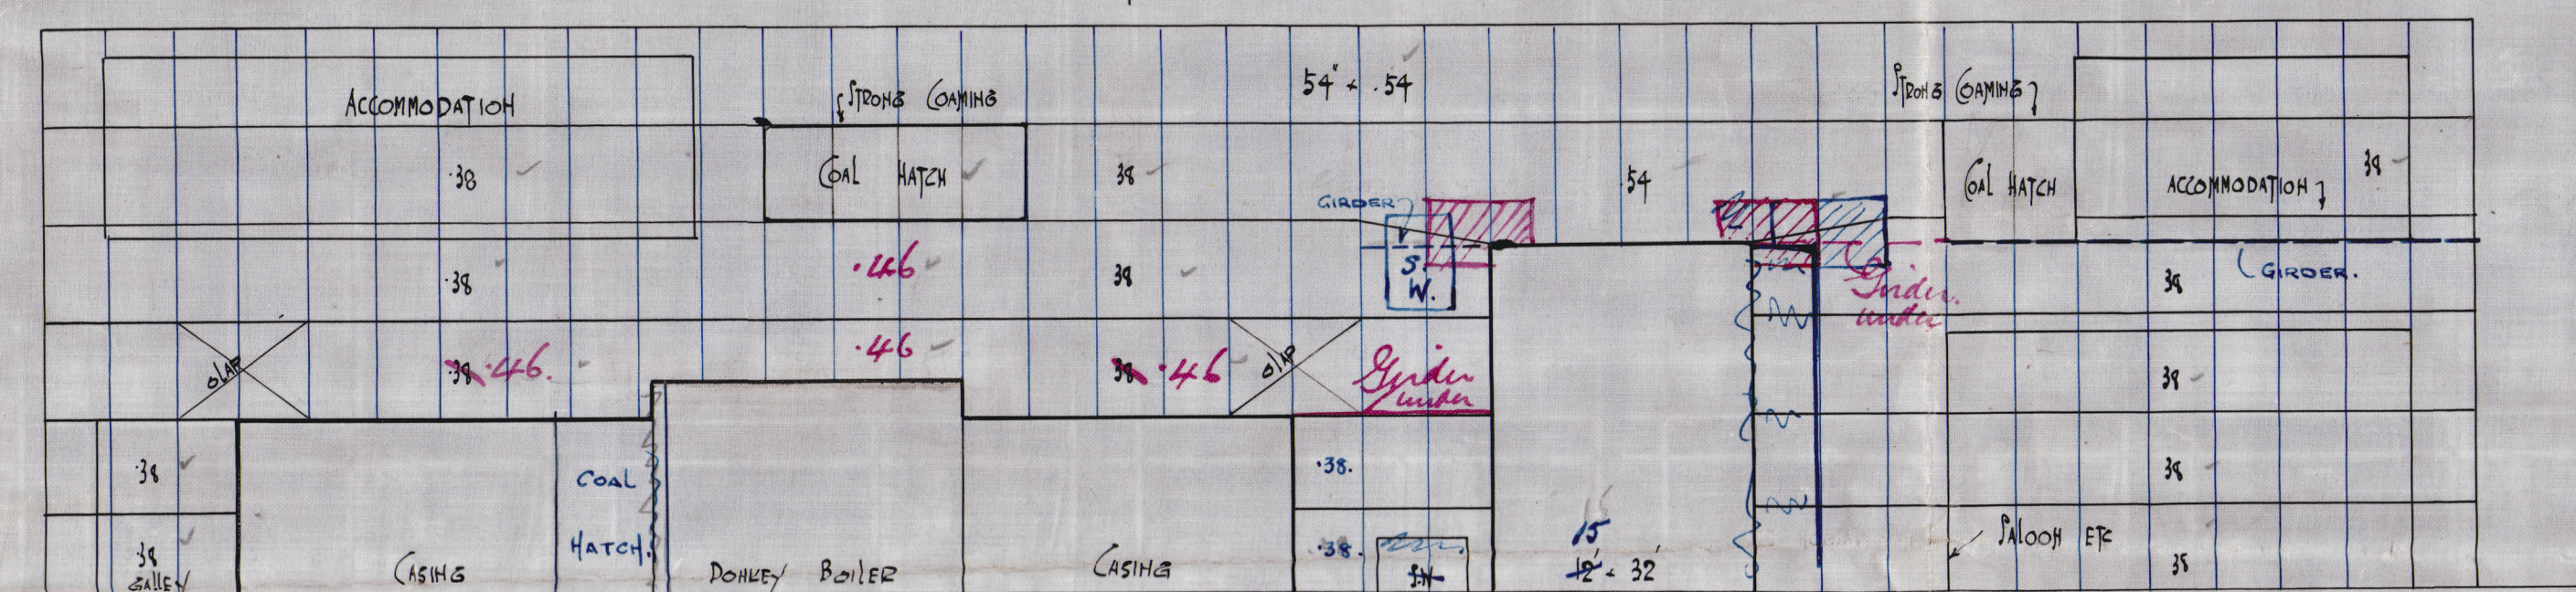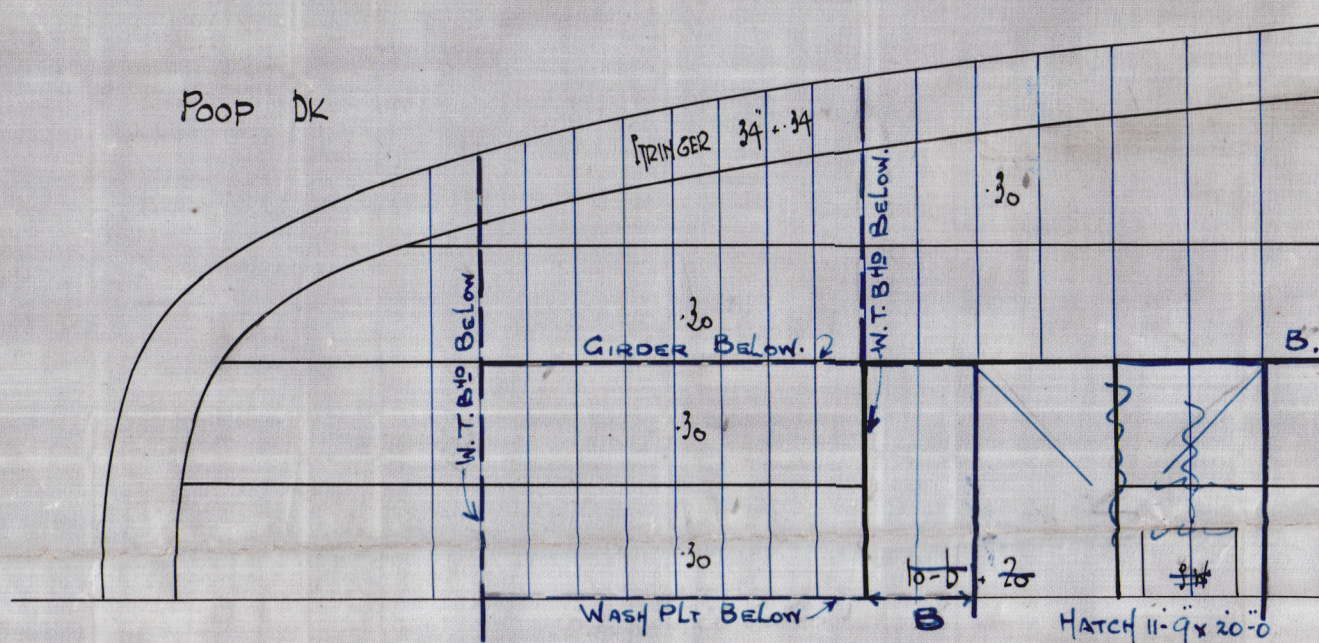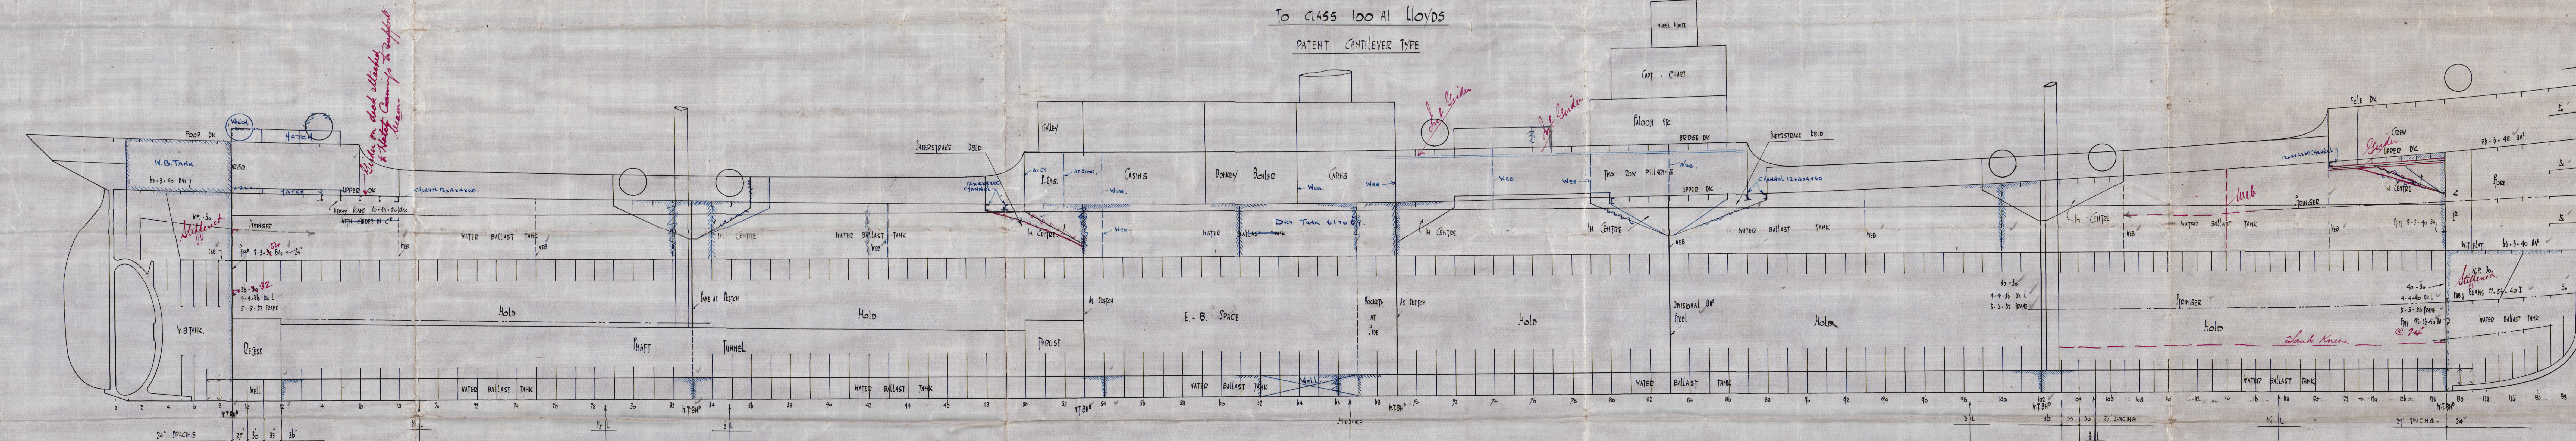

BRIDGE DECK

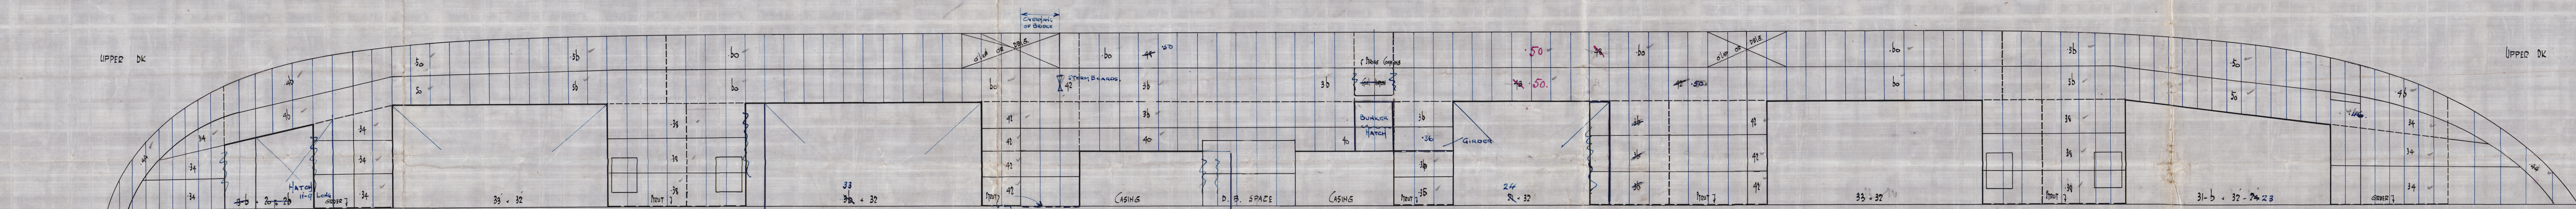

SKETCH OF MIDSHIP BULKHEADS

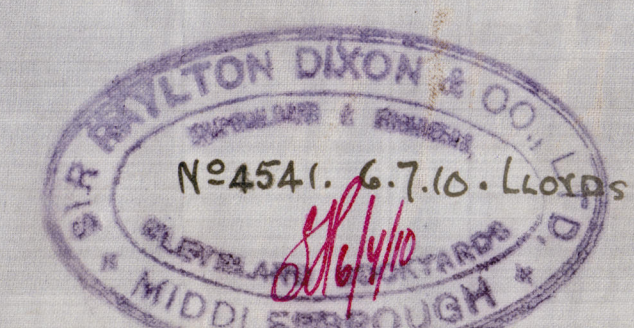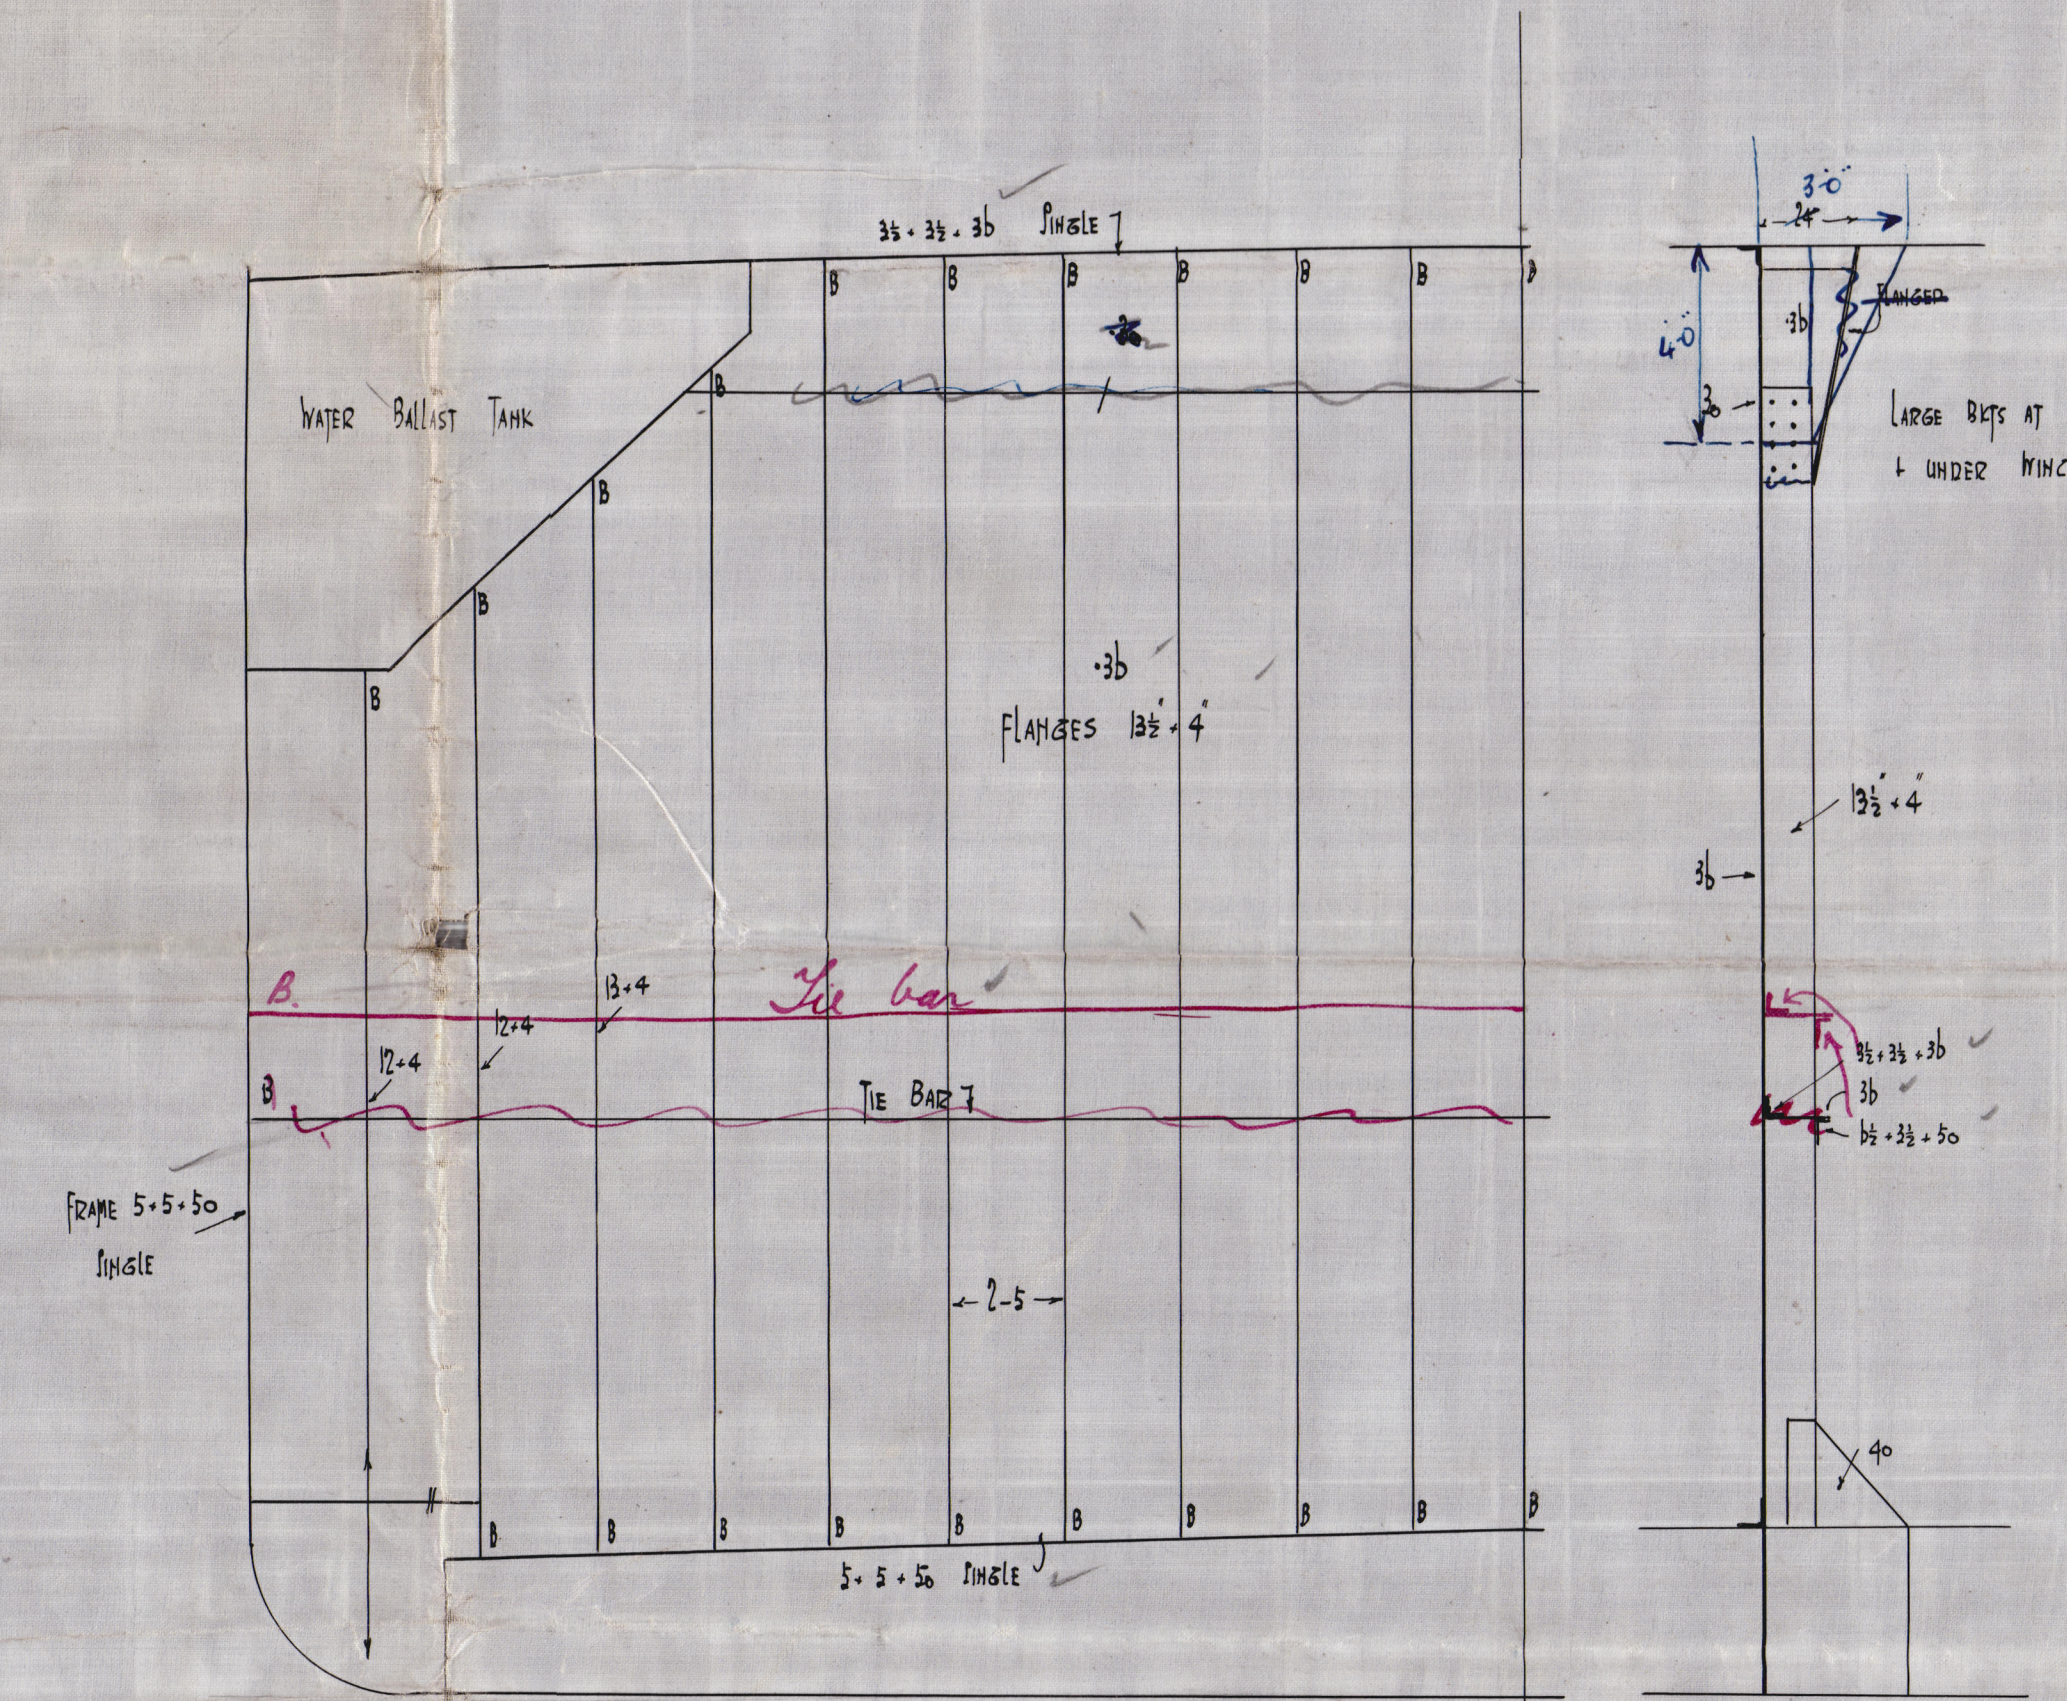


© 2021

No 539

Profile & Deck Plans

"Kinkasan Maru"
Inst. Report 1881

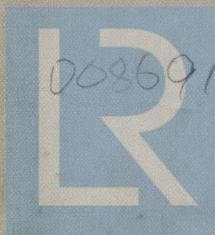

© 2021

008691-008699-0079

Lloyd's Register
Foundation