


21107

No 558. 99

380. 53.3. 26



$\frac{1}{2}$ 17

DEPTH AMIDSHIPS $29-0 + \frac{1}{2}$ SHEER = $29-7\frac{1}{2}$

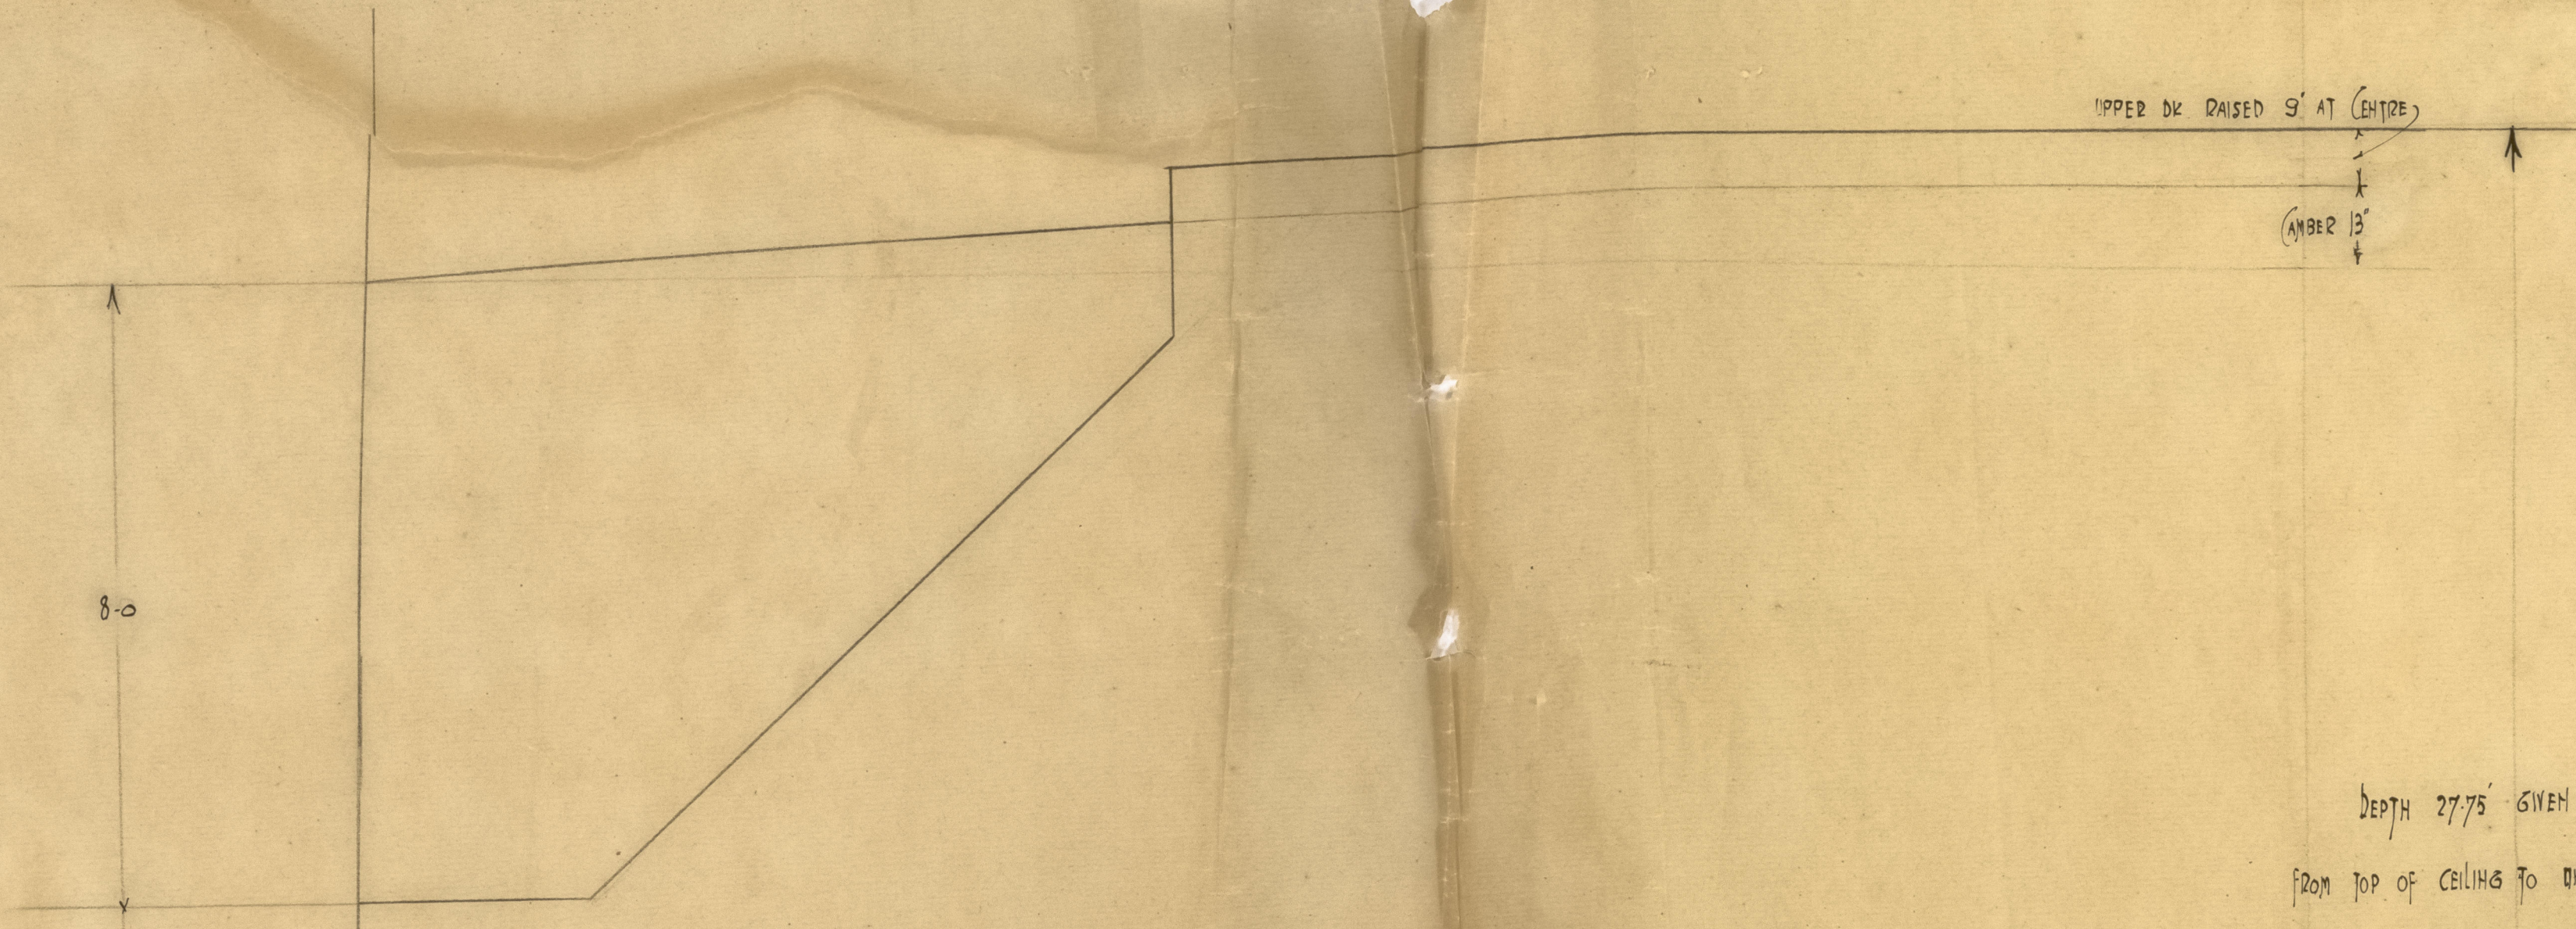

DEPTH 27-75' GIVEN IS
FROM TOP OF CEILING TO UNDERSIDE OF
RAISED DECK AT CENTRE

DEPTH IS .75 LESS TO NORMAL
CAMBER LINE

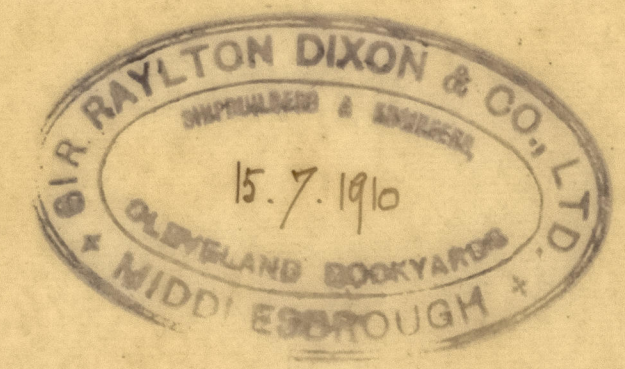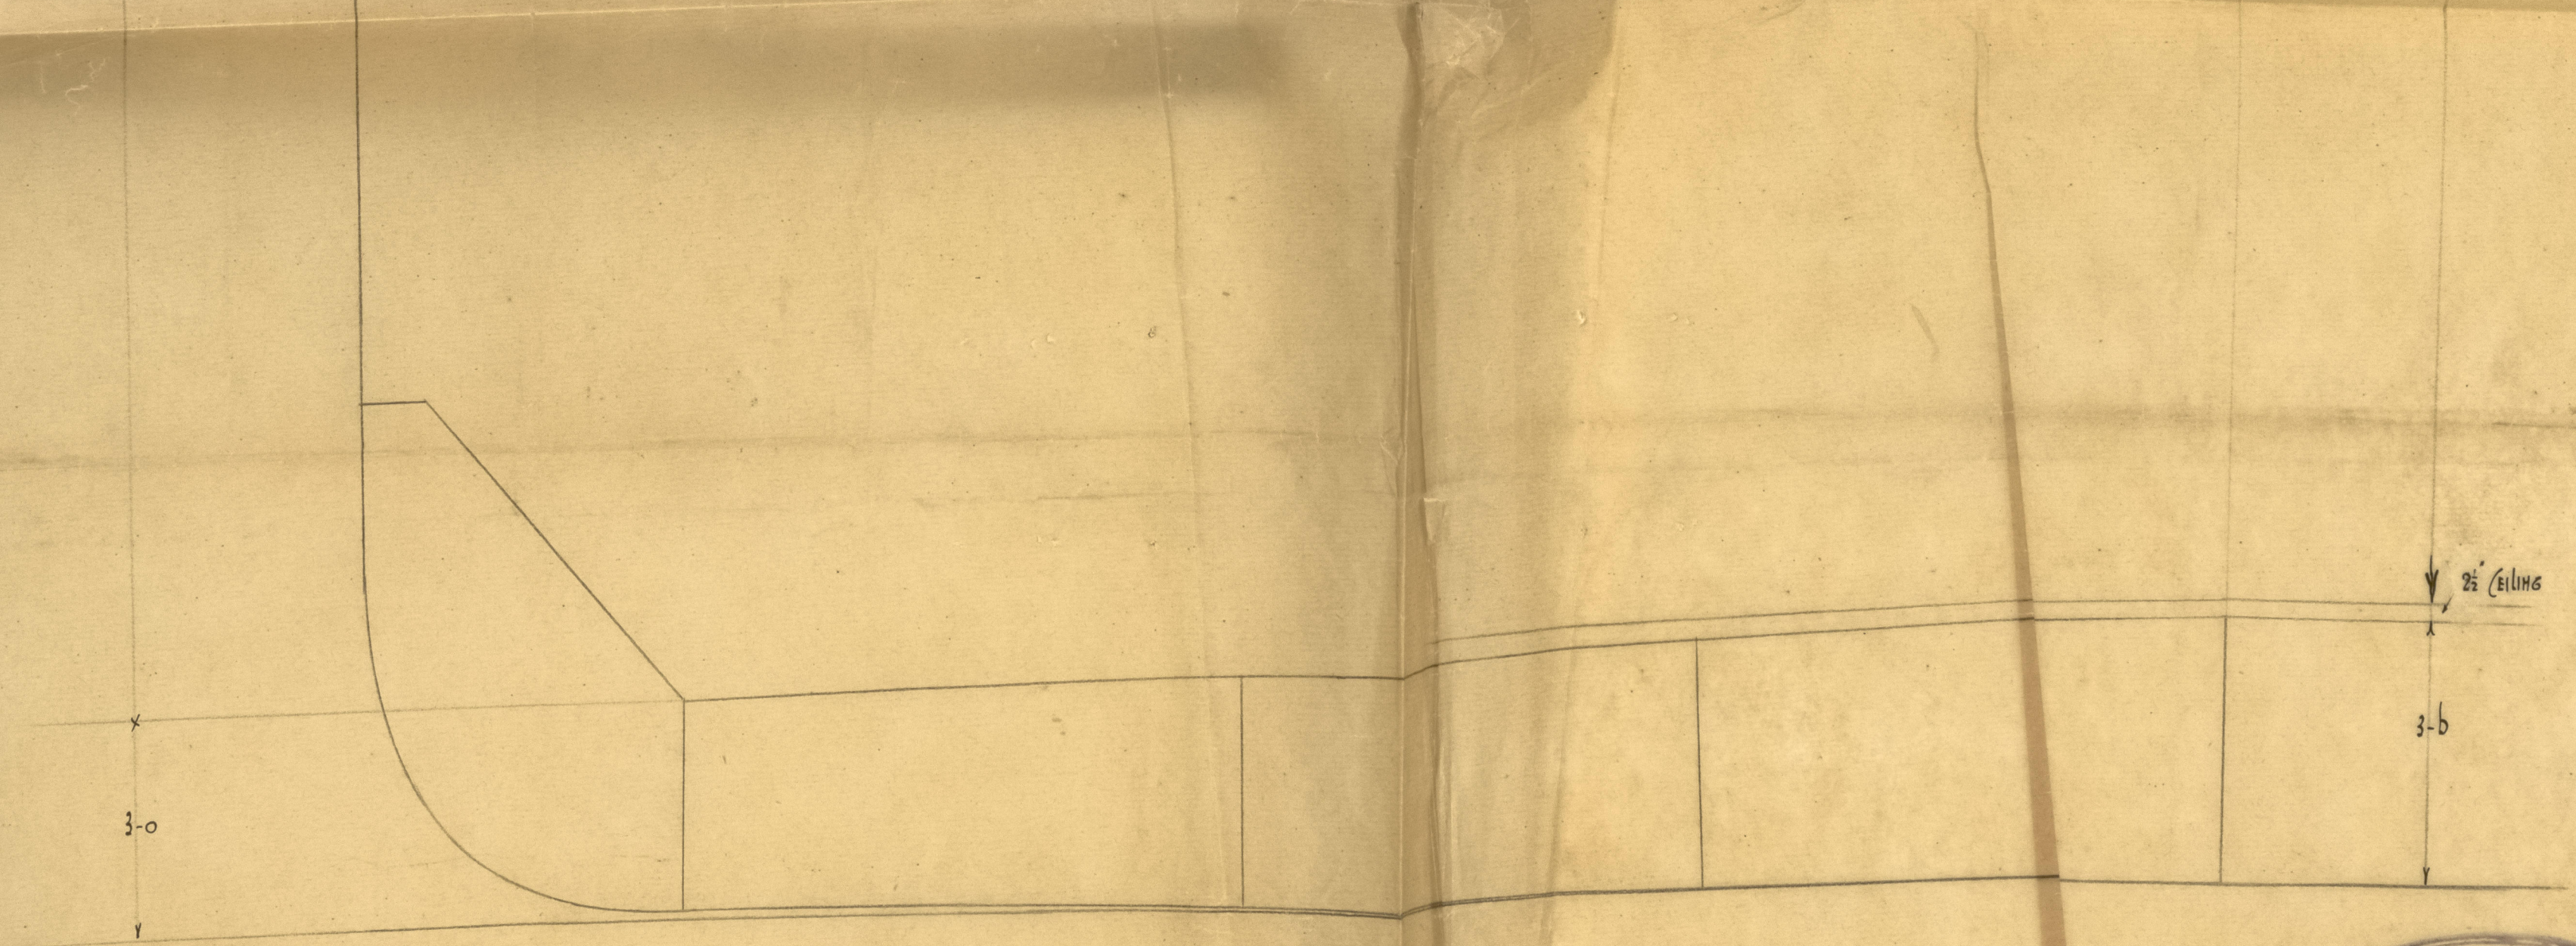

2110°


ng.

ugh

27-82



 





© 2021

Lloyd's Register
Foundation

[P.T.O.]

14/7/10.

See p L Thompson 481