


TO CLASS LLOYDS A.1 "PILOT STEAMER"

SCALE  $\frac{3}{4}'' = 1$  FOOT.

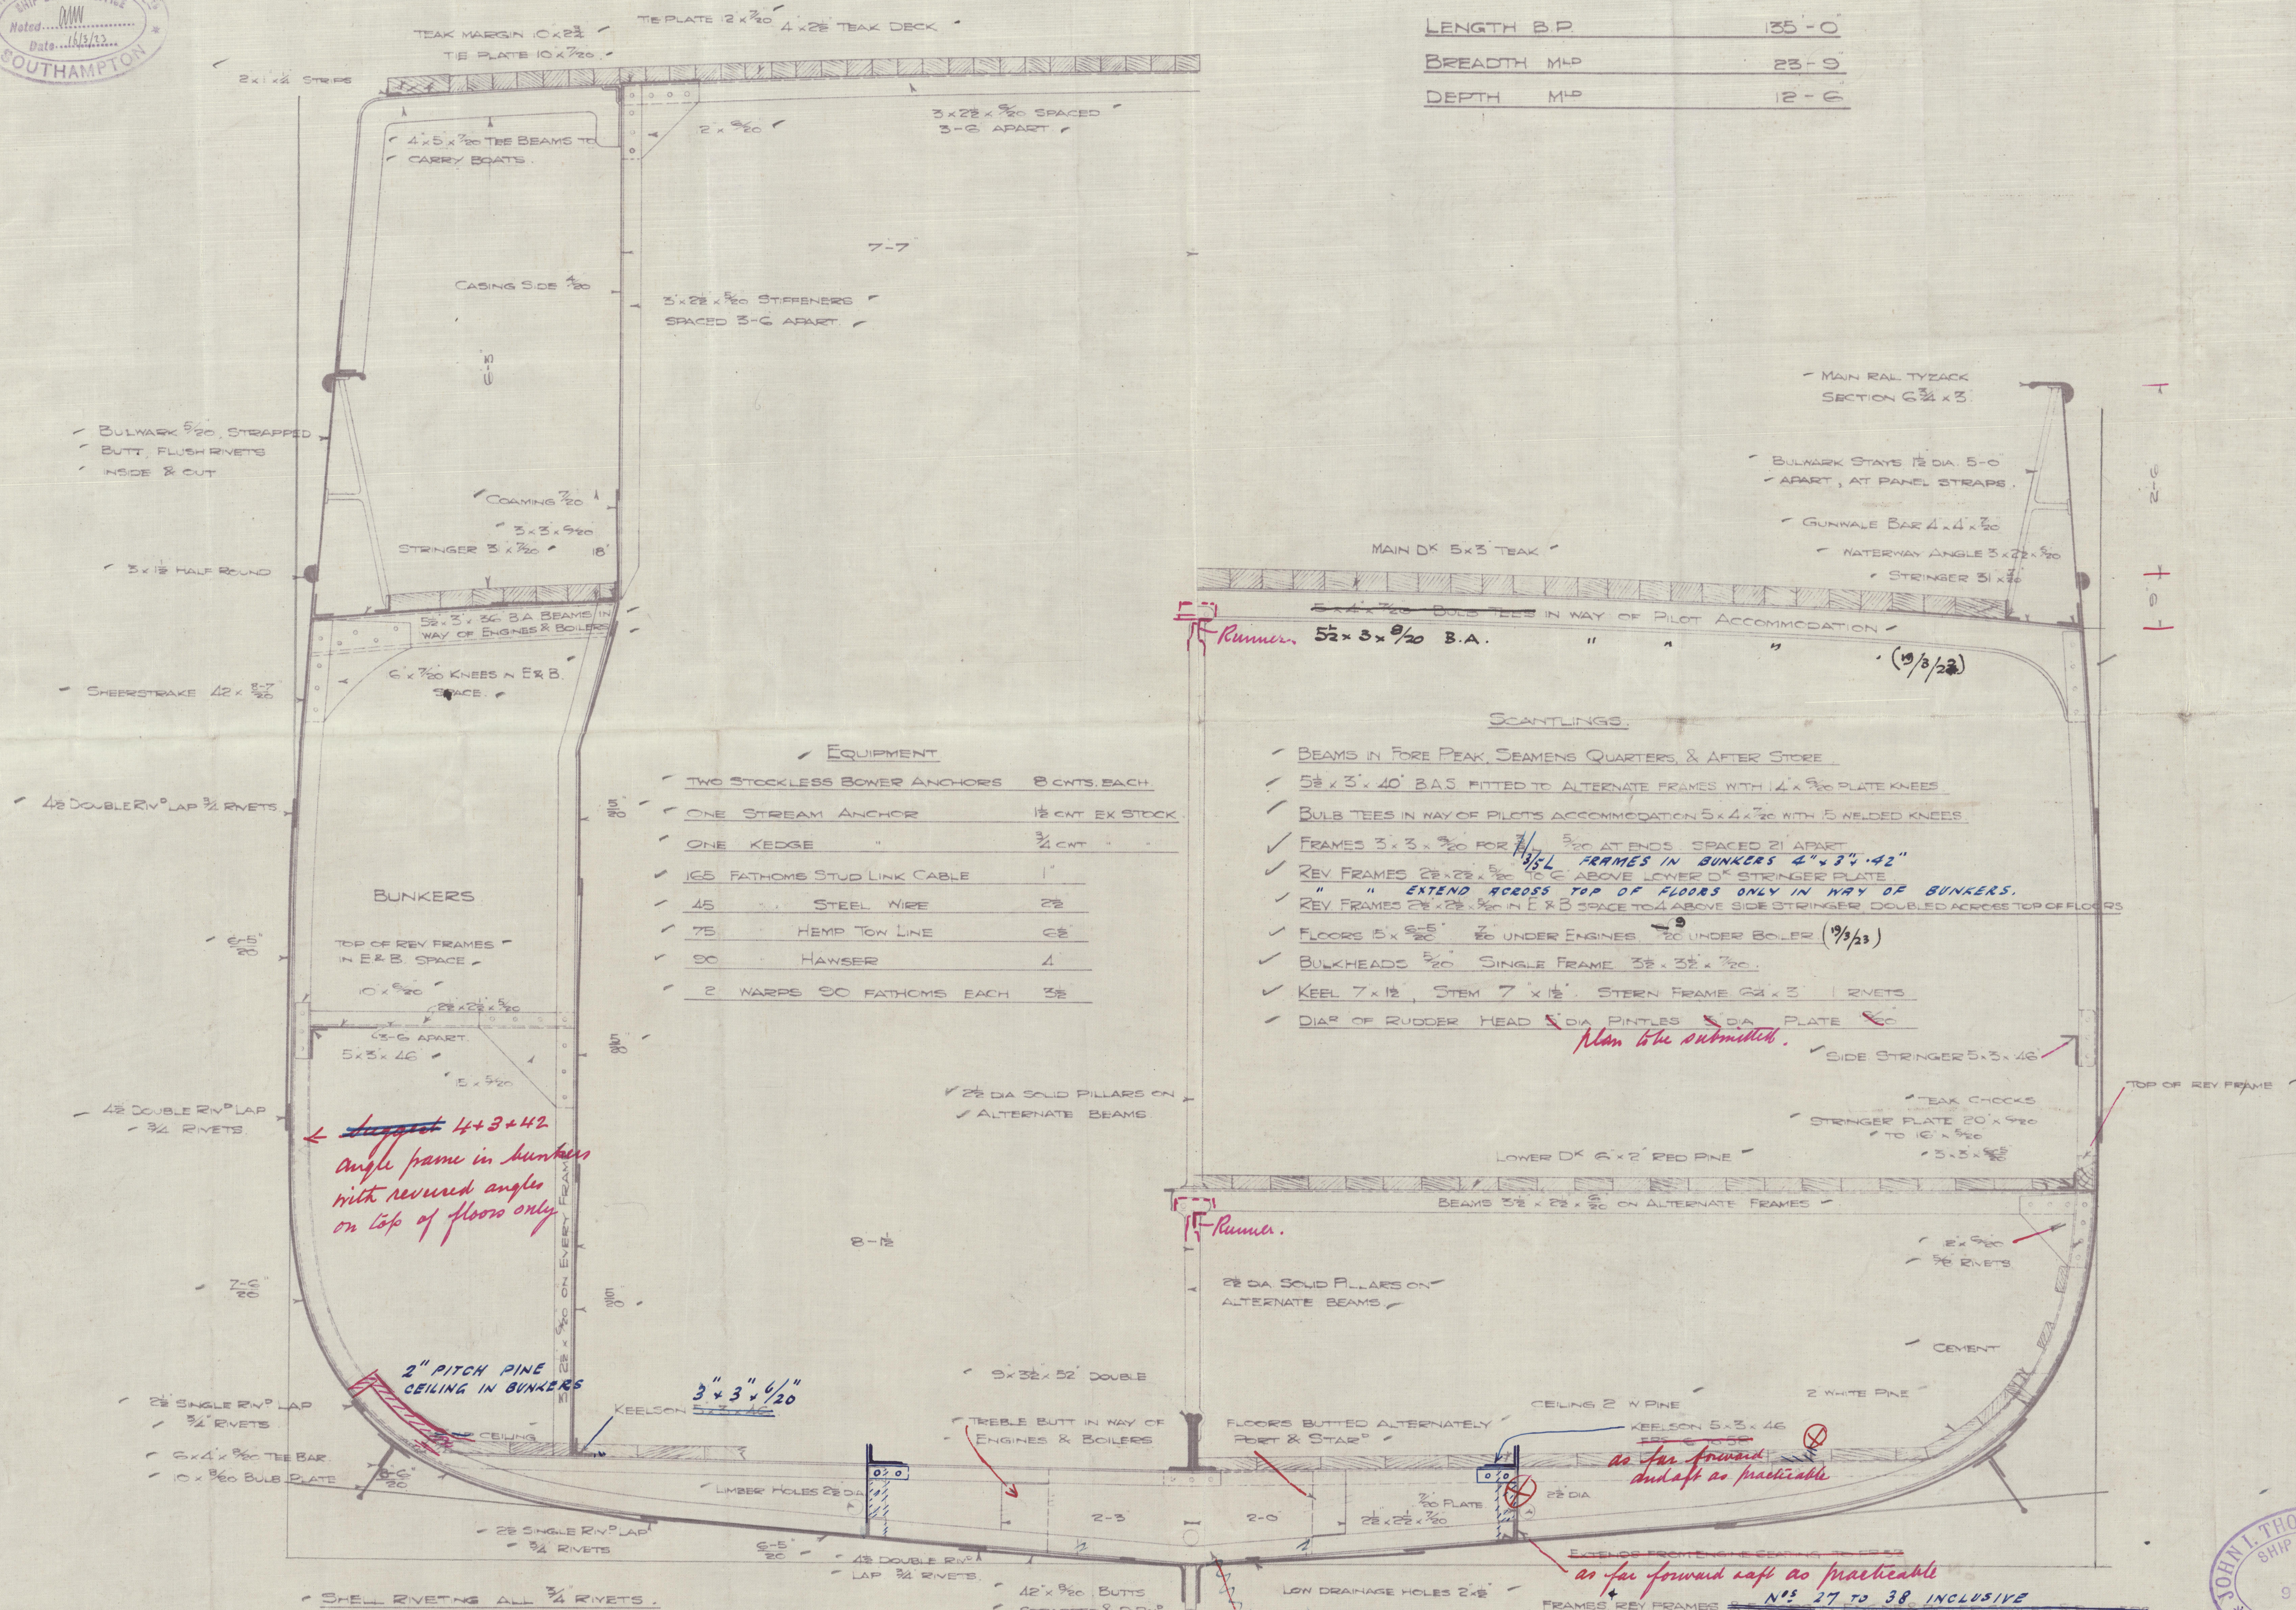

1028.

JOHN I. THORNYCROFT & CO. LTD.  
SHIP DEPARTMENT  
9 MAR 1923  
SOUTHAMPTON

77/23



Messrs Thornycroft & Co. Ltd.  
Southampton.

Mid. Section "Pilot Steamer."

Pioneer

Serial No.



© 2021

Lloyd's Register  
Foundation

008700-008710-0232