



"INDIRA"

The freeing port area has now been increased
per sketches below.

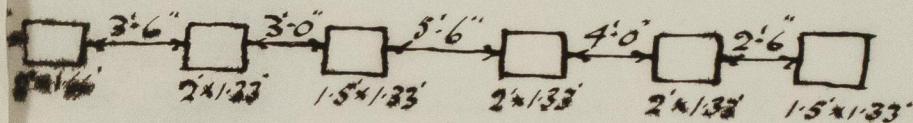

FORWARD WELL :- AREA 15.28 sq

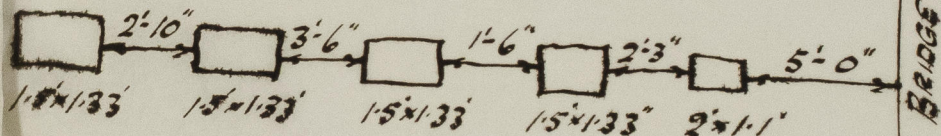

AFTER WELL :- AREA 10.2 sq

horizontal bars fitted to
the freeing port.

BD.
7.11.35.



© 2021

Lloyd's Register
Foundation

008700-008710-0292