




LOOKING FORWARD FR. 33.

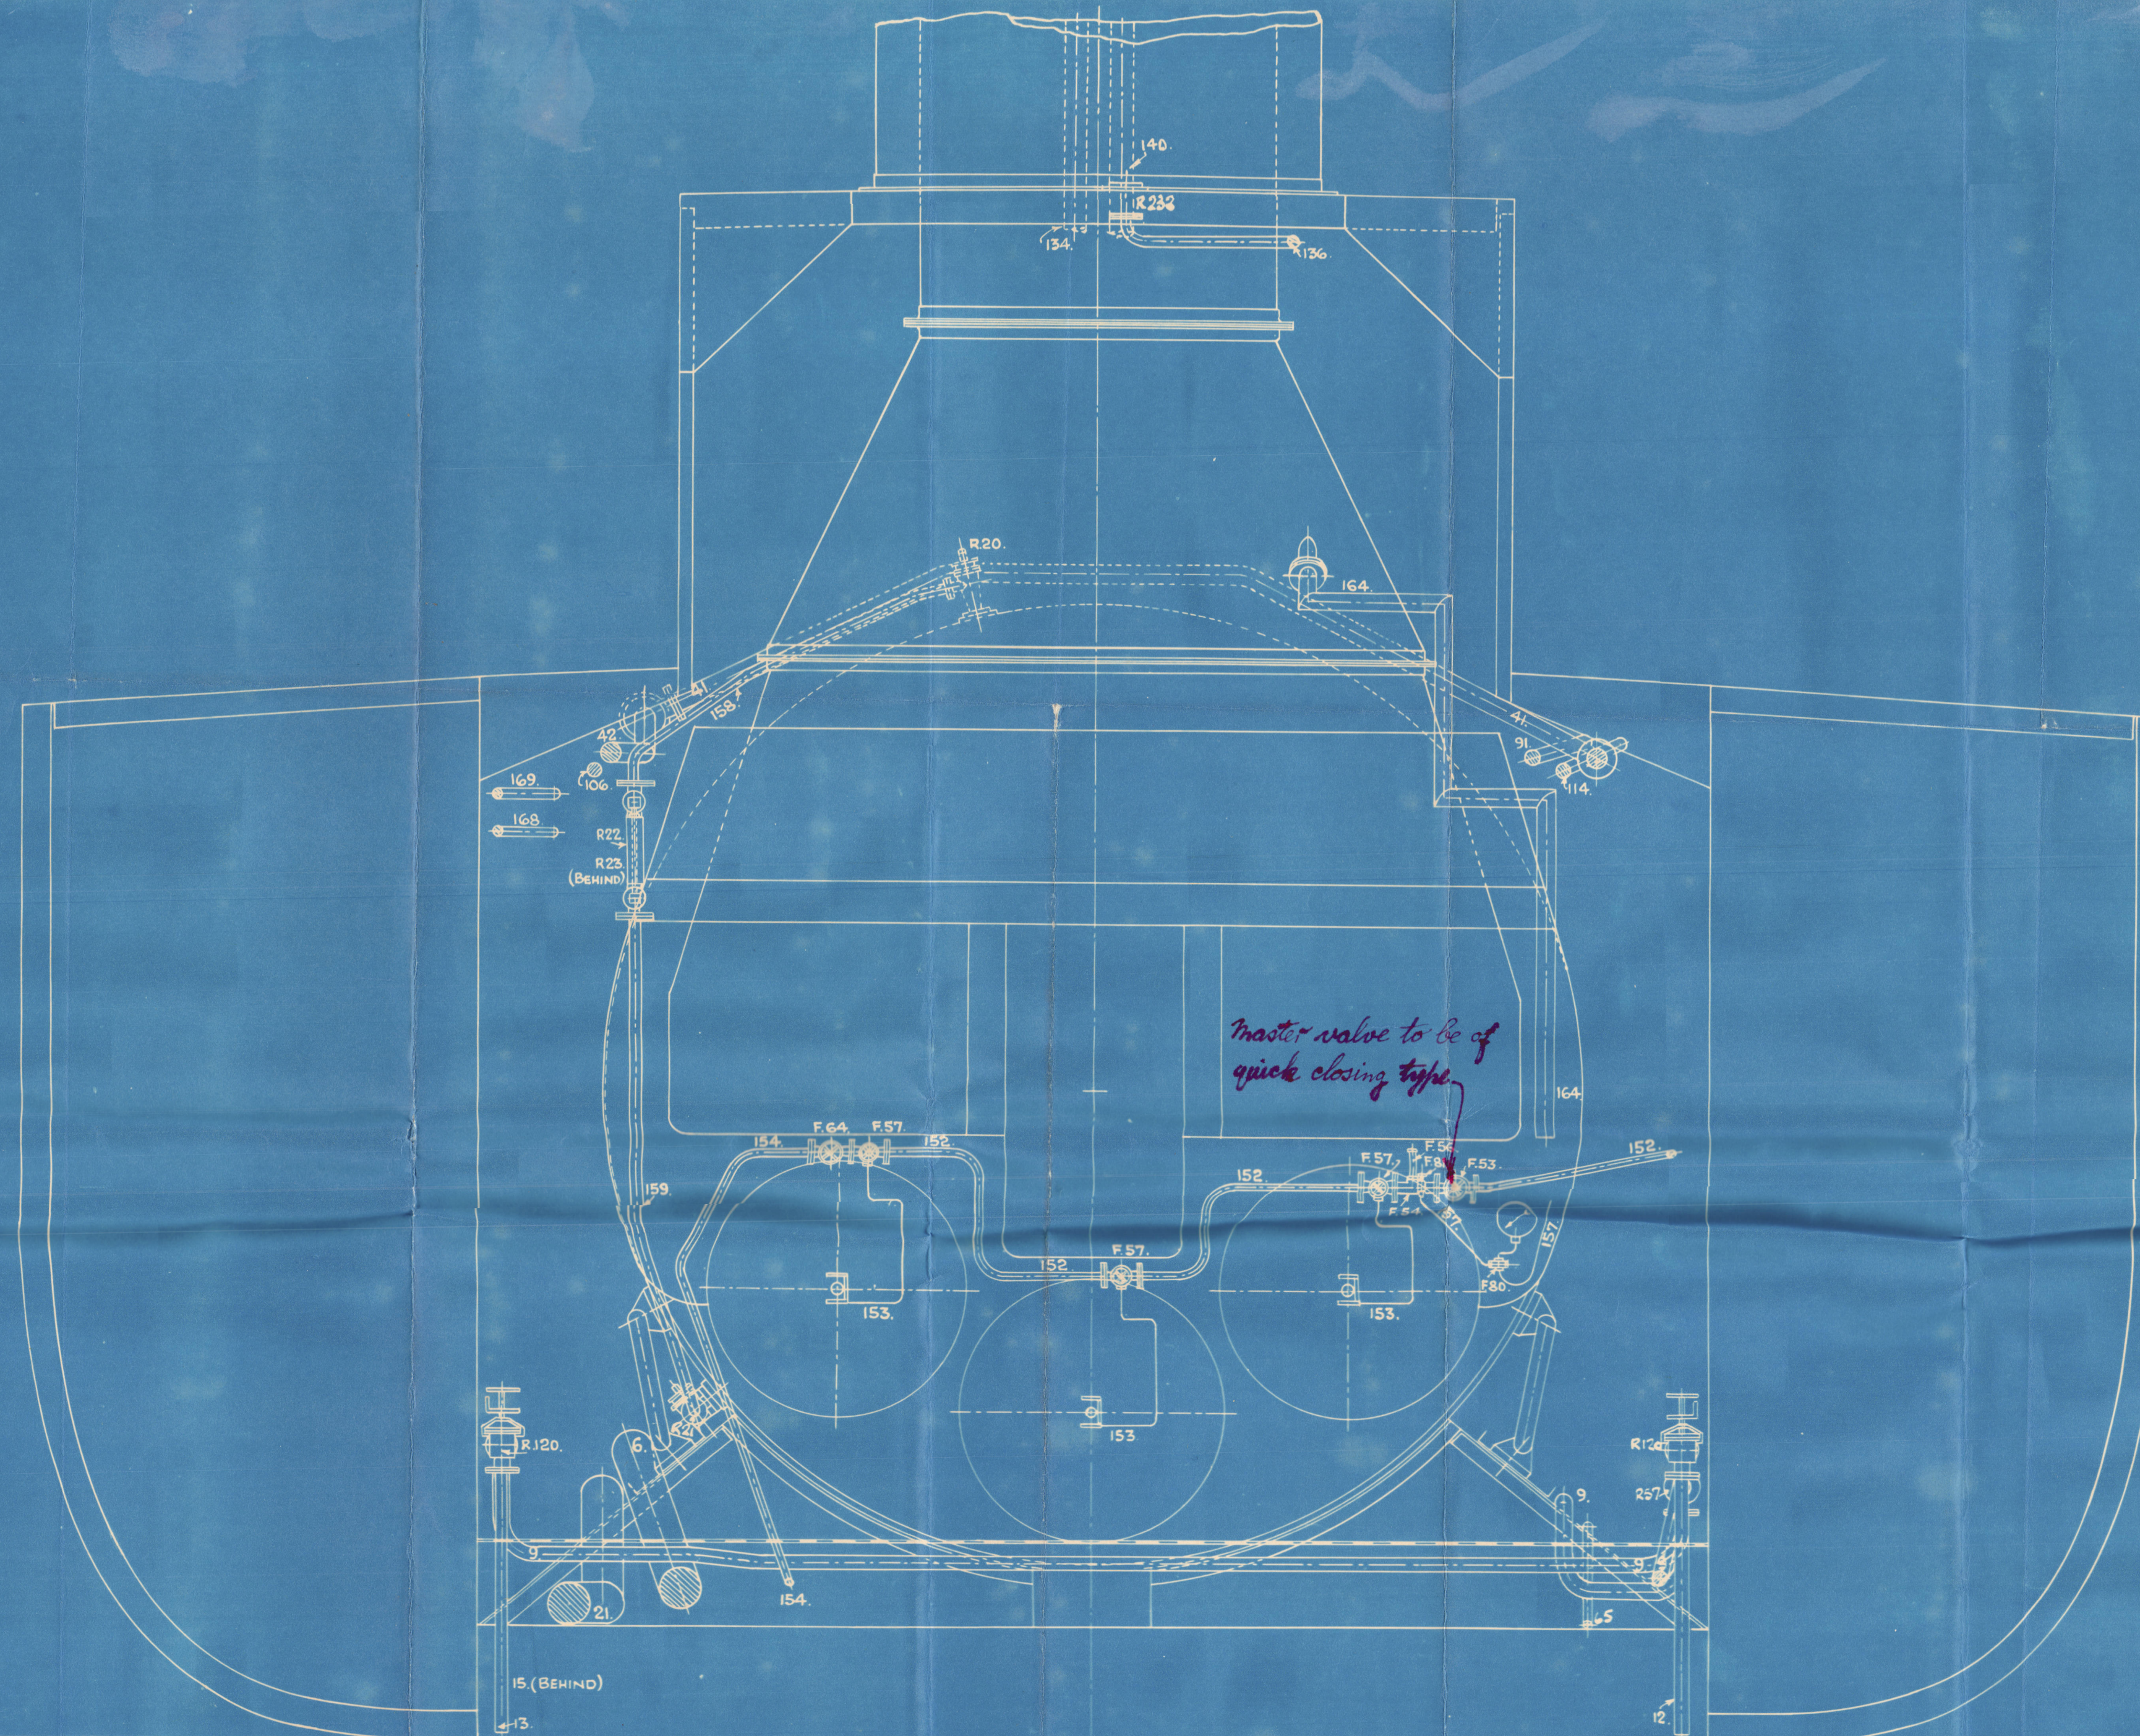

LOOKING AFT FR. 33.

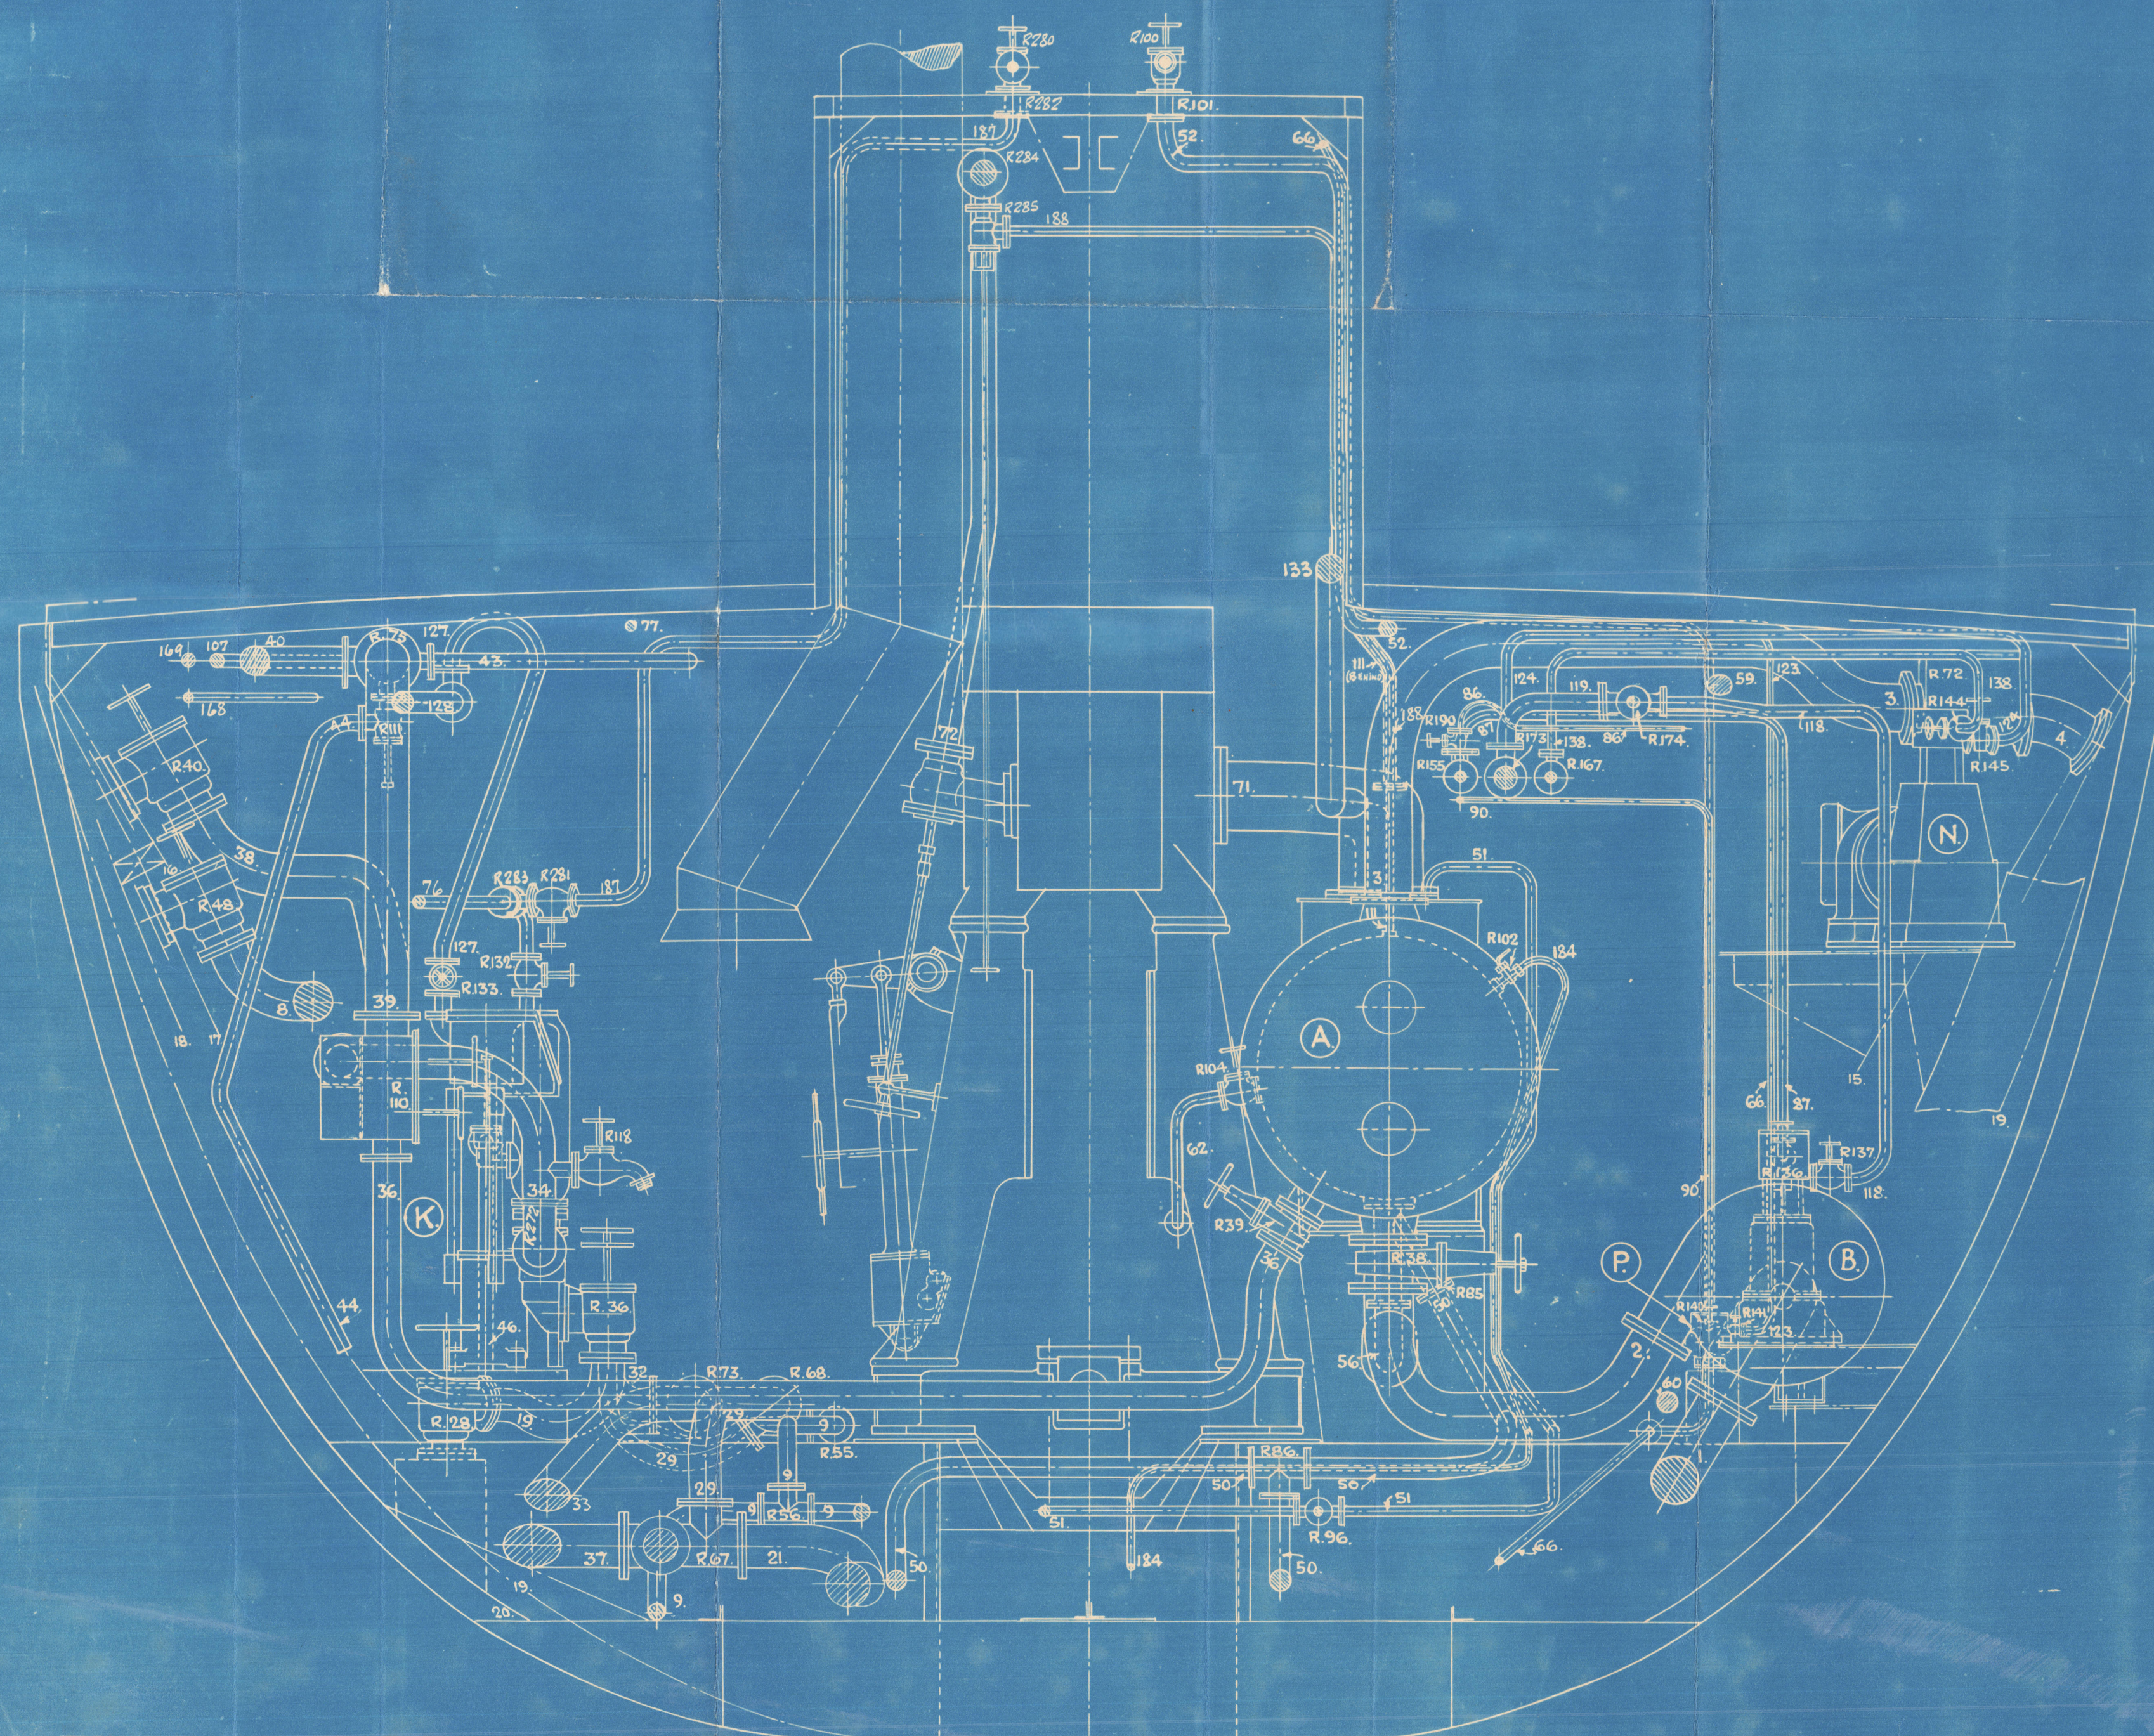


LOOKING AFT FR. 21.

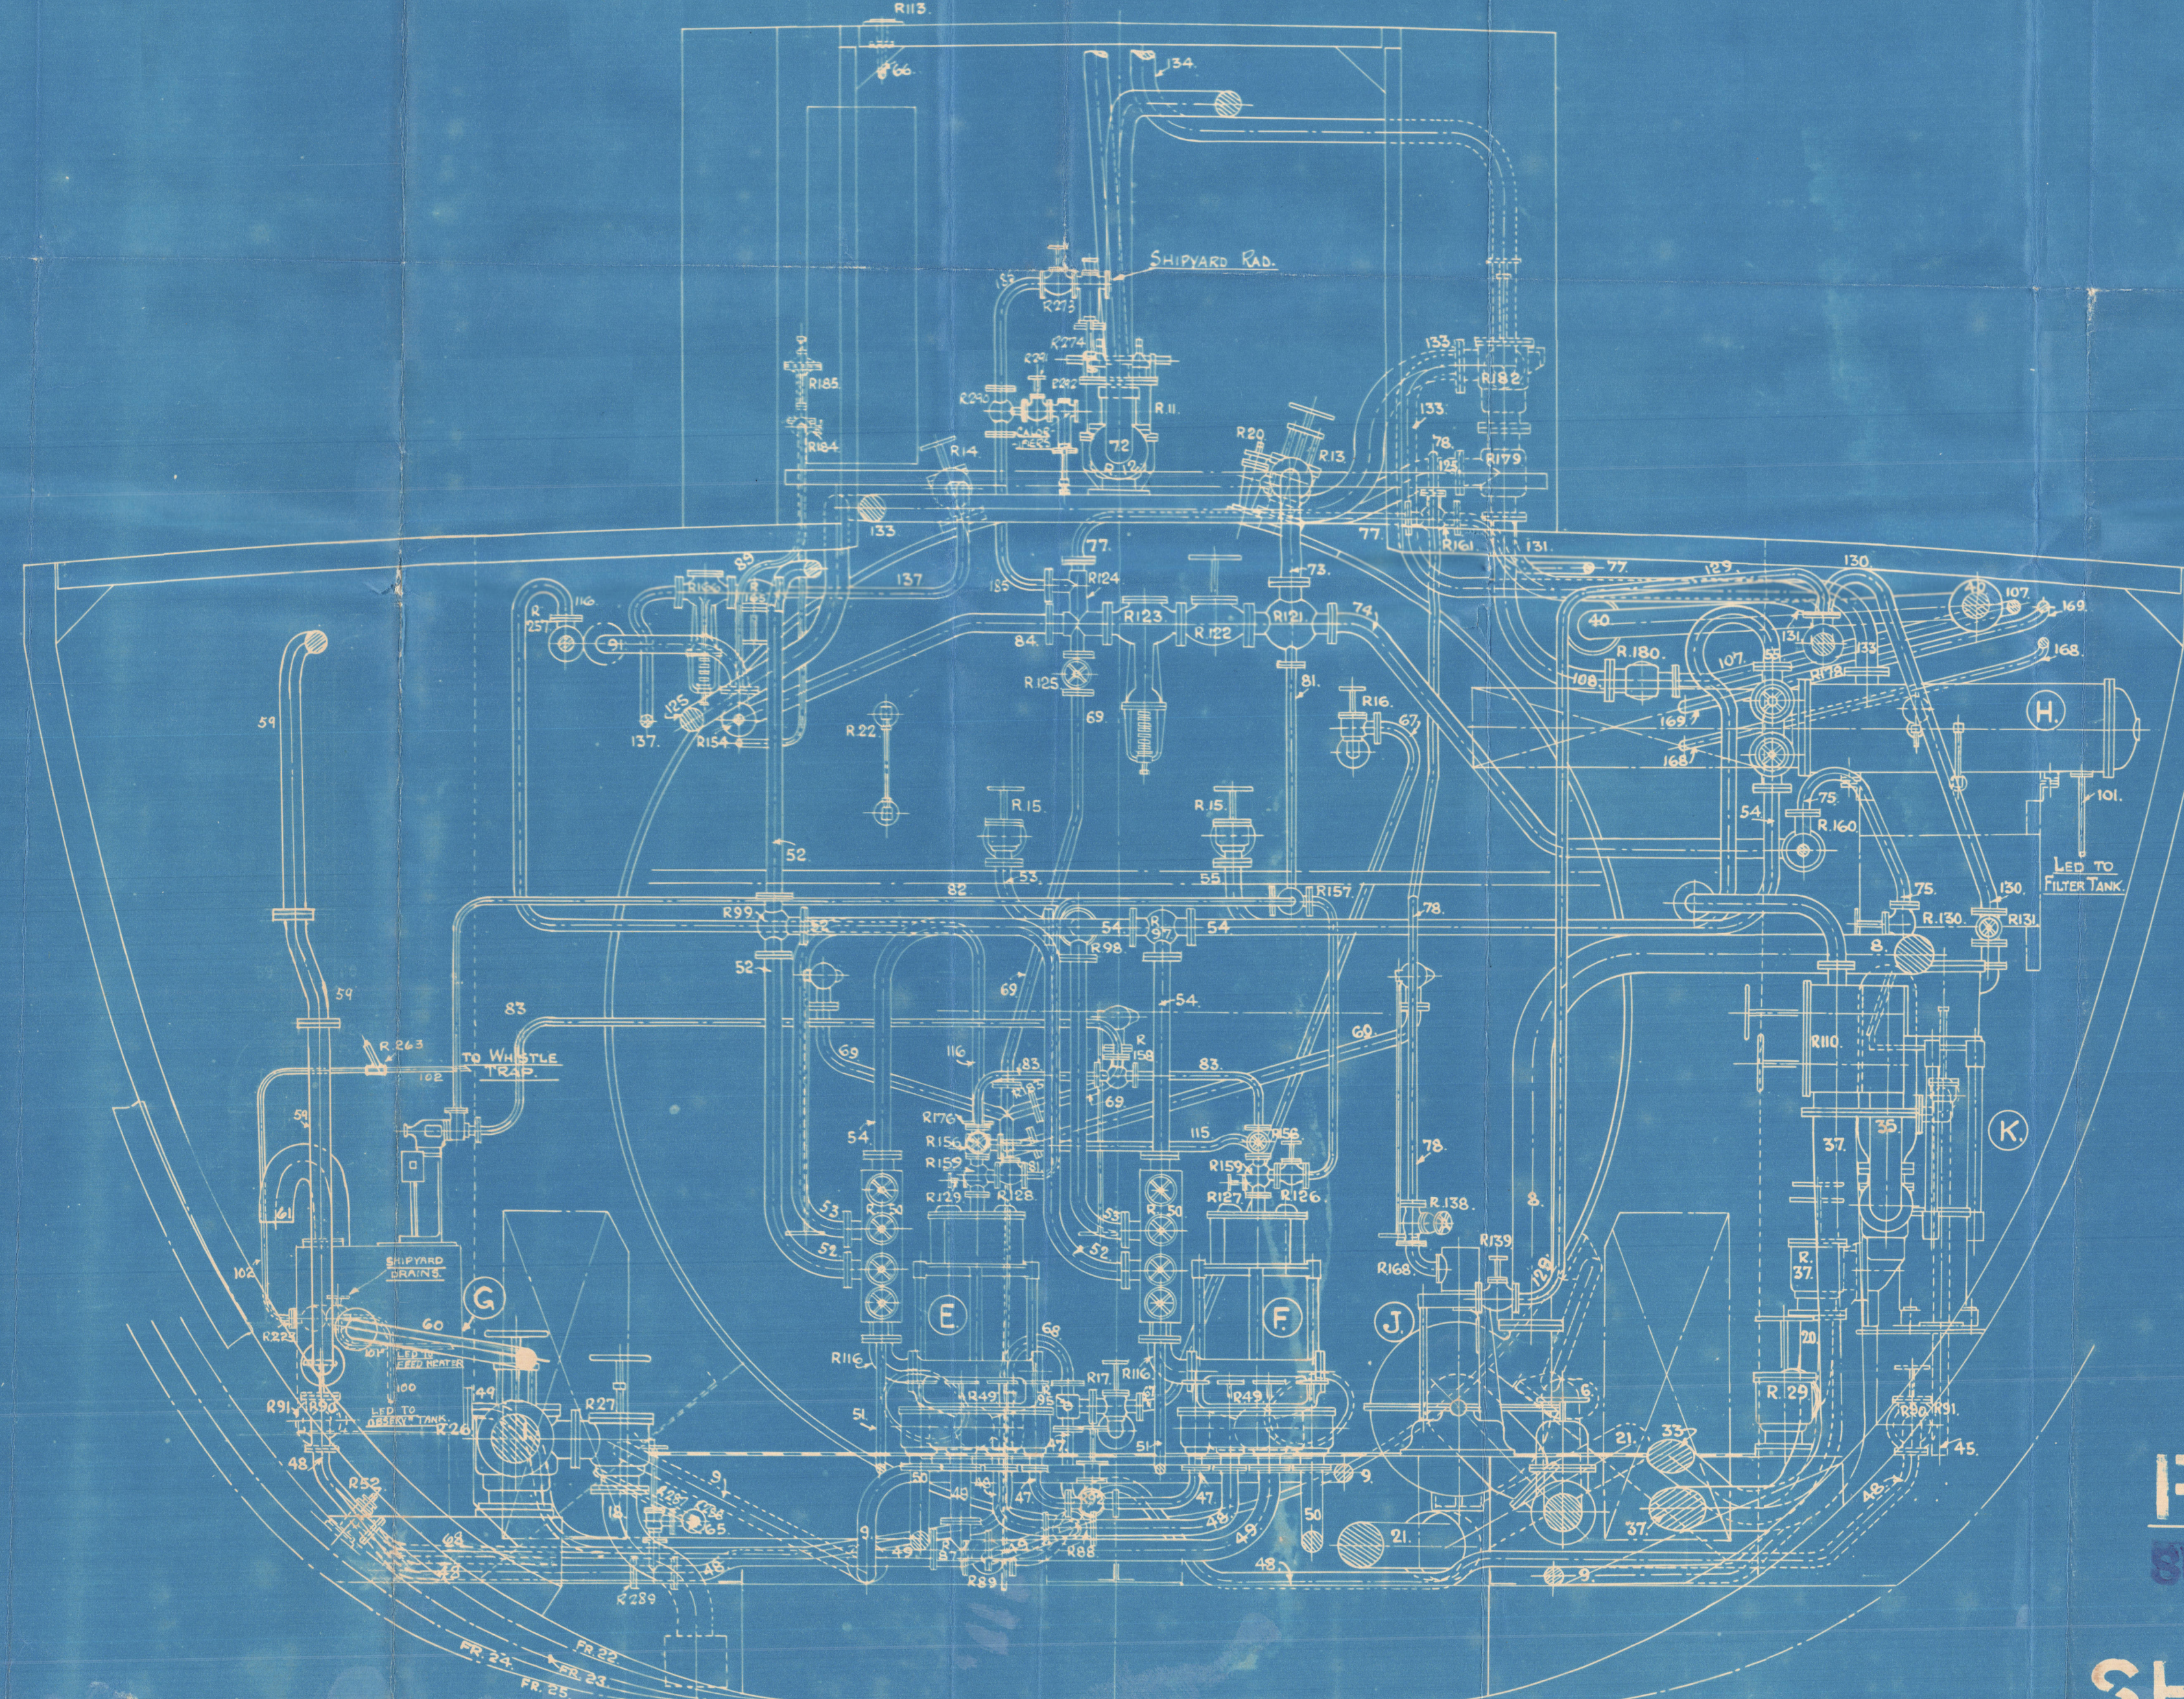

LOOKING FORWARD FR. 21.

APPROVED
LLOYD'S REGISTER OF SHIPBUILDERS
THE BRITISH COORDINATION REGISTER
J. Carson
Date 6.2.52
WHL

FERGUSON BROS
(PORT GLASGOW) LTD
SHIPBUILDERS & ENGINEERS
9 - 10 - 50

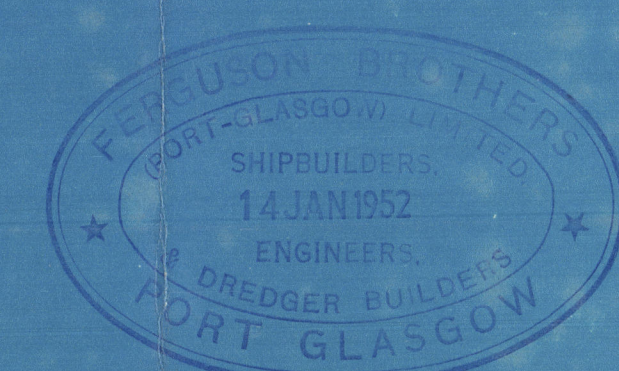


Nº 397-408
PIPE ARRANGEMENT.

SURVEYOR'S COPY.
SCALE:- 2" = ONE FOOT.

SHEET Nº 3. 3 SHEETS.

008720-008727-0022

© 2020
Lloyd's Register

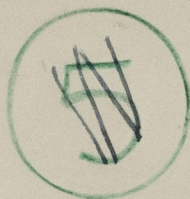

"J.P. WEBB" ★

PERMANENT BERT (P.C.) LTD.

SHIP X C.N. NO 408


SHIP

ARRANGEMENT.

3 SHEETS. SHEET 3

J. P. Webb
Greenock S.C. Regt 25268

RECORDS DEPT.
LONDON.

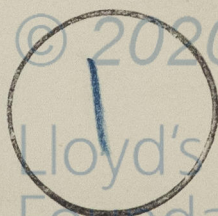

© 2020
Lloyd's Register
Foundation

00 8720 - 00 8727 - 00 22