

© 2020  
Lloyd's Register  
Foundation  
008720-008727-0025



Ferguson Bros (P.S.) Ltd ✓


Tarels No 397 & 408

Rudders & Sternframe ✓

"J. P. Webb" ★

Glenock J. E. Rpt. 24460.

PLANS TRANSFERRED  
TO SISTER VESSEL  
RECORDS DEPT.  
LONDON

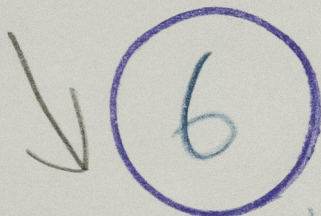


408

"J. P. NEBB"

7/5618

Glenock J. E. Report No 25268

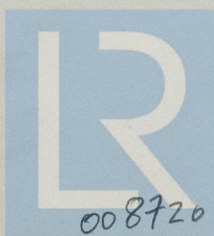

© 2020

Lloyd's Register  
Foundation

008720 - 008727 - 0025