


SHIP N° 227

AMENDED PROFILE





SCALE: 1" = 1/2" = ONE FOOT

ALL BULB ANGLES ARE N.B.S.

FOR DETAILS OF CONNECTION OF HATCH END BEAMS
TO MIDDLE LINE BULKHEAD, SEE PLAN OF DECK GIRDERS & HATCH
END BEAMS

 

PLAN N° P. 14.

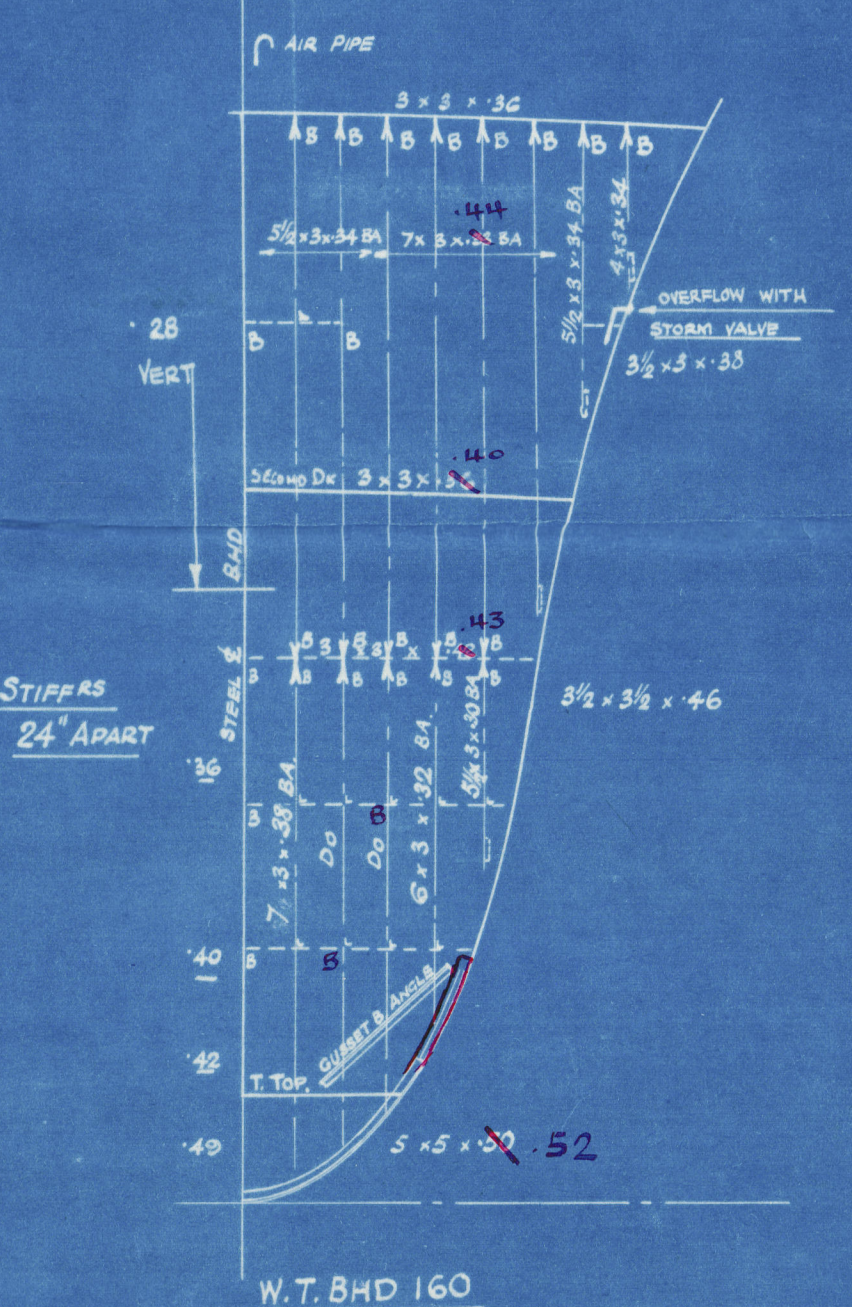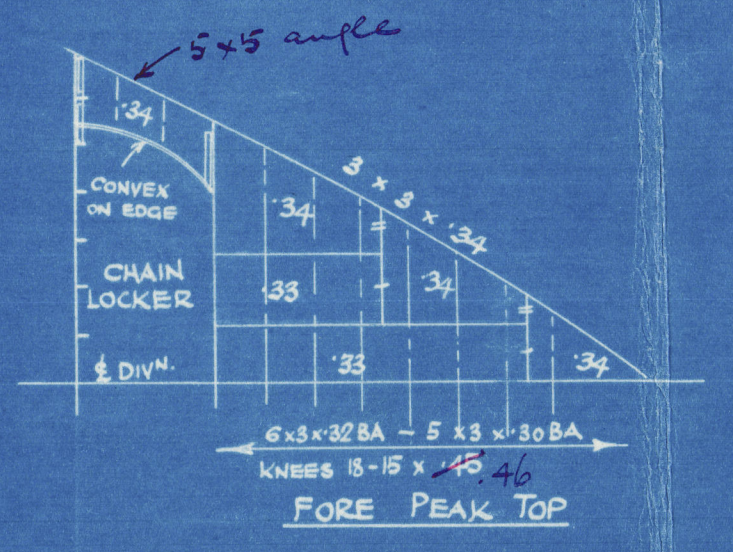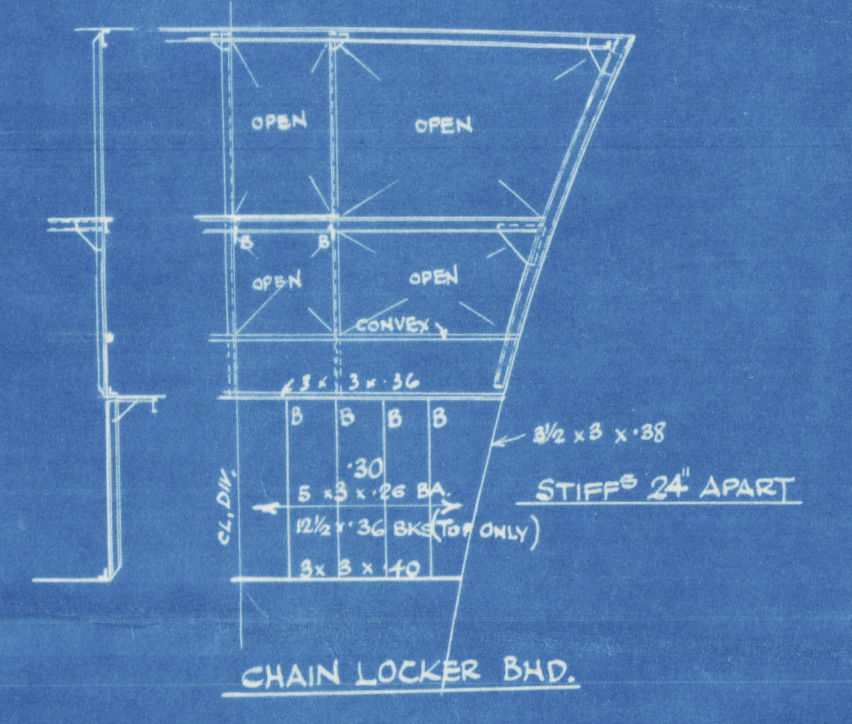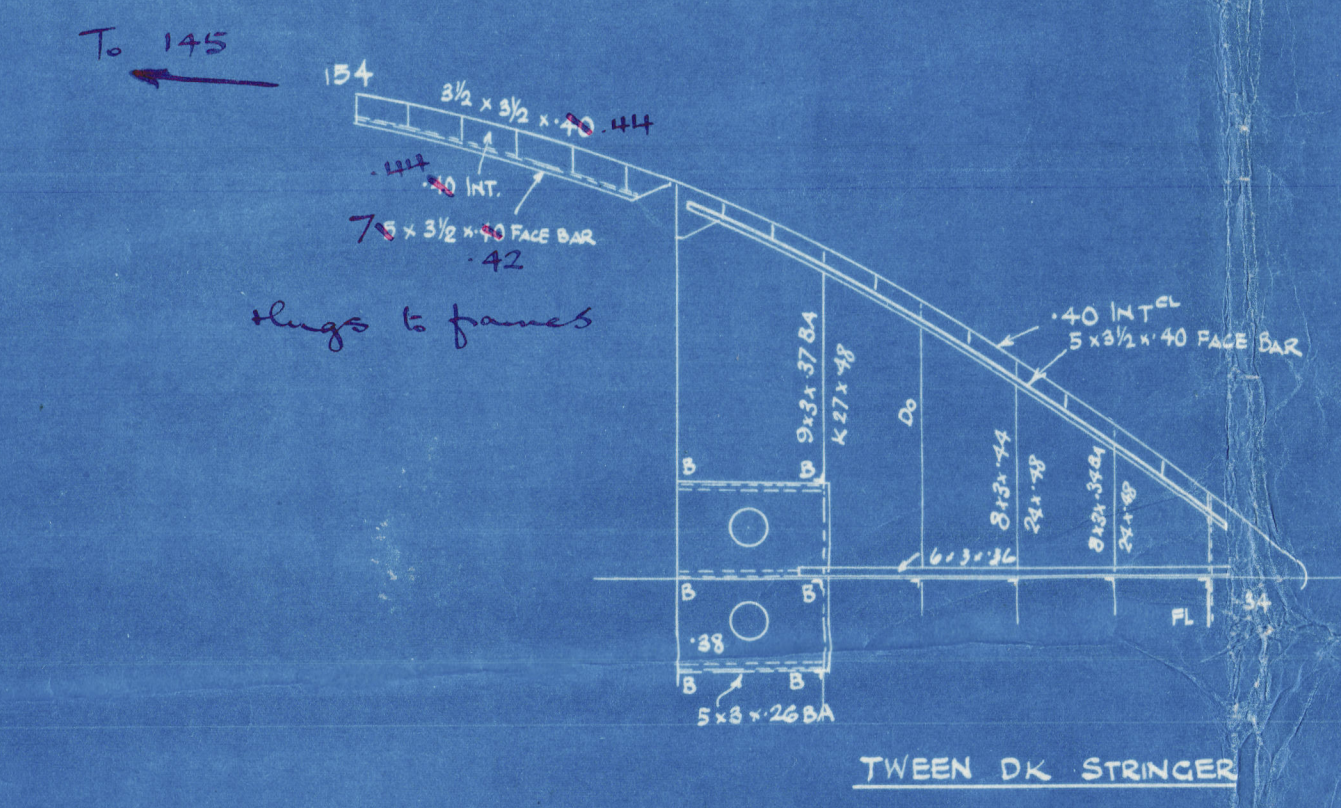


BURNTISLAND B.B.C. 20

N^o 227

Amended Profile

4/5 Cefu-Y-Bryn


Lt Rpt. No 19912

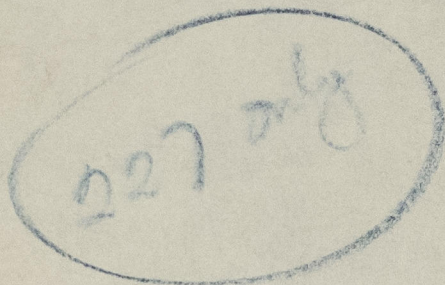

CAMBURA

N/N - HONGKONG MARU

M/M. 8735

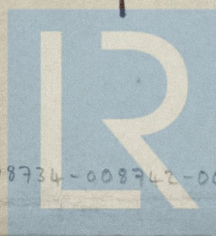

© 2020

Lloyd's Register
Foundation

008734-008742-0019

89