



TABLE FOR ELECTRIC WELDING		
	FULL WELD SINGLE CONTINUOUS	
	FULL WELD DOUBLE CONTINUOUS	
	FULL WELD ZIG ZAG INTERMITTENT	
	BUTT WELD CONTINUOUS	
	FOR UNION MELT WELD	

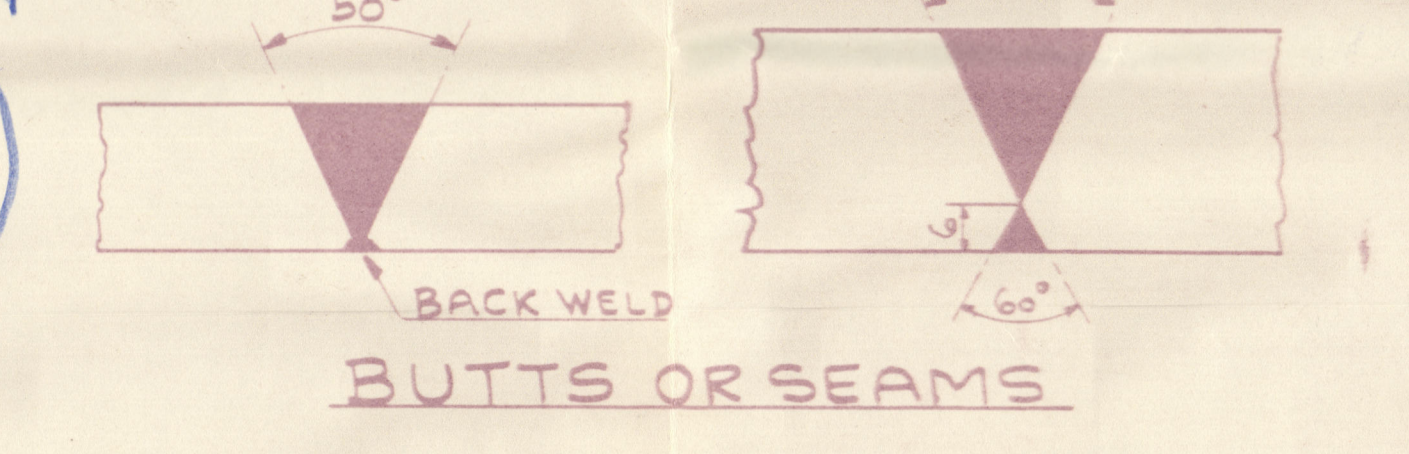

DIMENSIONS	
LENGTH OVER ALL	513'-4" = 157.32 MET
BETWEEN P.P.	490'-0" = 149.32 "
BREADTH MOULDED	65'-0" = 19.81 "
DEPTH TO MAIN DECK	37'-0" = 11.28 "
CORRECTED FOR NORMAL SUPER	36'-0" = 10.97 "

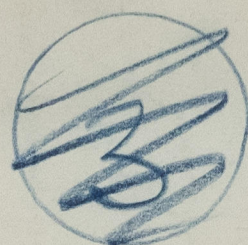

RECORDS DEPT.,
LONDON

5

"ETNEFJELL" ★

ERIKSBERGS MEK. VERKS.
YARD NOS. 392-3-6-7.

PROFILE & DECKS.

13

J

008743-008750-0172



© 2020

Lloyd's Register
Foundation

Lehtsbergs Meh. Käsä. M.
Göteborg.

1871/47

008743-008750-0172

M/S 392939697



© 2020

Lloyd's Register
Foundation