


to bulkhead to be kept clear of deck beam thus

Naples Rpt N° 4982

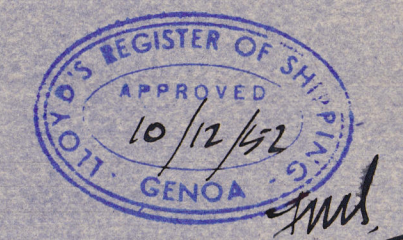


S/A. NAVALMECCANICA BACINI E SCALI
UFFICIO TECNICO
DISE. N° A/879 COSM. P/O "MARIA LAURA"
PARATIE TRAVEVERSALE E CIELLO (1/TER-
NA NAFTA - 2020
Scala: 1:50
Napoli: 22-11-1952
Lloyd's Register
Foundation

008751-008752-0008

4
"Marialuxta"

Rpt. no. Nap. 4962

Cross bunked
converted into a
fuel oil deep
tank.

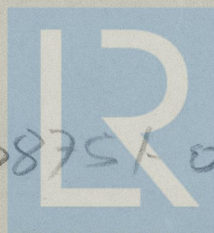

© 2020

008751-008752-008
Lloyd's Register
Foundation