

YARD NOS. 376 & 377


PROFILE & DECK

OIL BURNING STEAM TRAWLERS.


DIMENSIONS. 133'-4" B.P. x 25'-6" BREADTH MLD. x 14'-0" DEPTH MLD.

SCALE: $\frac{1}{4}$ " = 1 FOOT.

*See list of alternative scantlings
to end rolling.
App'd 11.9.47*

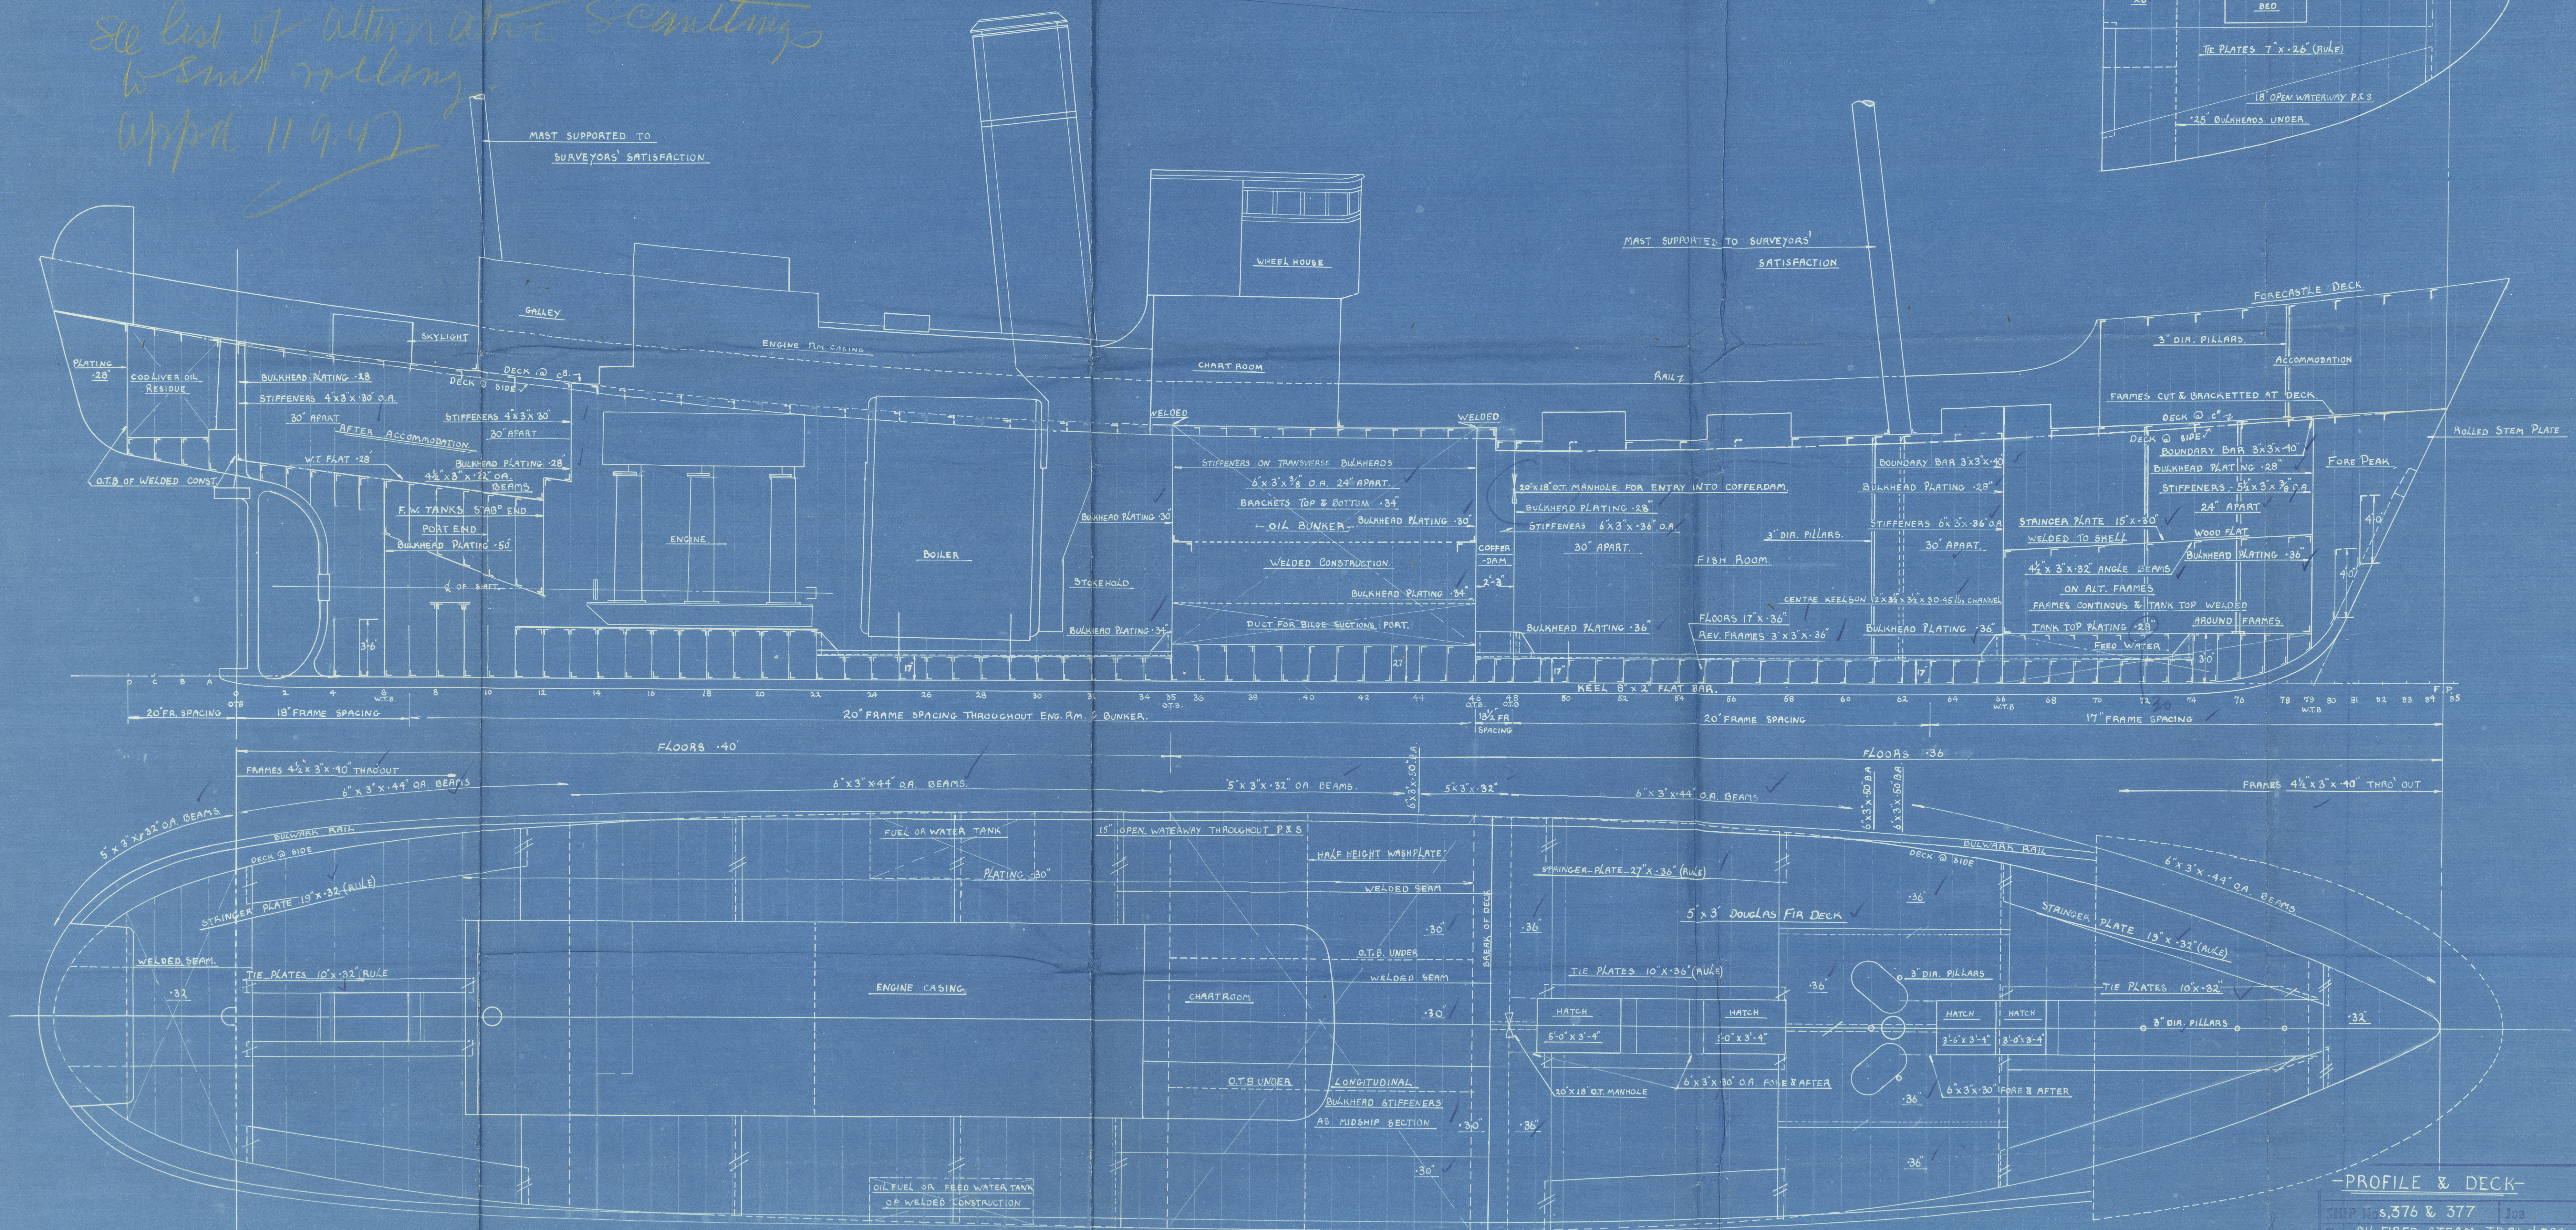

FORECASTLE DECK.

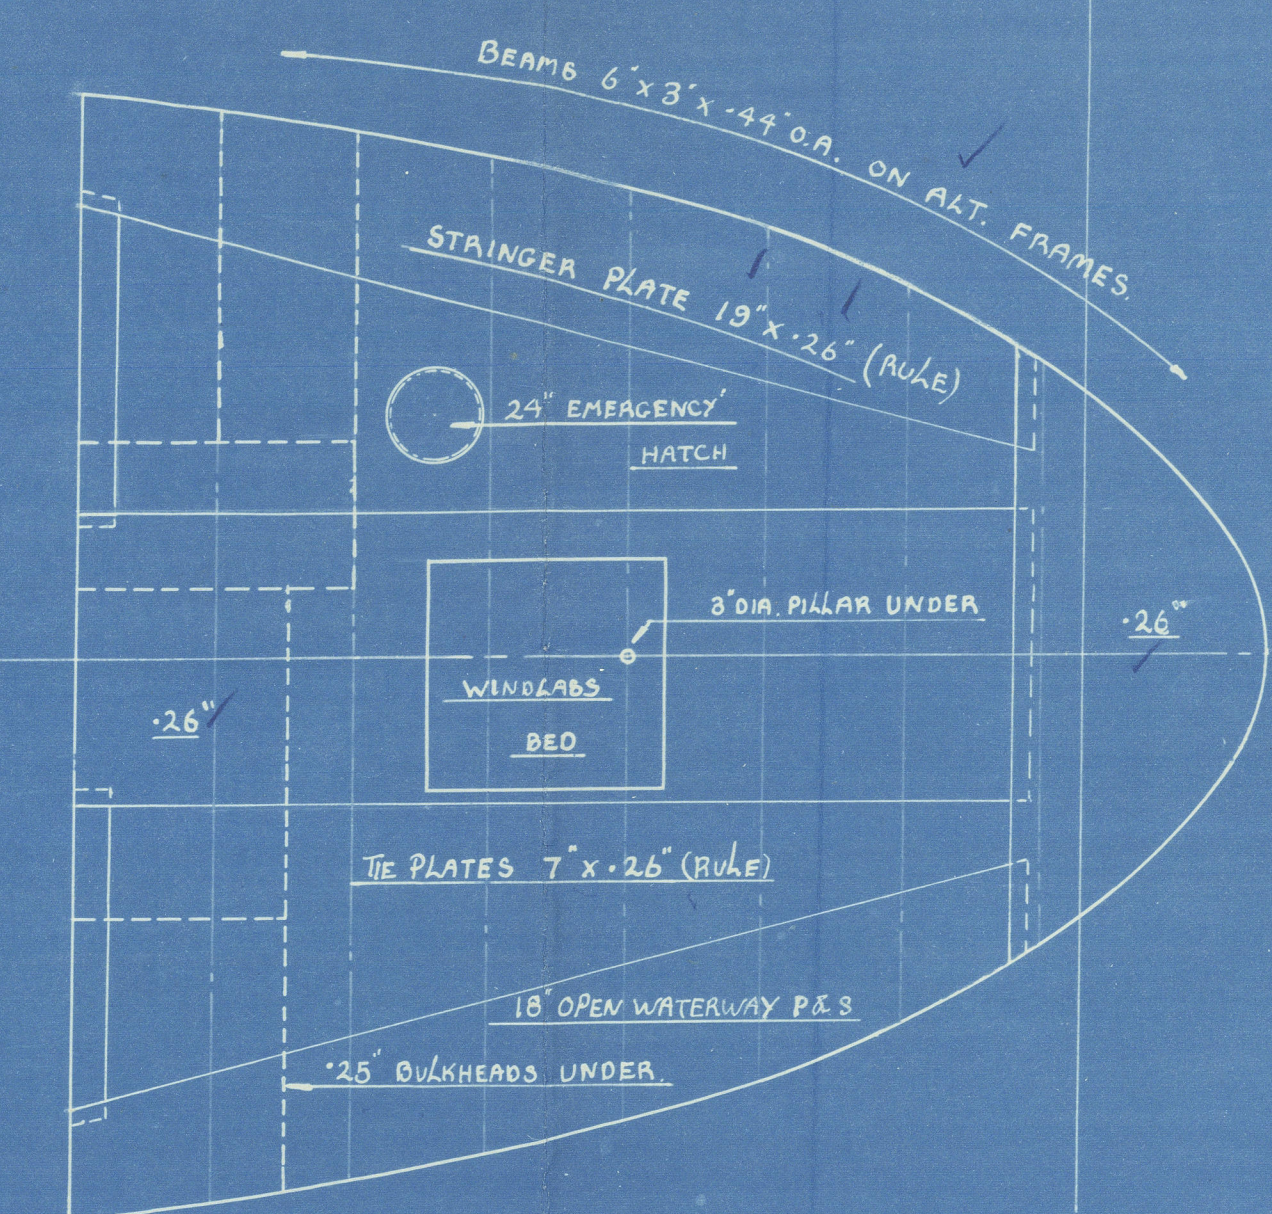

PROFILE & DECK

SHIP NOS. 376 & 377	JOB
TYPE OIL FIRED STEAM TRAWLERS.	
SCALE $\frac{1}{4}$ " = 1 FOOT	DWN. 17-3-47 M.B.
DWG NO 12	DRAWN
RICHARDS IRONWORKS LTD	NO. 14
CROWN WORKS	PRINT NO.
TITLE	DATE
51.	20-10-47

008753-008758-0104

"BRACONCLEN" ★

RECORDS DEPT.,
LONDON

2

RICHARDS IRONWORKS

YARD NOS. 376-7

PROFILE & DECK

© 2021

Lloyd's Register
Foundation

YARD Nos.- 376 & 377.

PROFILE & DECK.

RICHARDS IRONWORKS LIMITED

SHIPBUILDERS & ENGINEERS

LOWESTOFT

SHIP NO:


Dwg. No.

Job No.

Print No.

Date

008753 - 008758 - 0104

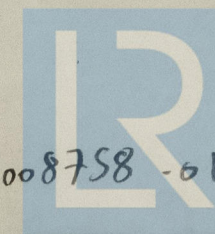

© 2021

Lloyd's Register
Foundation