

## SINGLE SCREW DIESEL RIVER &amp; DOCK TUG

## PROFILE &amp; DECK

SCALE  $\frac{1}{2}" = 1 \text{ FOOT}$ 

LENGTH O.A. 75'-0"


LENGTH B.P. 70'-0"

BREADTH MLD 18'-6"

DEPTH MLD 9'-0"

## Riveting

Beams to deck	$\frac{3}{8}"$ dia Rivets	$4\frac{1}{2}"$ Pitch C.T. to C.T.	( $3\frac{1}{2}"$ pitch in way of peak tanks)
Stringer Angle to deck	$\frac{3}{8}"$	$2\frac{1}{2}"$	
Foundation Angle to deck	$\frac{3}{8}"$	$3\frac{1}{2}"$	
Casing Side Stiffeners	$\frac{3}{8}"$	$4\frac{1}{2}"$	
Bulkhead Boundary Angles to deck	$\frac{3}{8}"$	$3\frac{1}{2}"$	

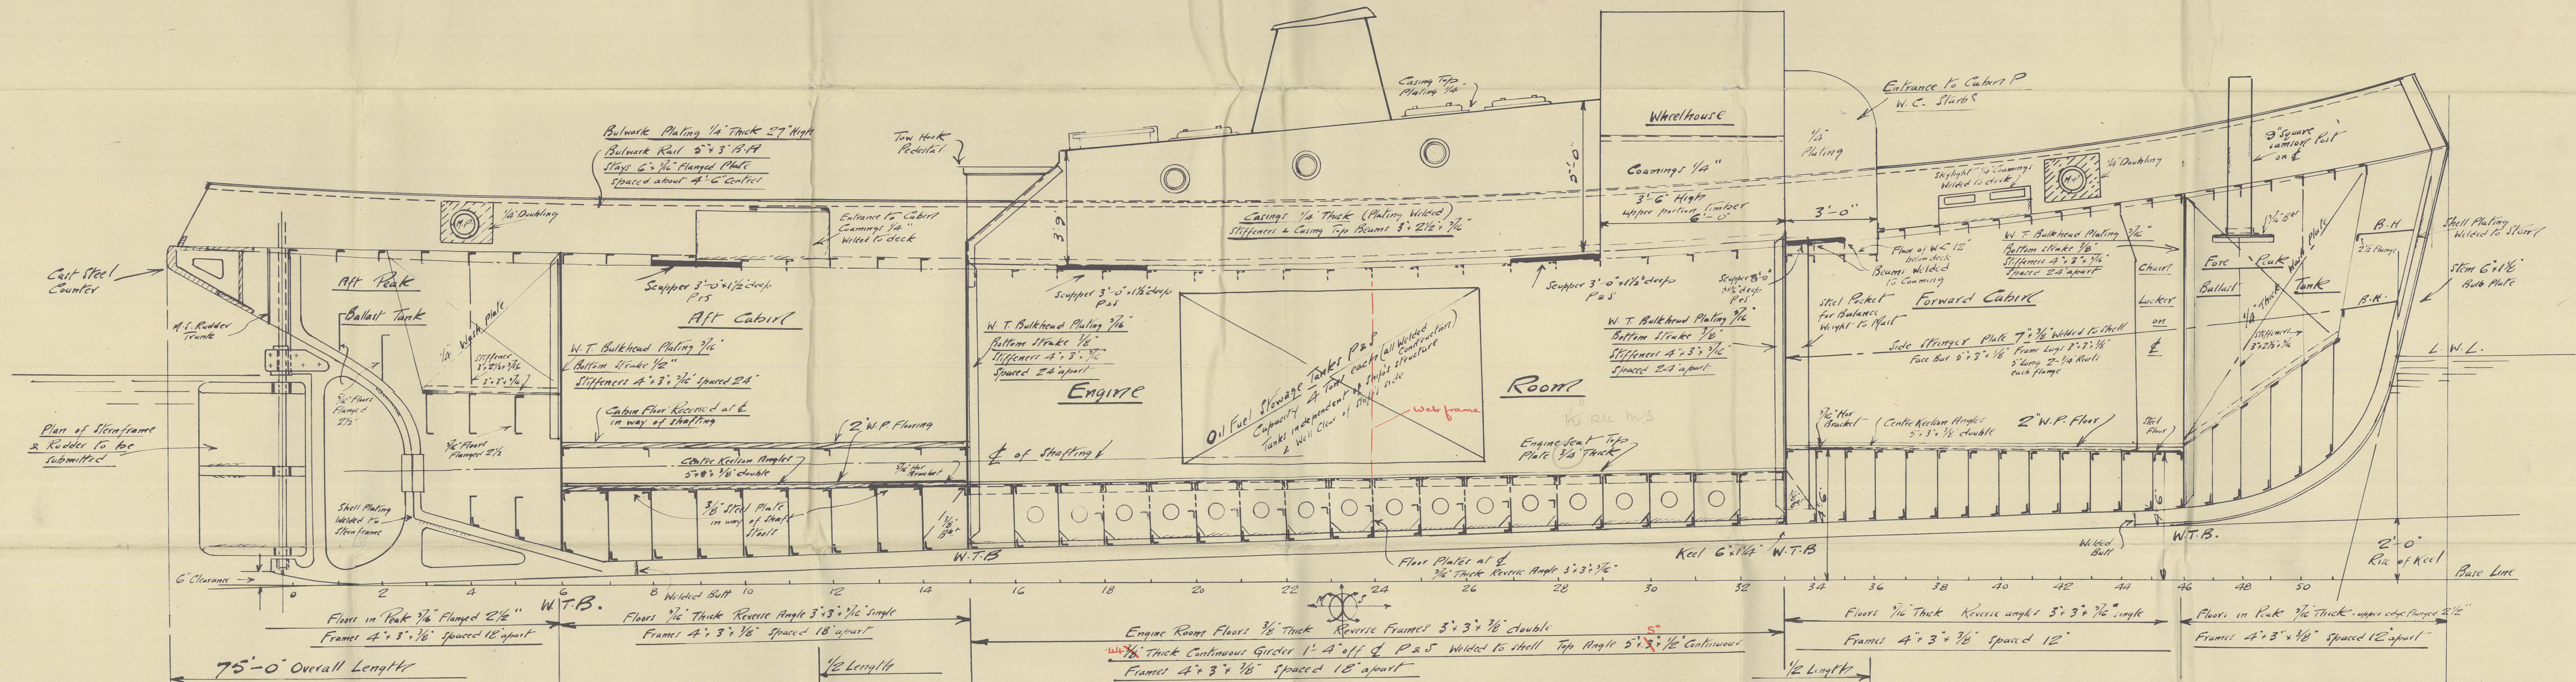


All Exposed Deck Plating Chequered

Pillaring Arrangements Throughout to Survivors Satisfaction



Gull ★  
Profile & Beck

RECORDS I  
LOND

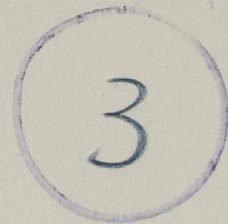

© 2021

Lloyd's Register  
Foundation

008759-008764-0165



5910 - 497800 - 657800



© 2021

Lloyd's Register  
Foundation