

GAMMELL, LAIRD & CO. LTD.
 ENGINEERS
 10, ABchurch Lane, LONDON, E.C. 4
 British Corporation
 DATE 4-11-27
 SHIP DEPARTMENT.


N^{OS} 938. 9 + 40

OUTLINE PLAN SHEWING INCREASED AREA OF RUDDER
 SCALE 1/2" = 1 FOOT


SCANTLINGS OF RUDDER IN ACCORDANCE WITH
 INCREASED DIA^R

7 NOV. 1927

Approved *[Signature]*
 8. 11.27

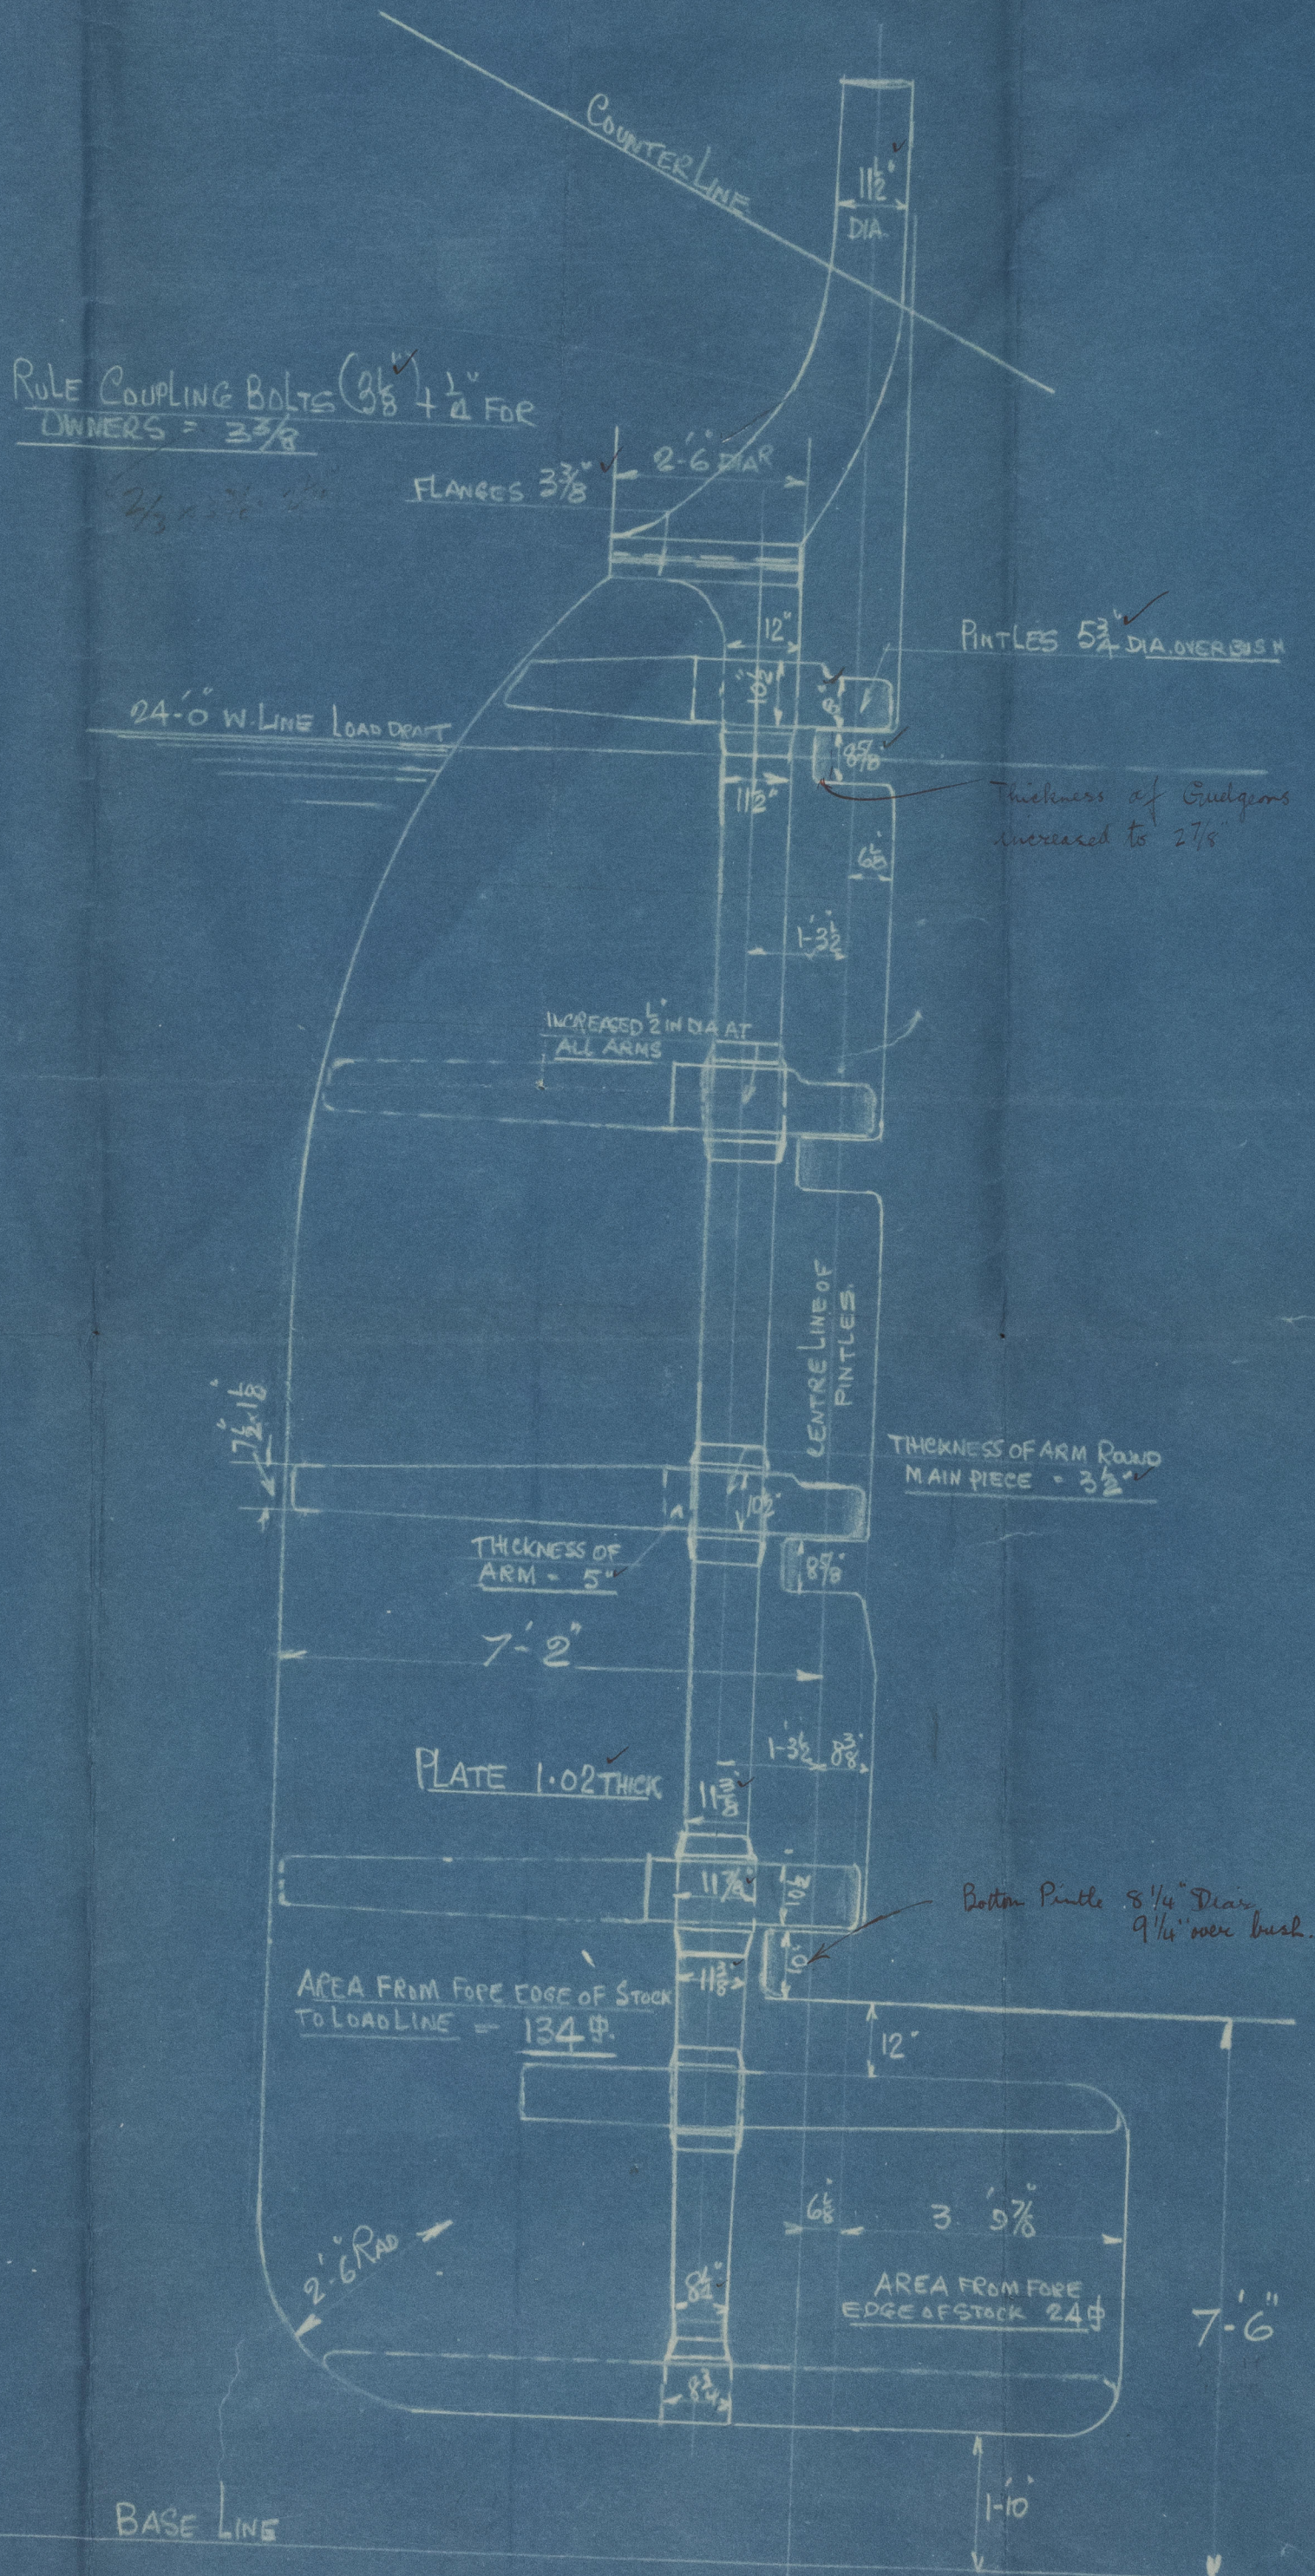

T. No. 7A.
 SW. 11
 11 NOV 27

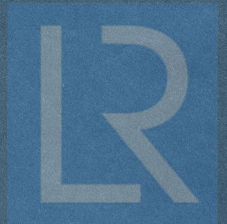

16

Mod. to Area of Rudder

Cammell Laird & Co

Q38 - Q - 0.

- 8 NOV 1927

See also N^o 4.

Q38. Lady Nelson.

Q39. Lady Hawkins.

Q40. Lady Drake.

Copy



© 2021

Lloyd's Register
Foundation

008754-008764-0193