


LONGITUDINAL SECTION

SCALE: 1/8" = 1'00"


DIMENSIONS: 415'-0" B.P. - 59'-0" MLD - 31'-0" MLD TO UPPER DECK
TO CLASS B.S.* (WITH FREEBOARD)

DETAILS OF W.T. & O.T. PLAYS & DECKS TO BE SUBMITTED

See detail plan approved

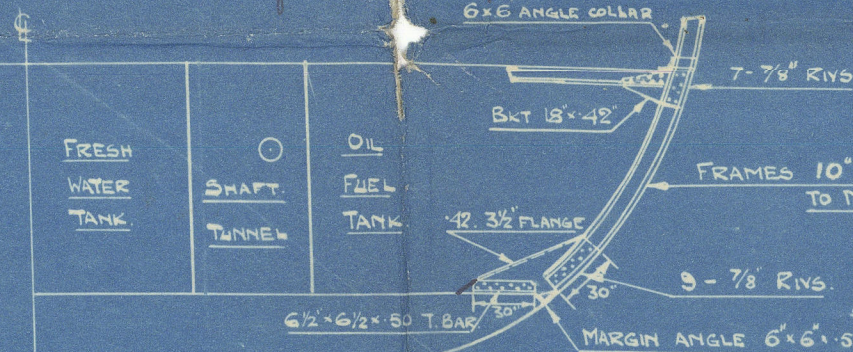

APPROX. SECTION AT FR. 40 -
(FOR FRAMING & BRACKETING ONLY)

 

30 MAR 1927



7 NOV 1927

Approved

And. Longtl. Section.

Gammell Laird & Co.

938-9-0.

V.L. 30/11/27

11-11-27.

938. Lady Nelson.

939. Lady Hawkins.

940. Lady Drake.

over



© 2021

Lloyd's Register
Foundation

008759-008764-0145