

RUDDER PARTICULARS

SHIP'S LENGTH BETWEEN P.P. (L)	128.00M
LOAD DRAUGHT (d)	7.95M
SEA SPEED	14.0 KNOTS
PROJECTED RUDDER AREA (A)	15.773M ²
DE. ABAFT PINTLE (A ₁)	11.631M
DE. BEFORE PINTLE (A ₂)	4.142M
BALANCING RATIO (A ₁ /A ₂)	2.806
MAX. THICKNESS-BREADTH RATIO	0.191
ASPECT RATIO (HEIGHT-BREADTH)	1.756
AREA RATIO (A ₁ /A ₂)	1/2.806
DIAMETER OF RUDDER HEAD	0.26M

REMARKS
1. WEIGHT OF RUDDER TO BE SUPPORTED AT UPPER PINTLE






MATERIAL LIST

MARK	ITEM	MATERIAL	NO.	WEIGHT	REMARKS





- NOTES
- 1) ALL SIZES ARE GIVEN IN MILLIMETERS UNLESS OTHERWISE NOTED.
 - 2) THIS PLAN SHOWS FINISHED DIMENSIONS.
 - 3) DIMENSIONS MARKED S TO BE DISTINCTLY DETERMINED BY FAIRING IN THE HOLO LOFT.
 - 4) FINISHING MARKS
 - 5) RAUGH FINISH
 - 6) AIR AND WATER-TIGHTNESS OF RUDDER TO BE TESTED
 - 7) WATER PRESSURE FOR TEST OF WATER-TIGHTNESS IS 0.8 ATMOSPHERIC PRESSURE
 - 8) PAINTING OF RUDDER (INSIDE) IS BITUMINOUS SOLUTION & ENAMEL
 - 9) "STERN FRAME" PLAN TO BE REFERRED TO.

NOTE
HORN & VERTICAL FRAMES TO BE CONNECTED TO RUDDER PLATE BY FIN WELDING AT PORT SIDE

LINE OF RUDDER
INCLUDING RUDDER PLATE THICKNESS
SCALE 1/2

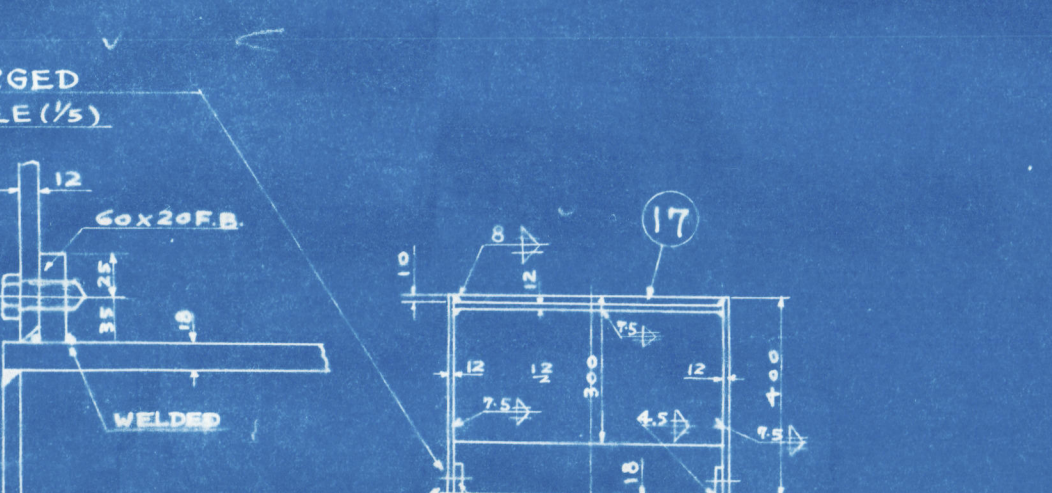
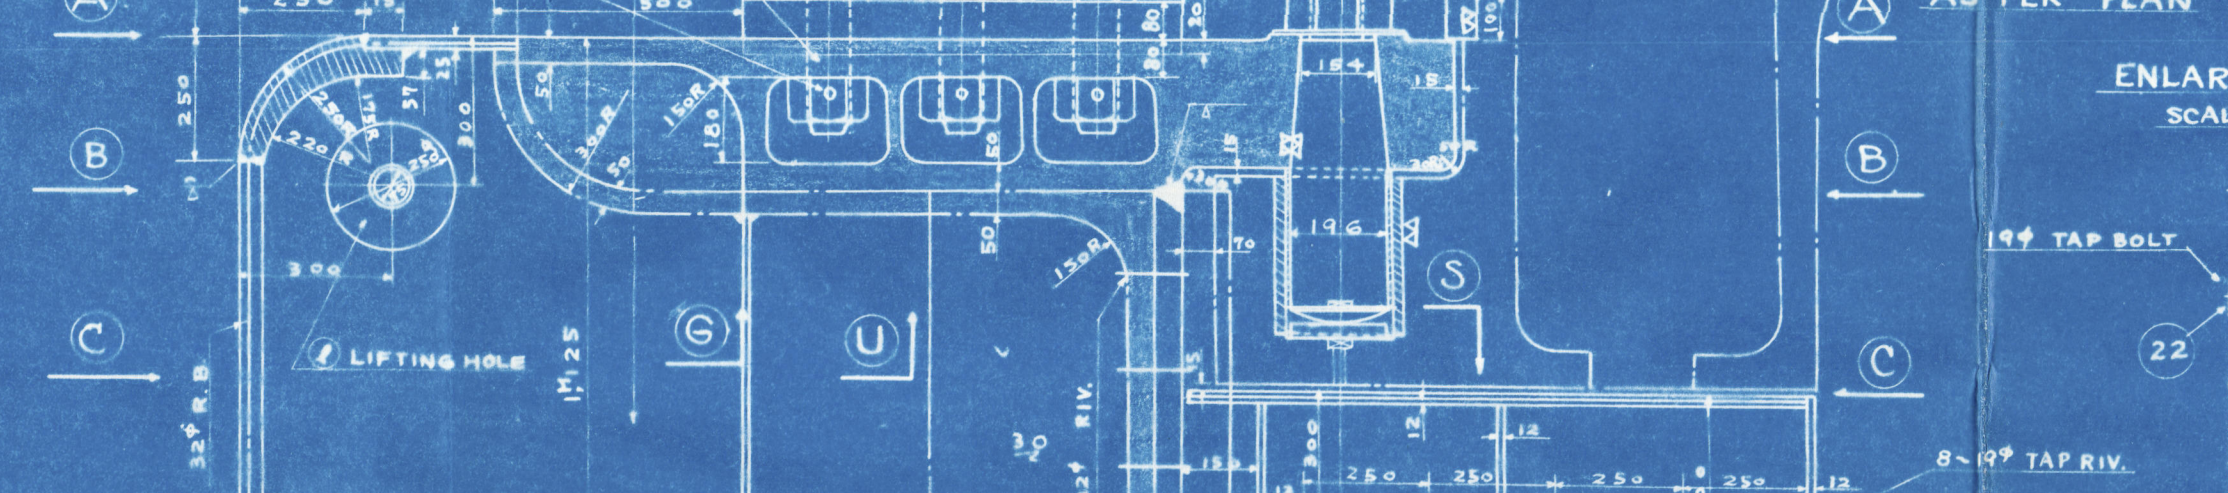
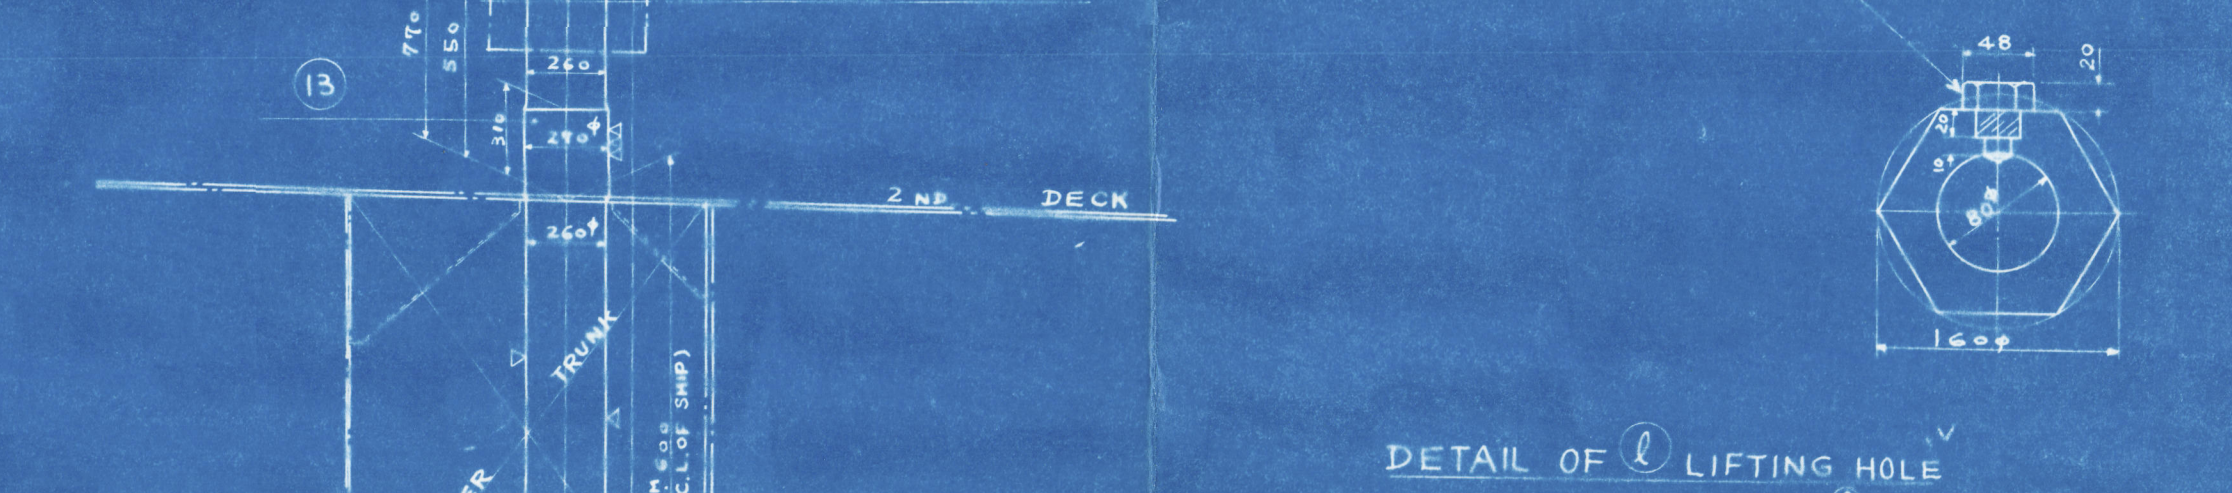
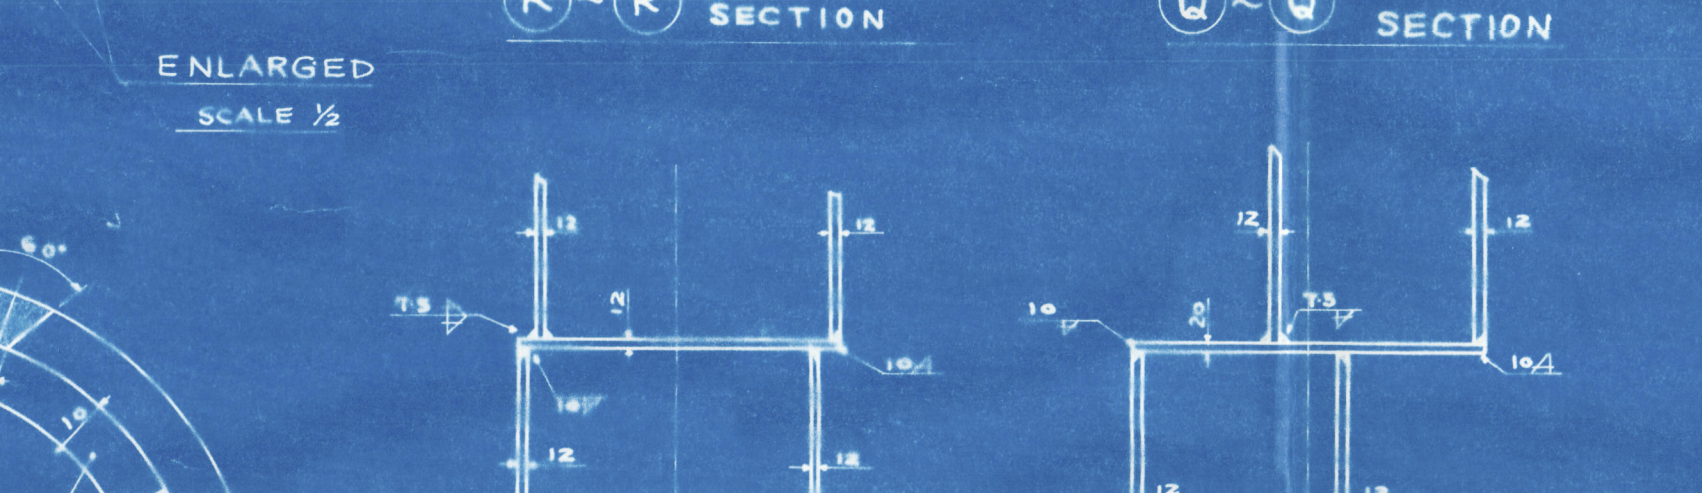
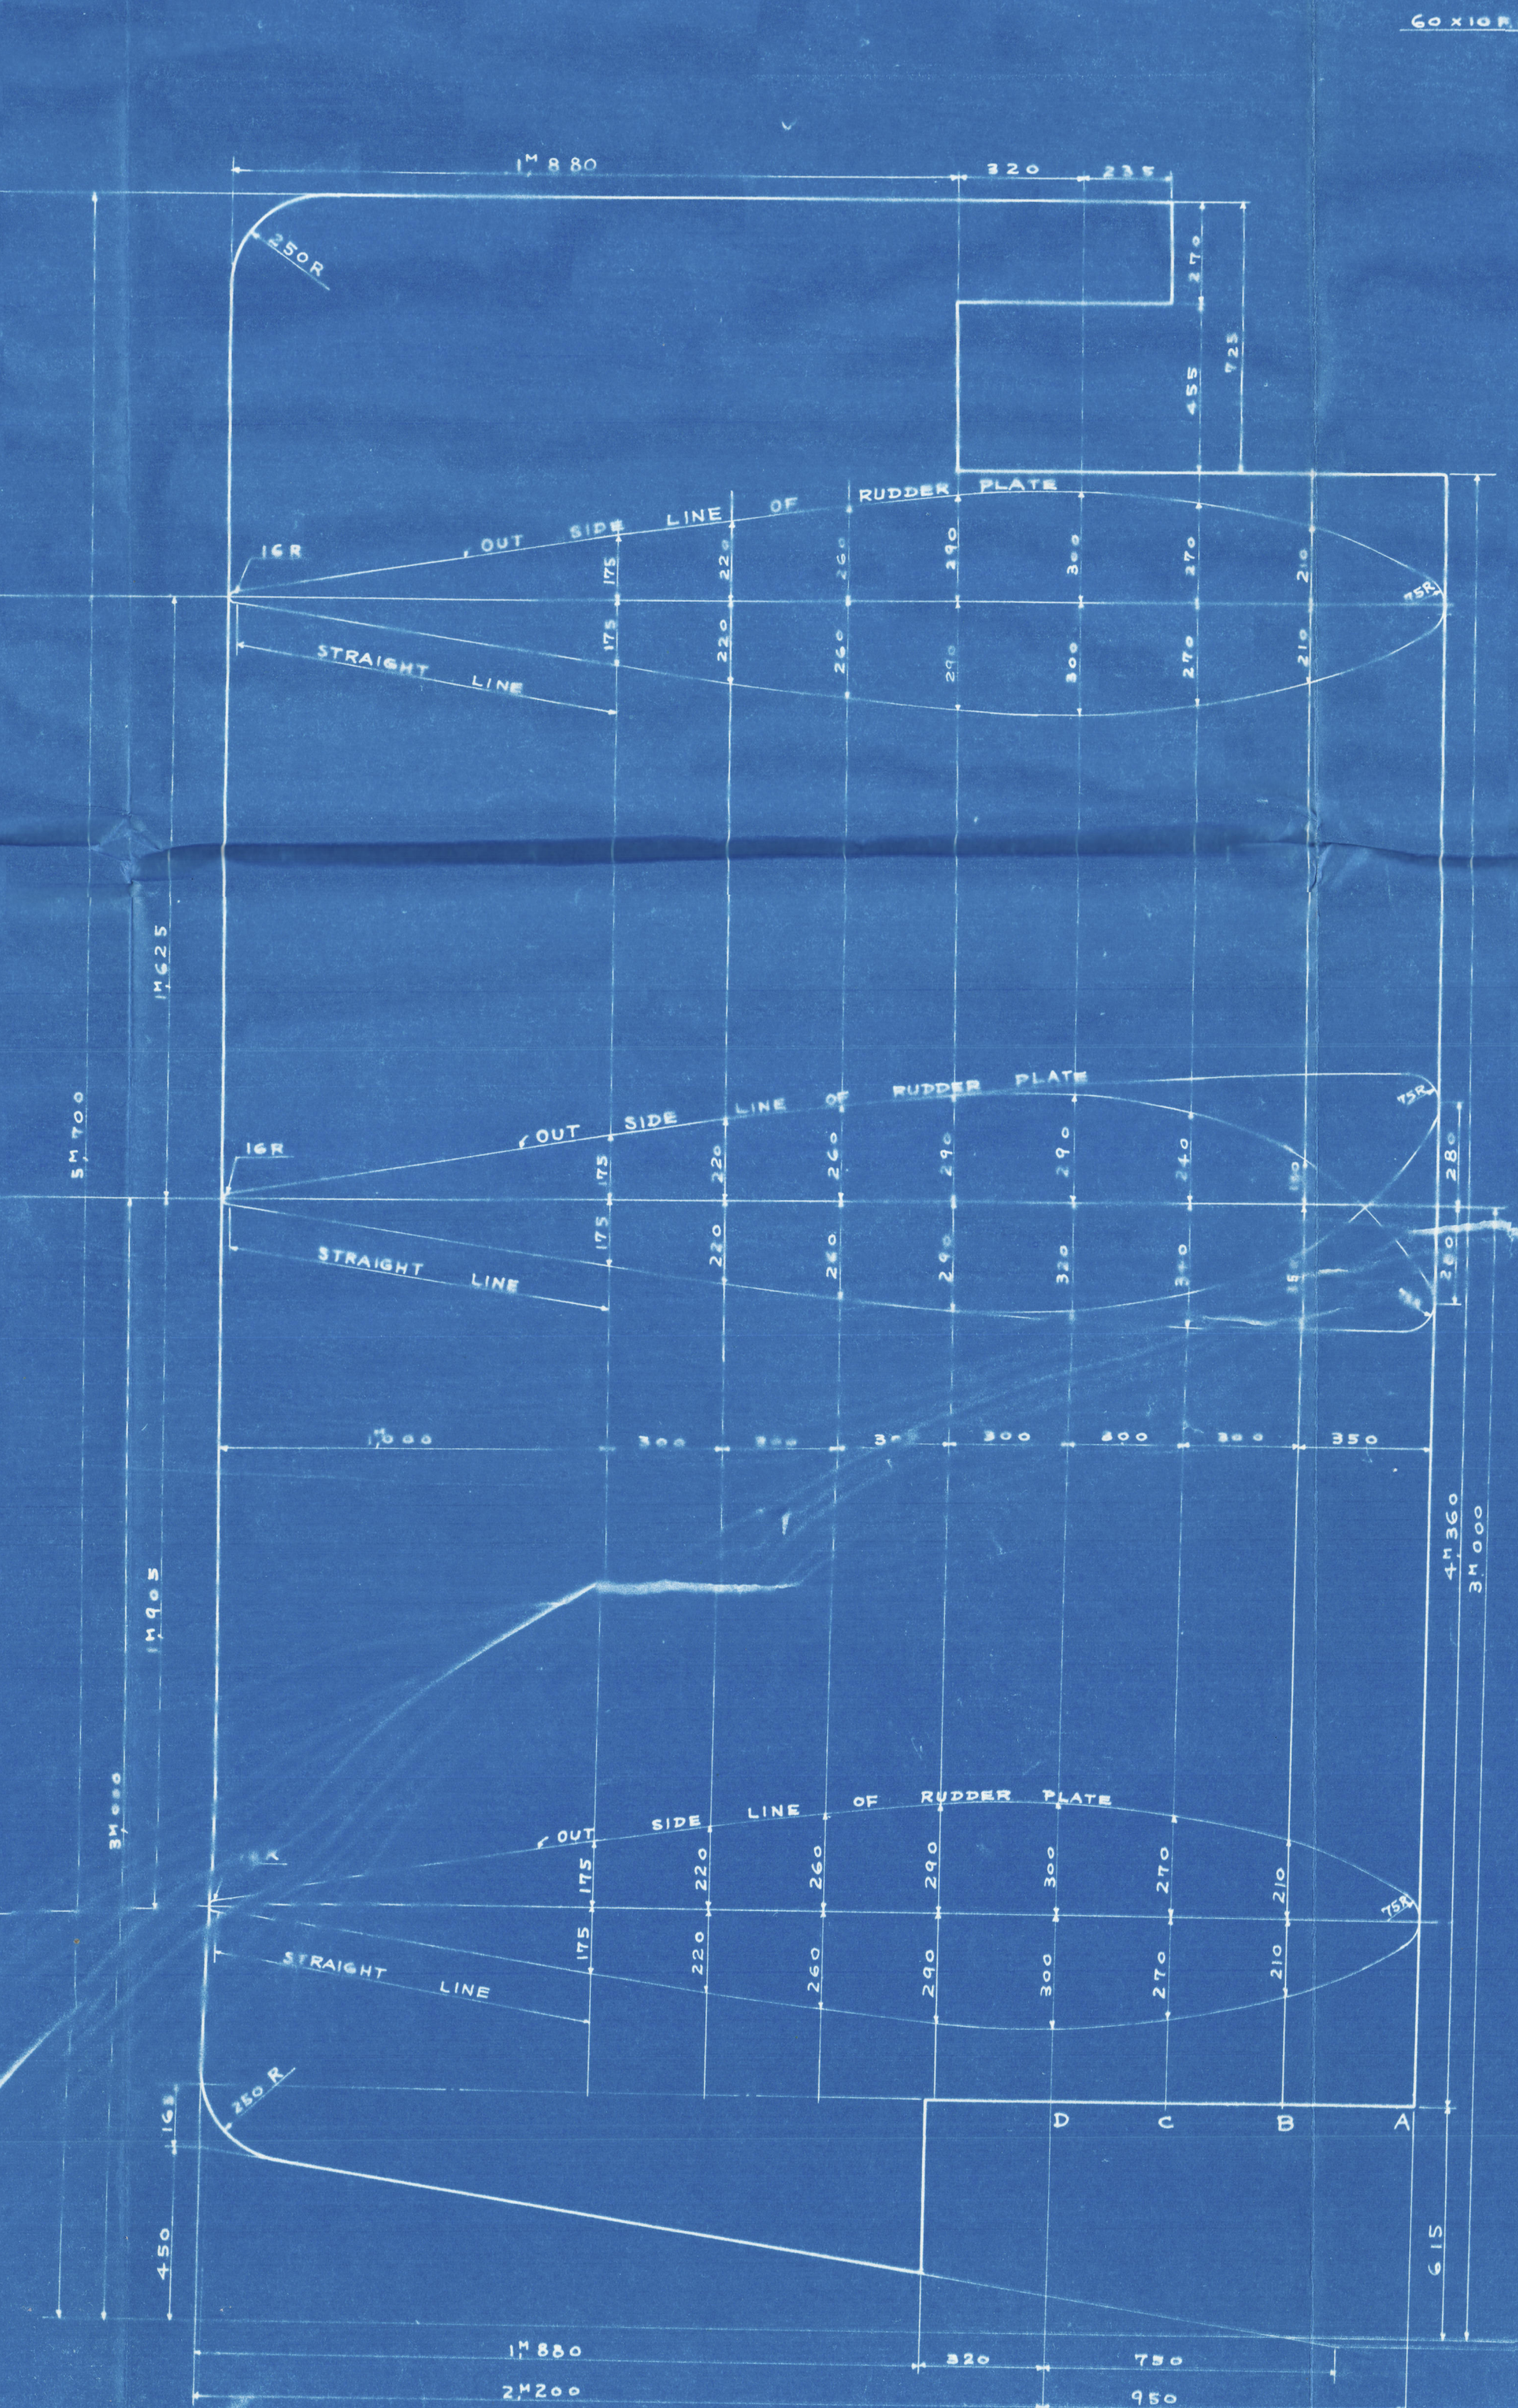


- NOTES
- 1) ALL SIZES ARE GIVEN IN MILLIMETERS UNLESS OTHERWISE NOTED.
 - 2) THIS PLAN SHOWS FINISHED DIMENSIONS.
 - 3) DIMENSIONS MARKED S TO BE DISTINCTLY DETERMINED BY FAIRING IN THE HOLO LOFT.
 - 4) FINISHING MARKS
 - 5) RAUGH FINISH
 - 6) AIR AND WATER-TIGHTNESS OF RUDDER TO BE TESTED
 - 7) WATER PRESSURE FOR TEST OF WATER-TIGHTNESS IS 0.8 ATMOSPHERIC PRESSURE
 - 8) PAINTING OF RUDDER (INSIDE) IS BITUMINOUS SOLUTION & ENAMEL
 - 9) "STERN FRAME" PLAN TO BE REFERRED TO.

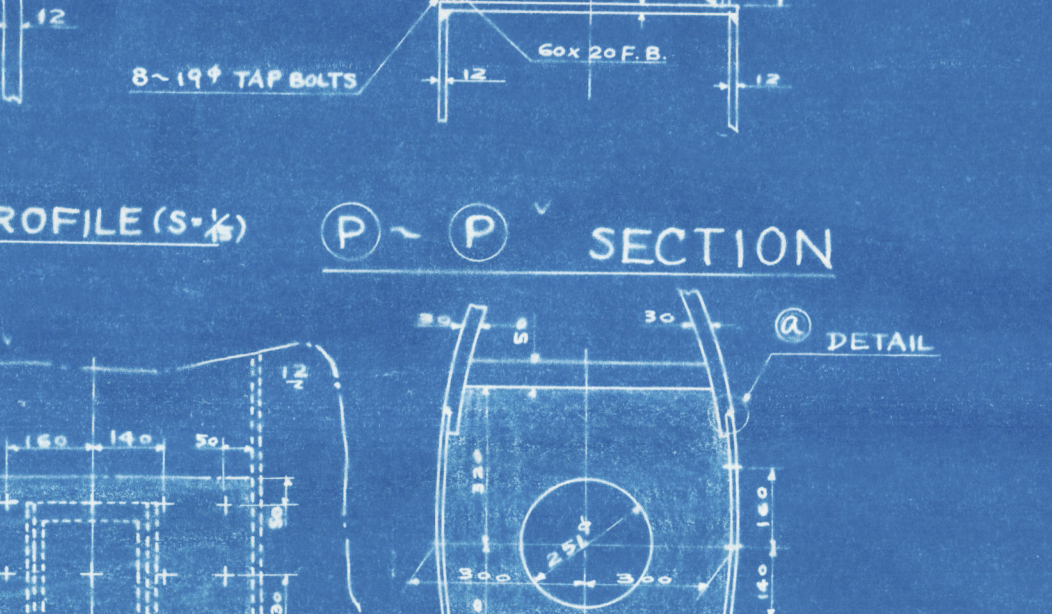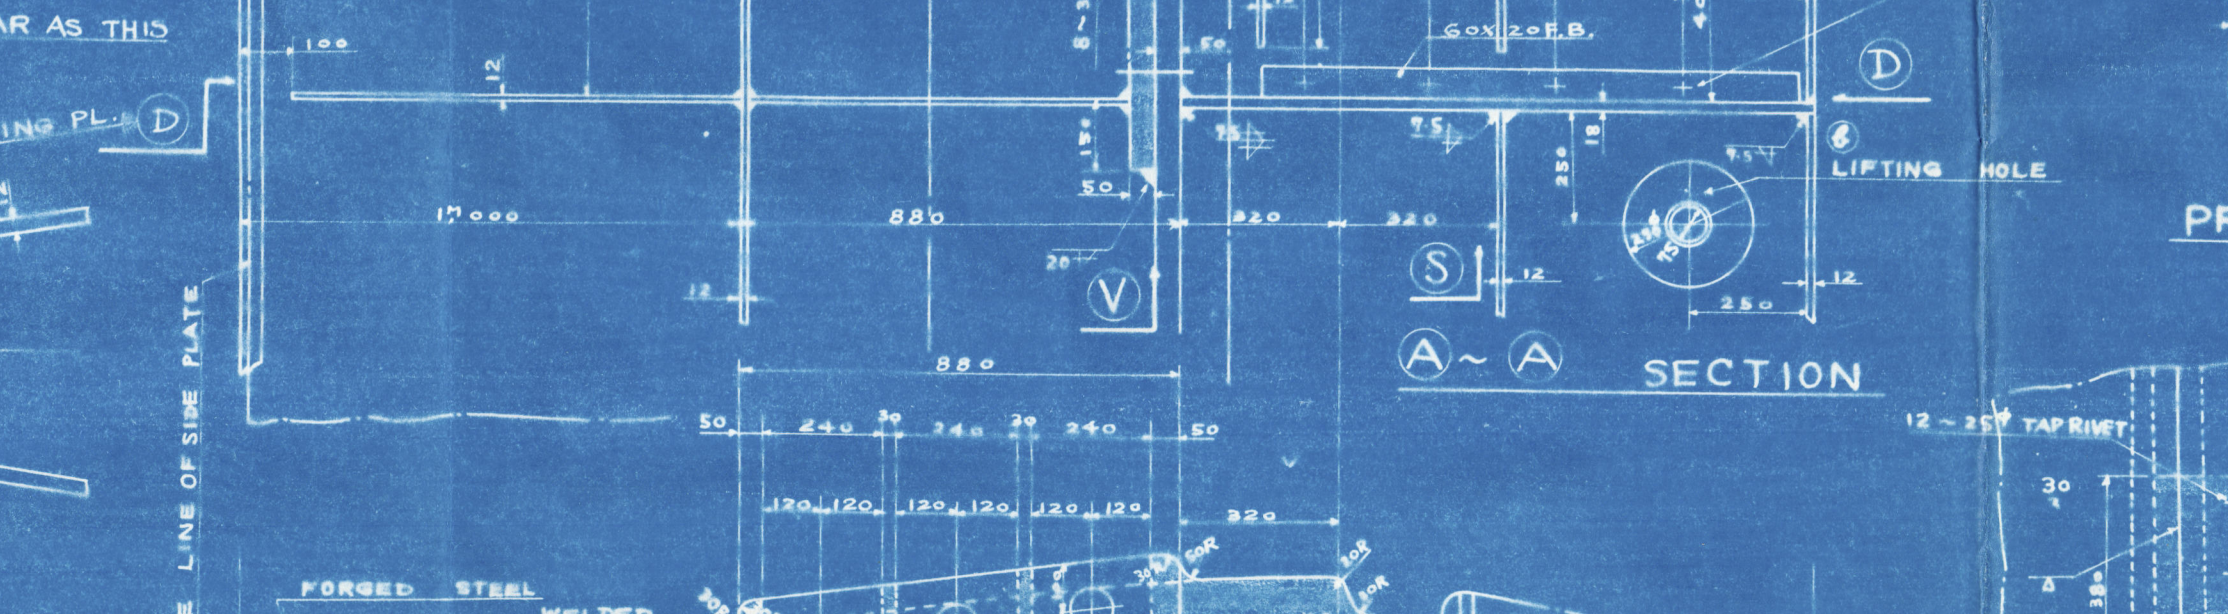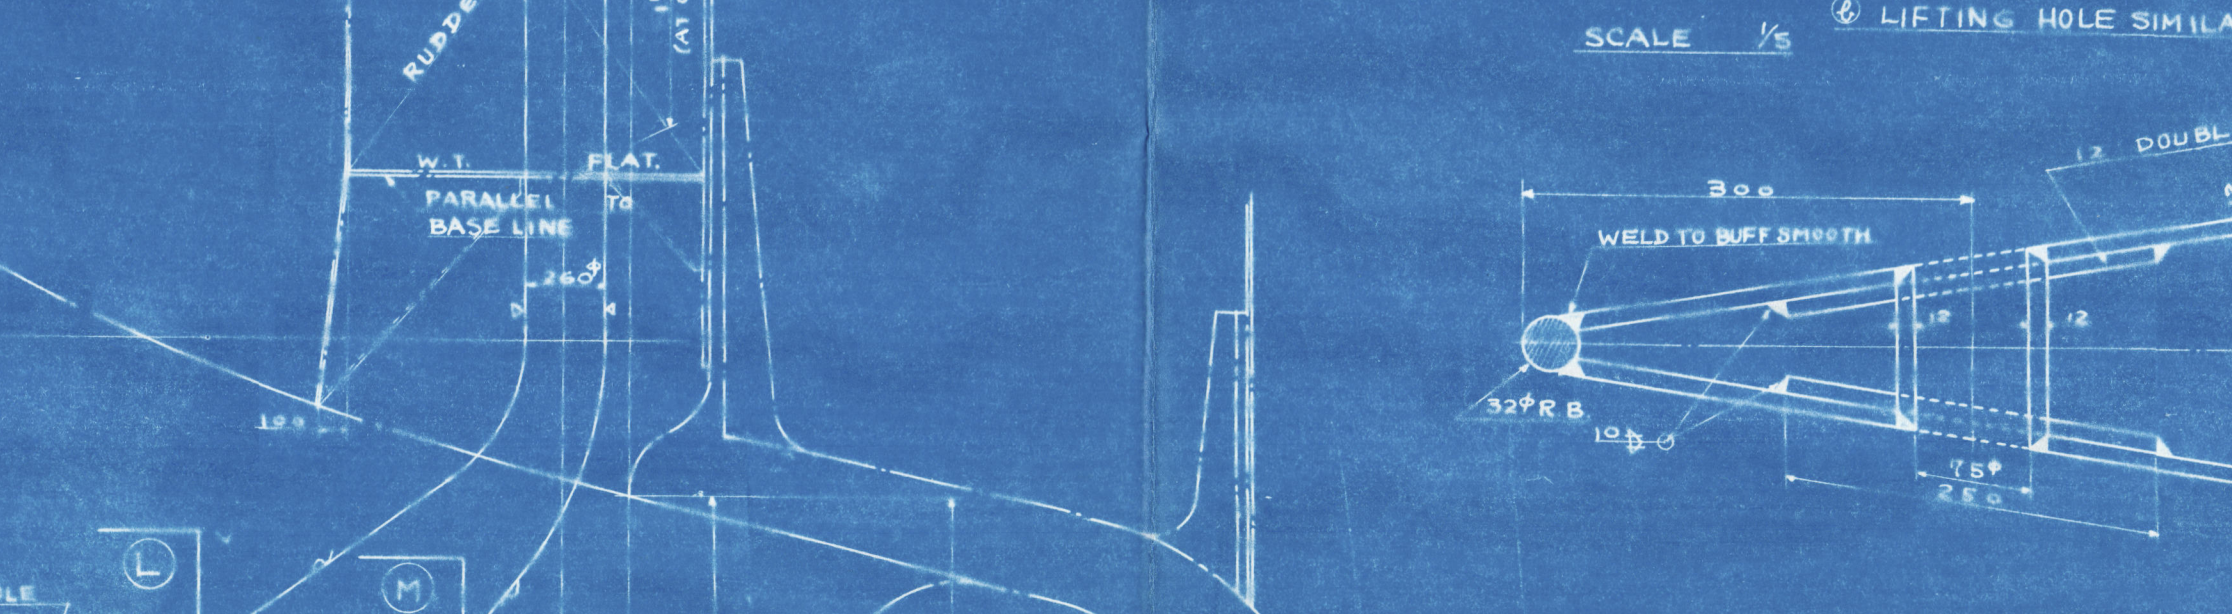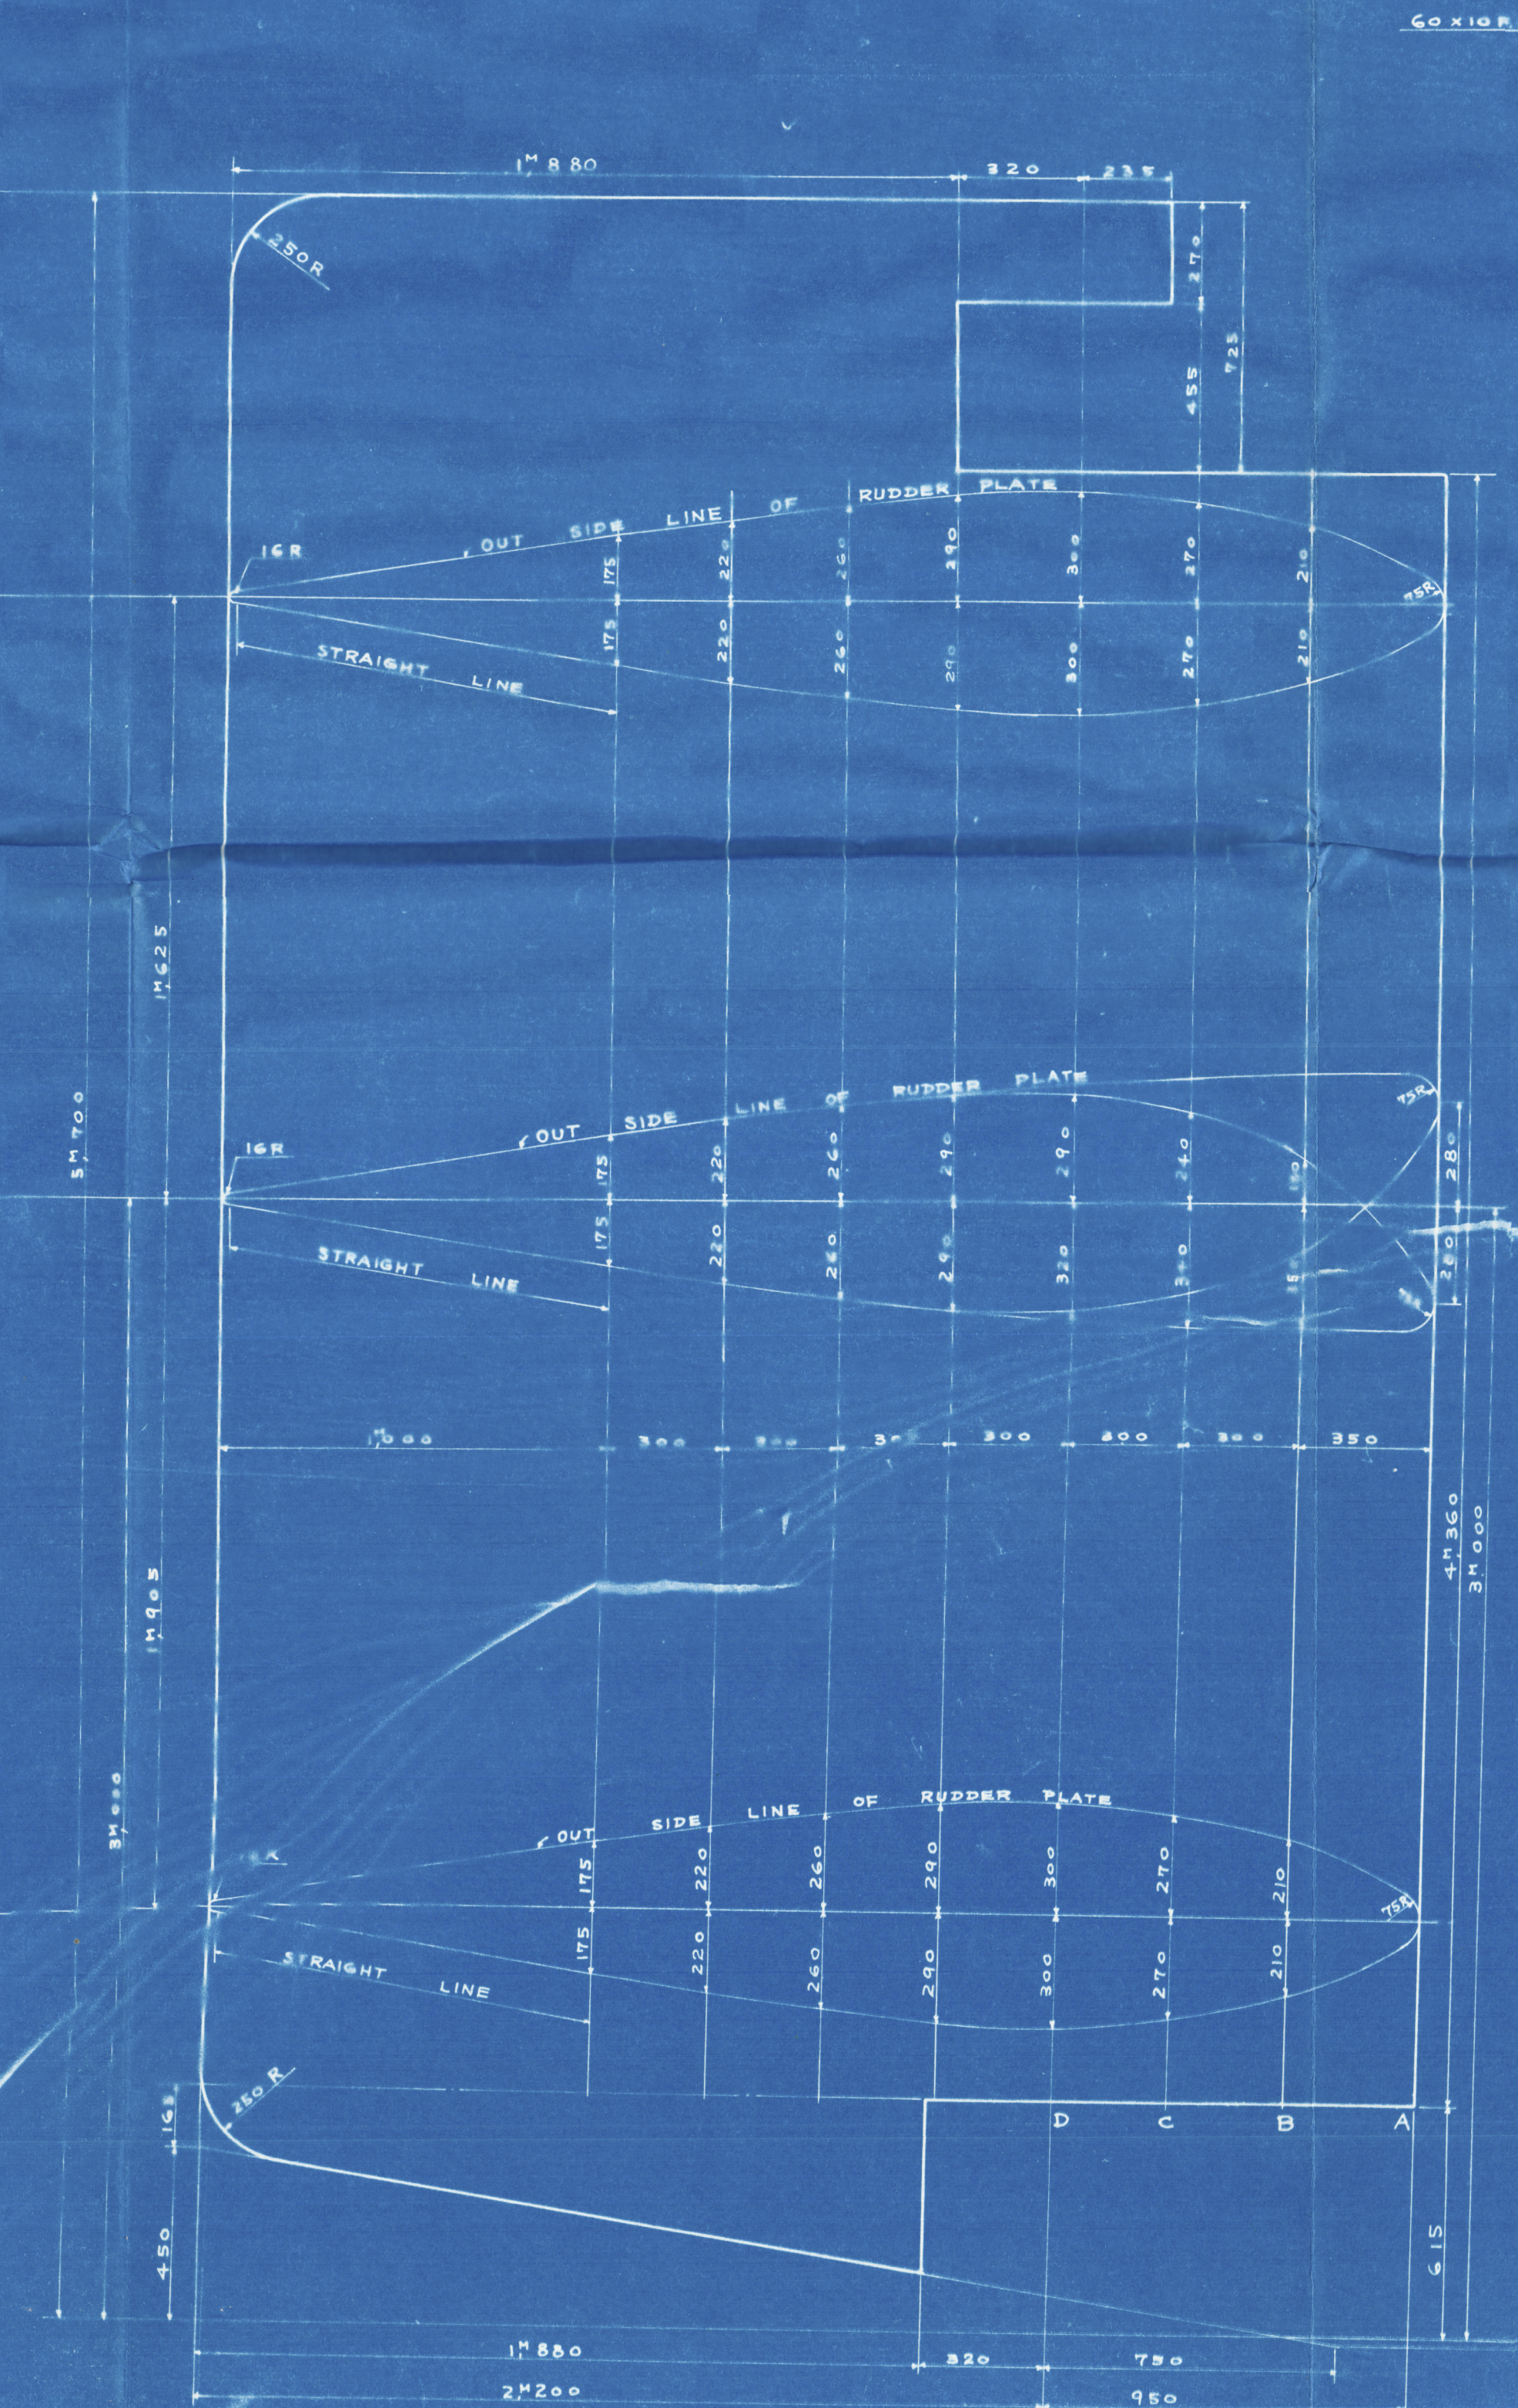





OTHER SIDE SECTION

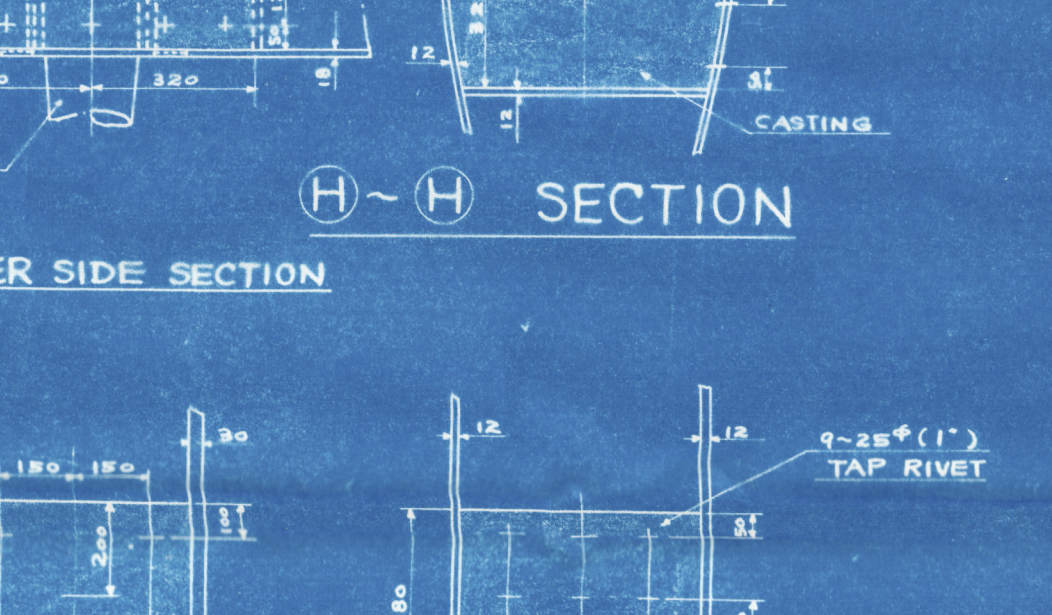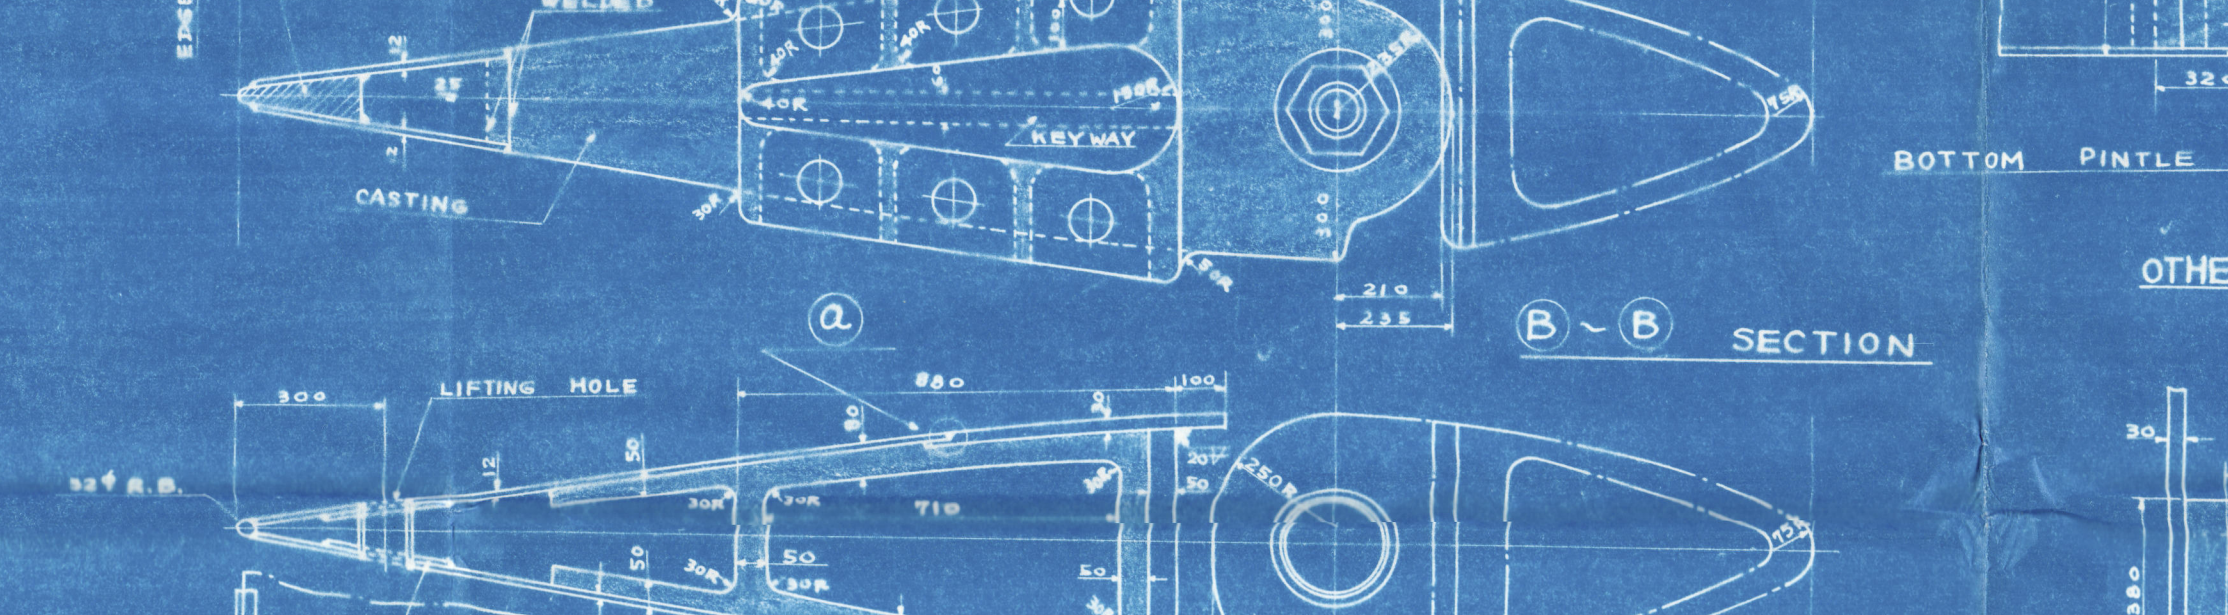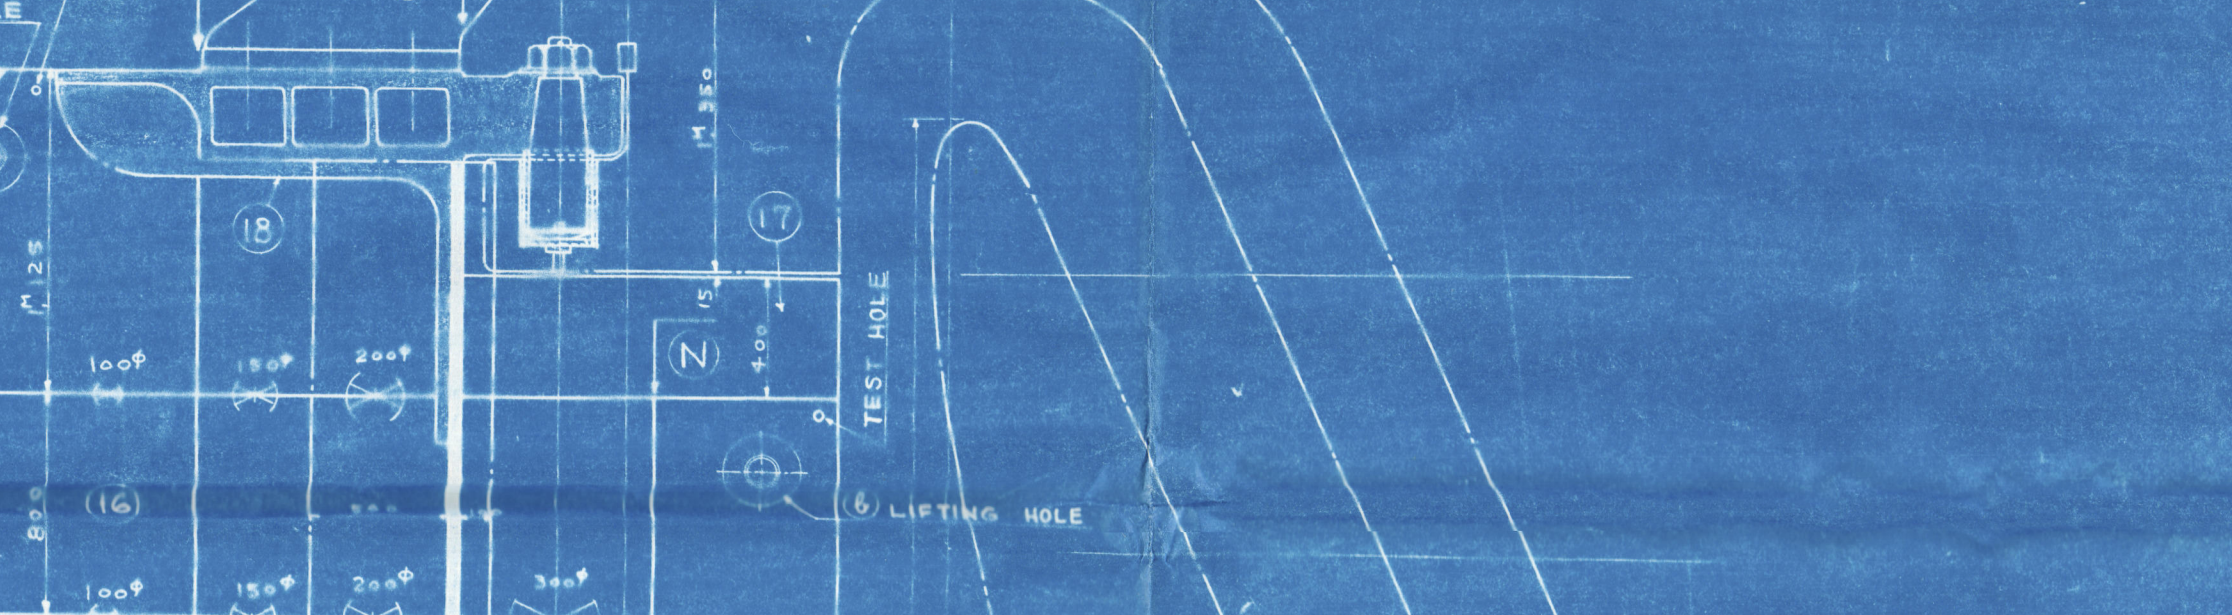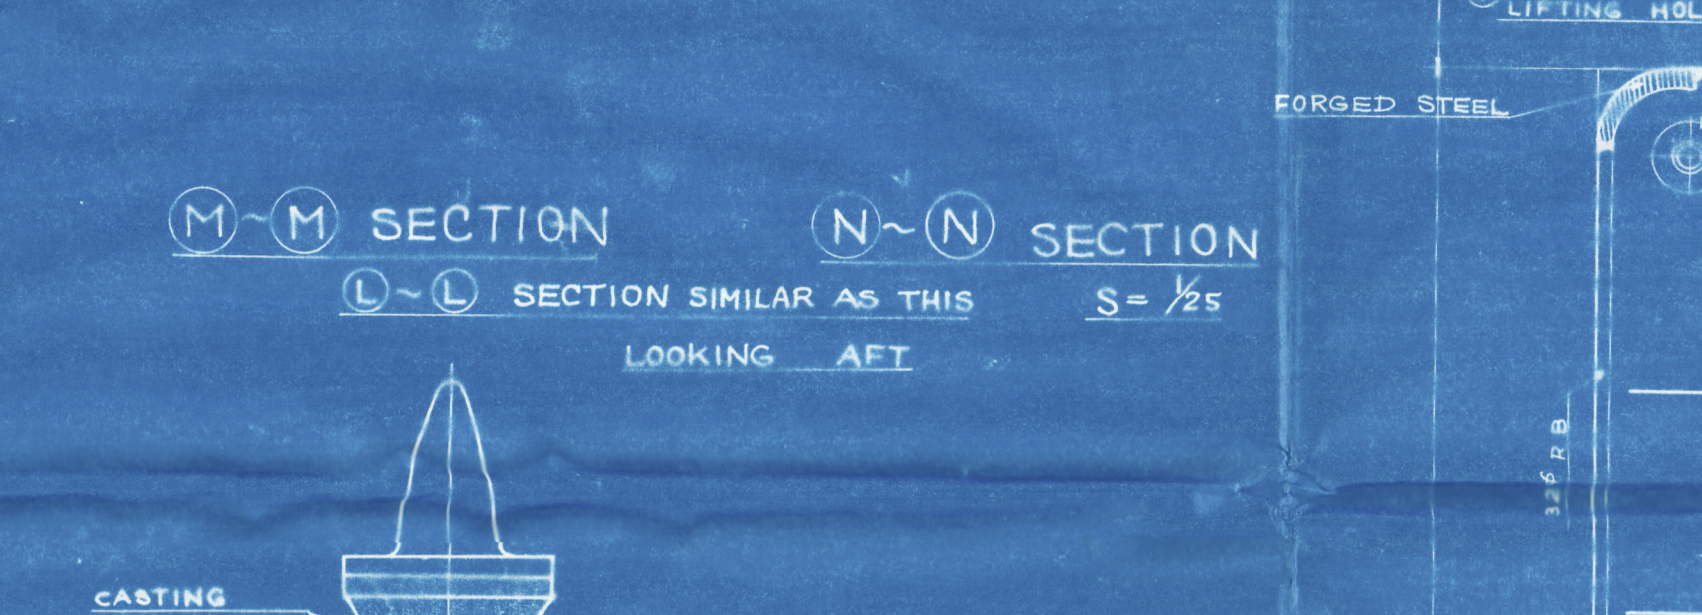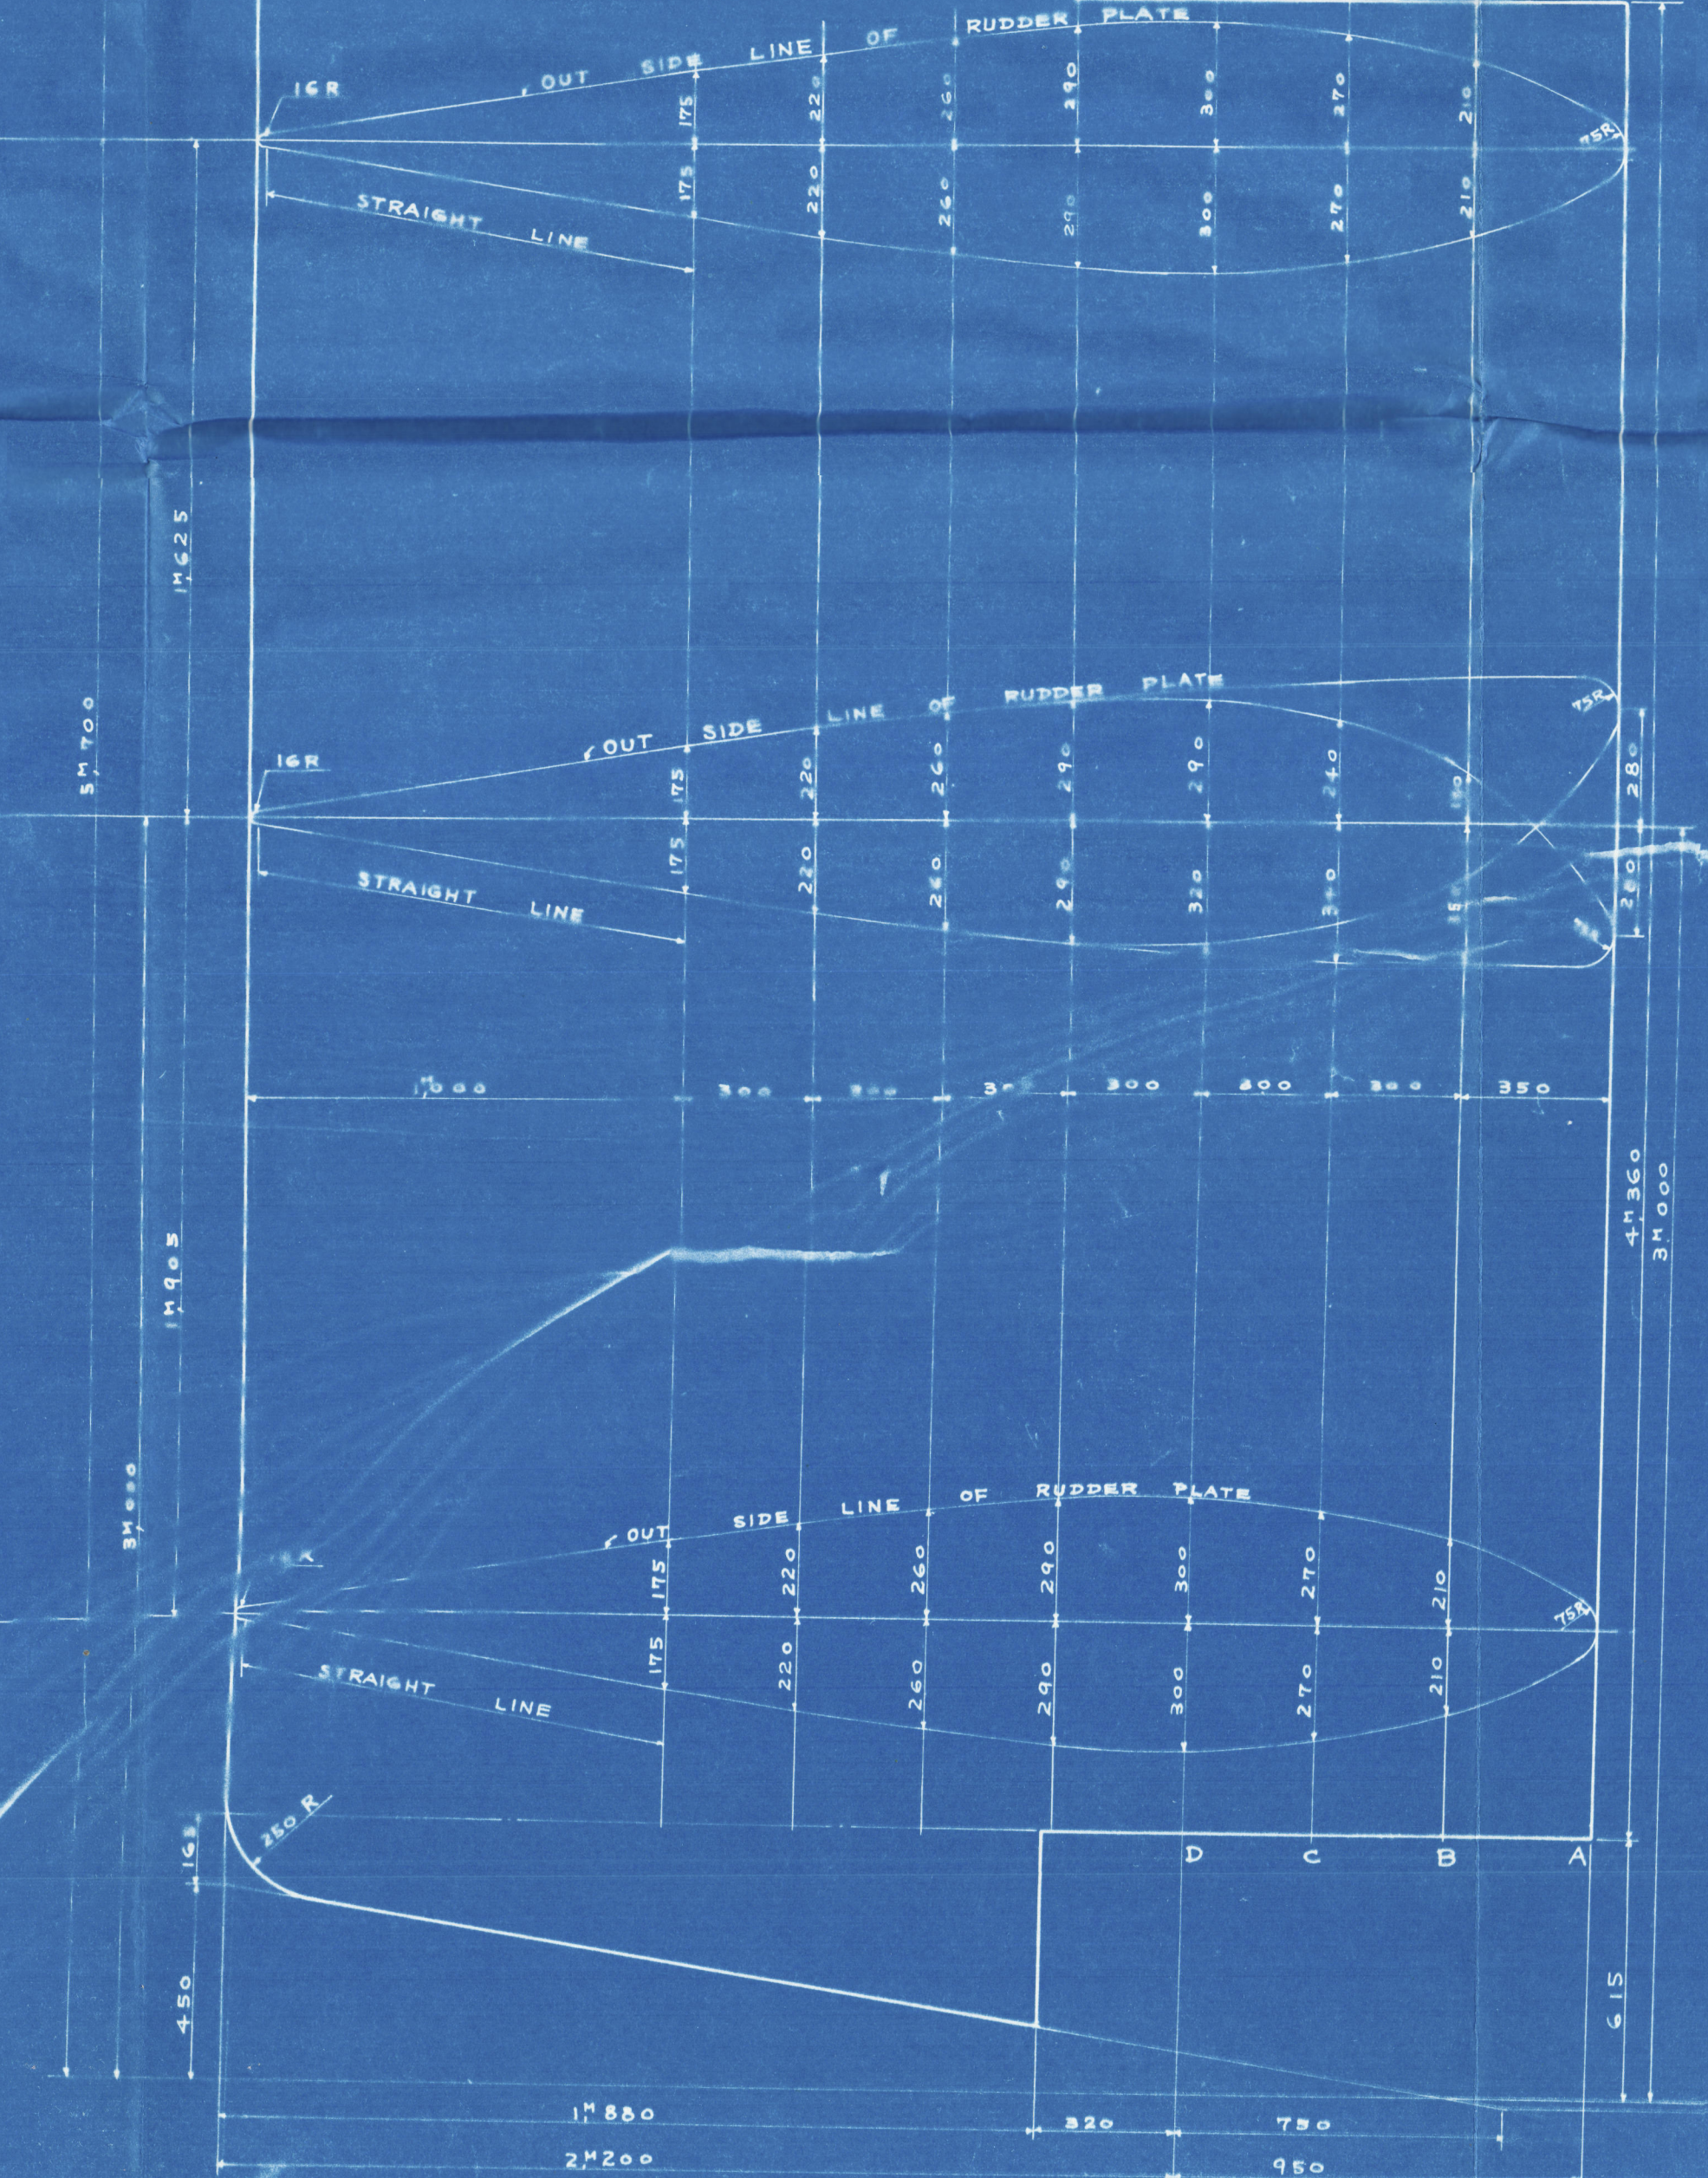






OTHER SIDE SECTION

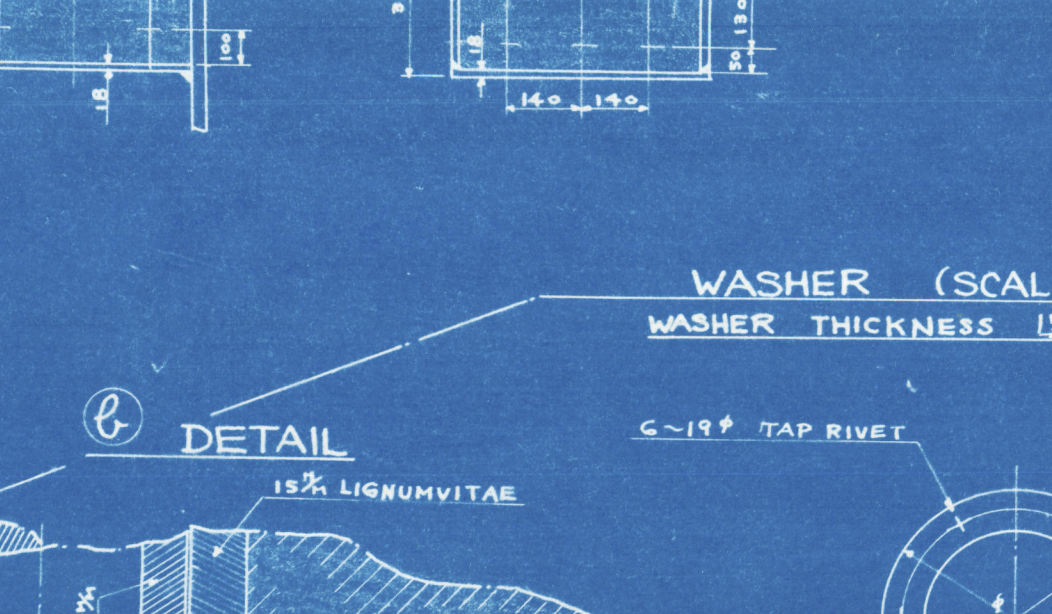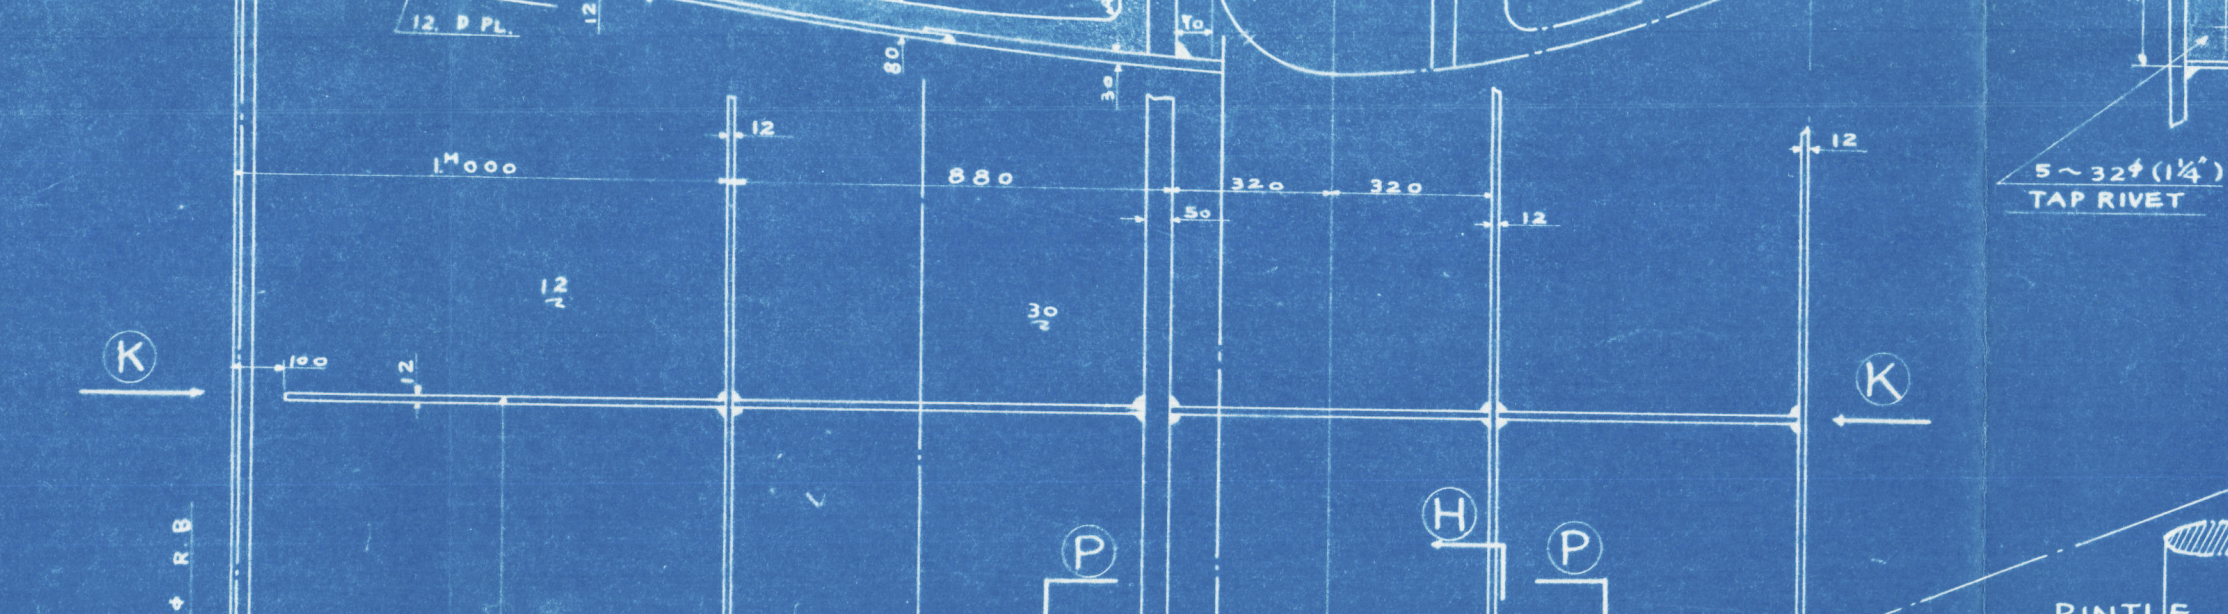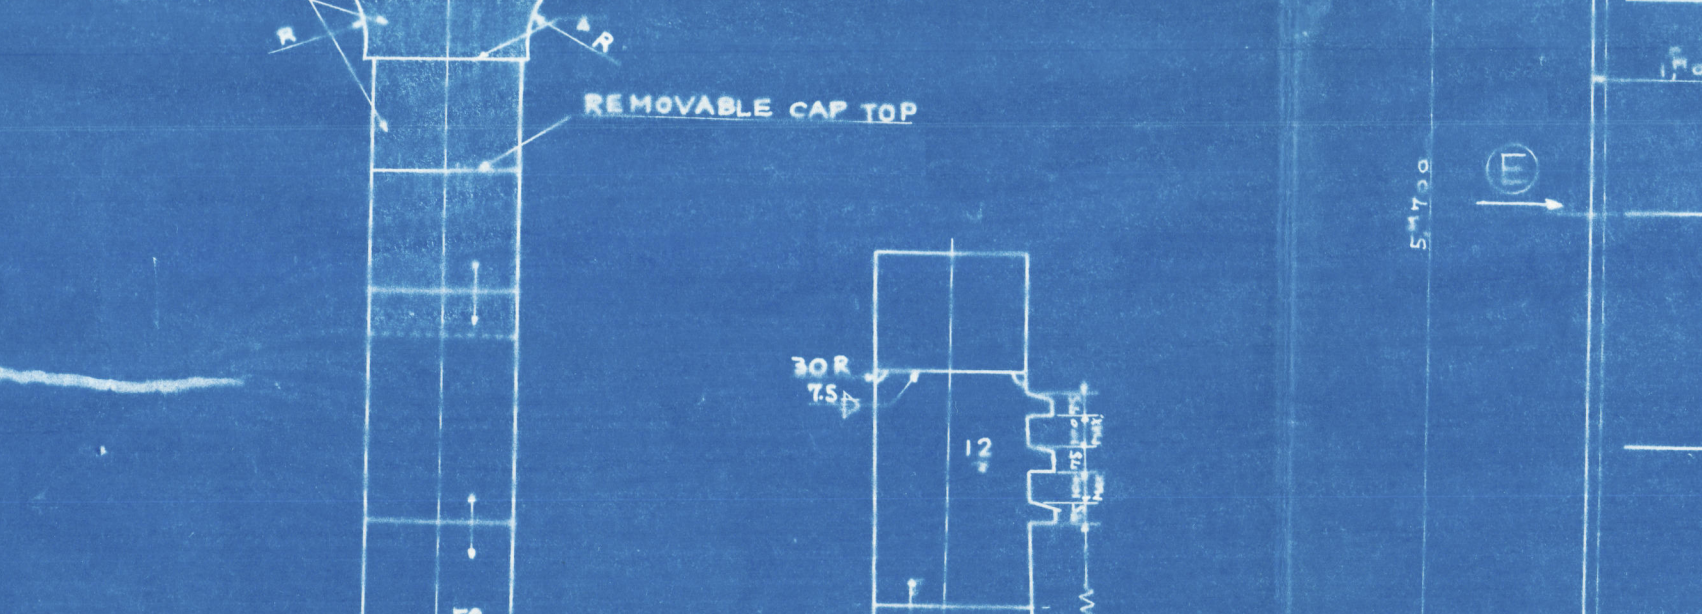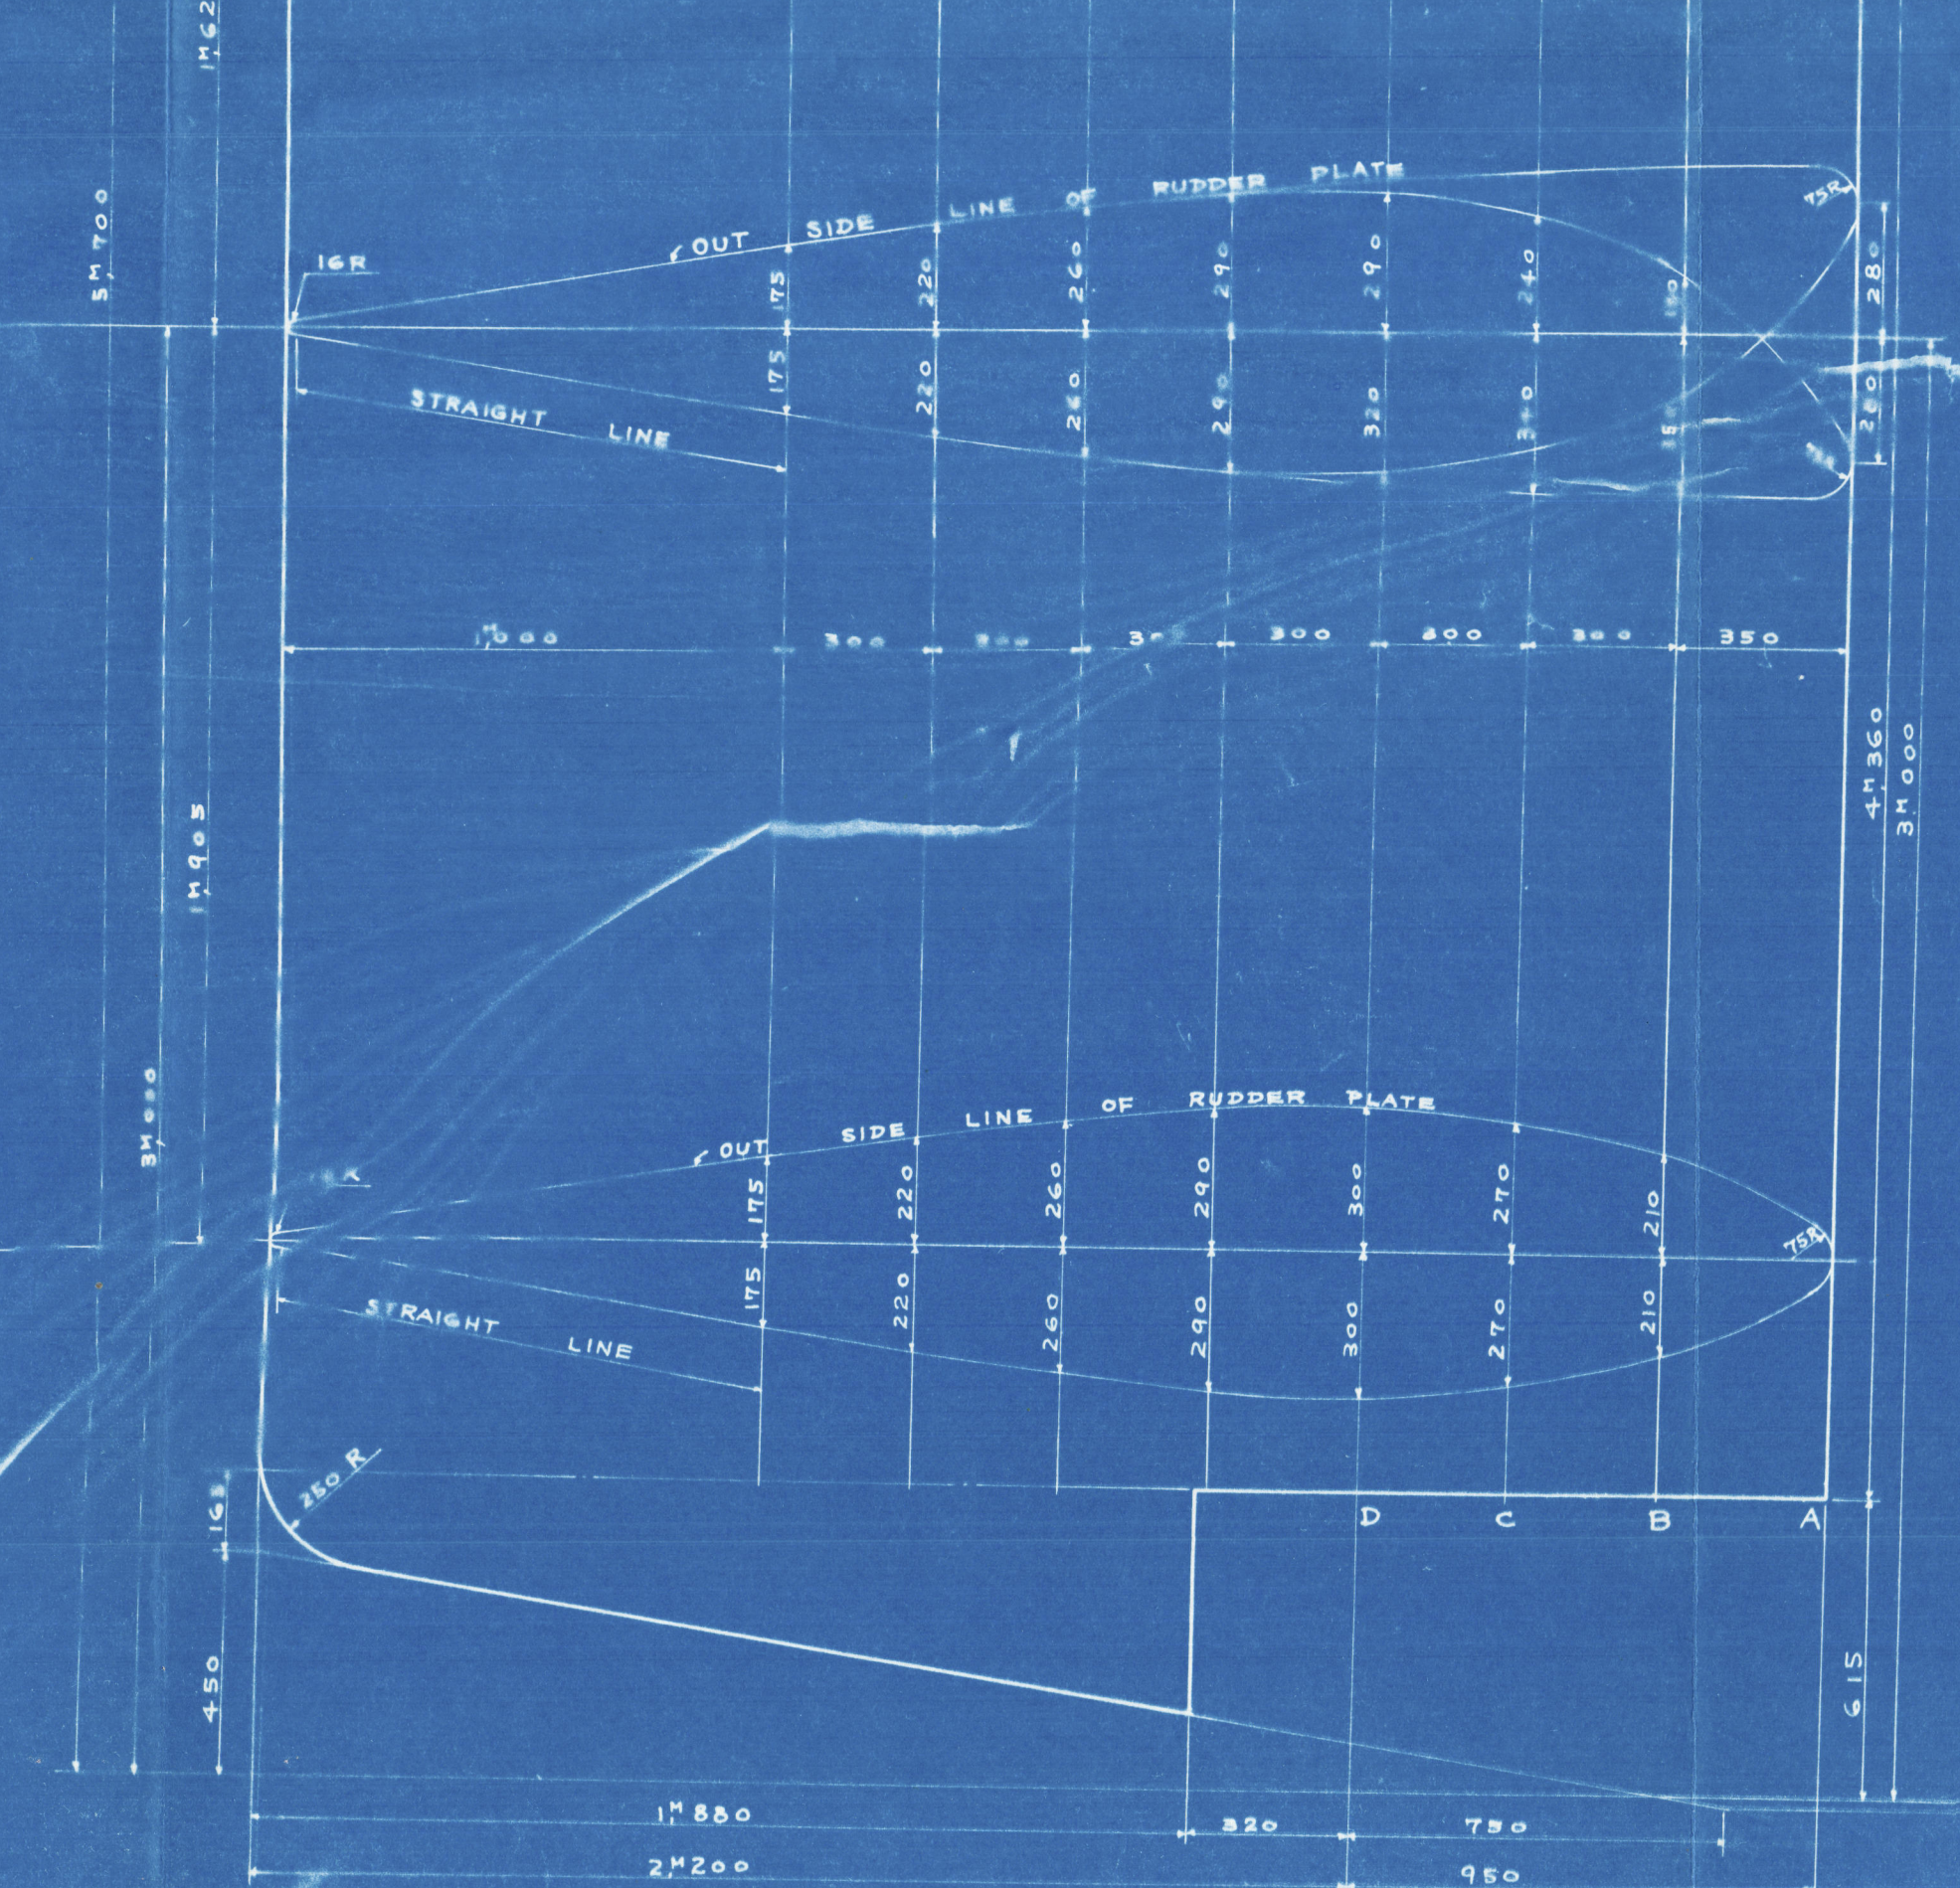

OTHER SIDE SECTION

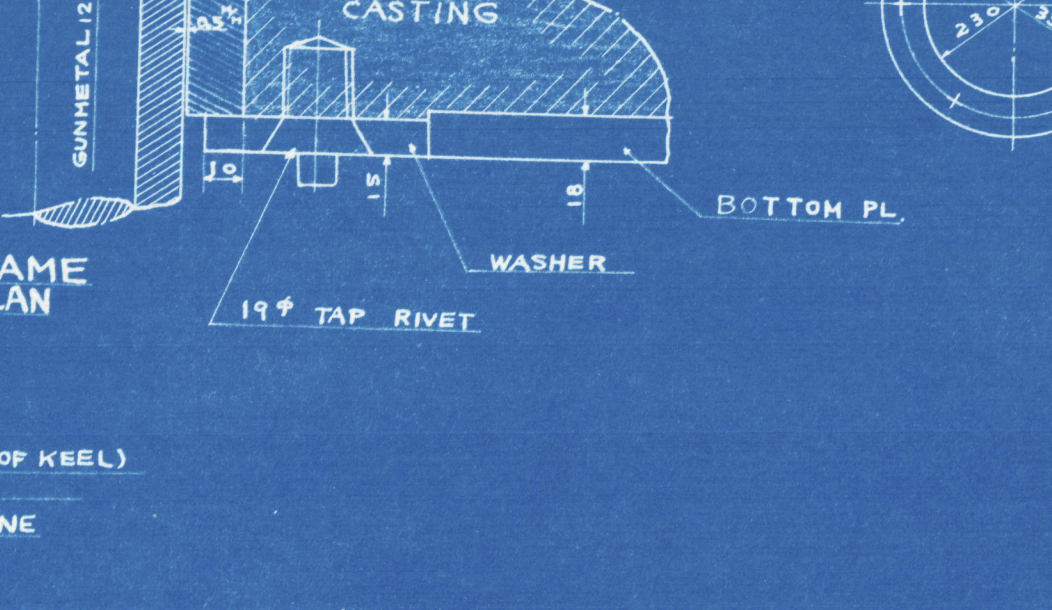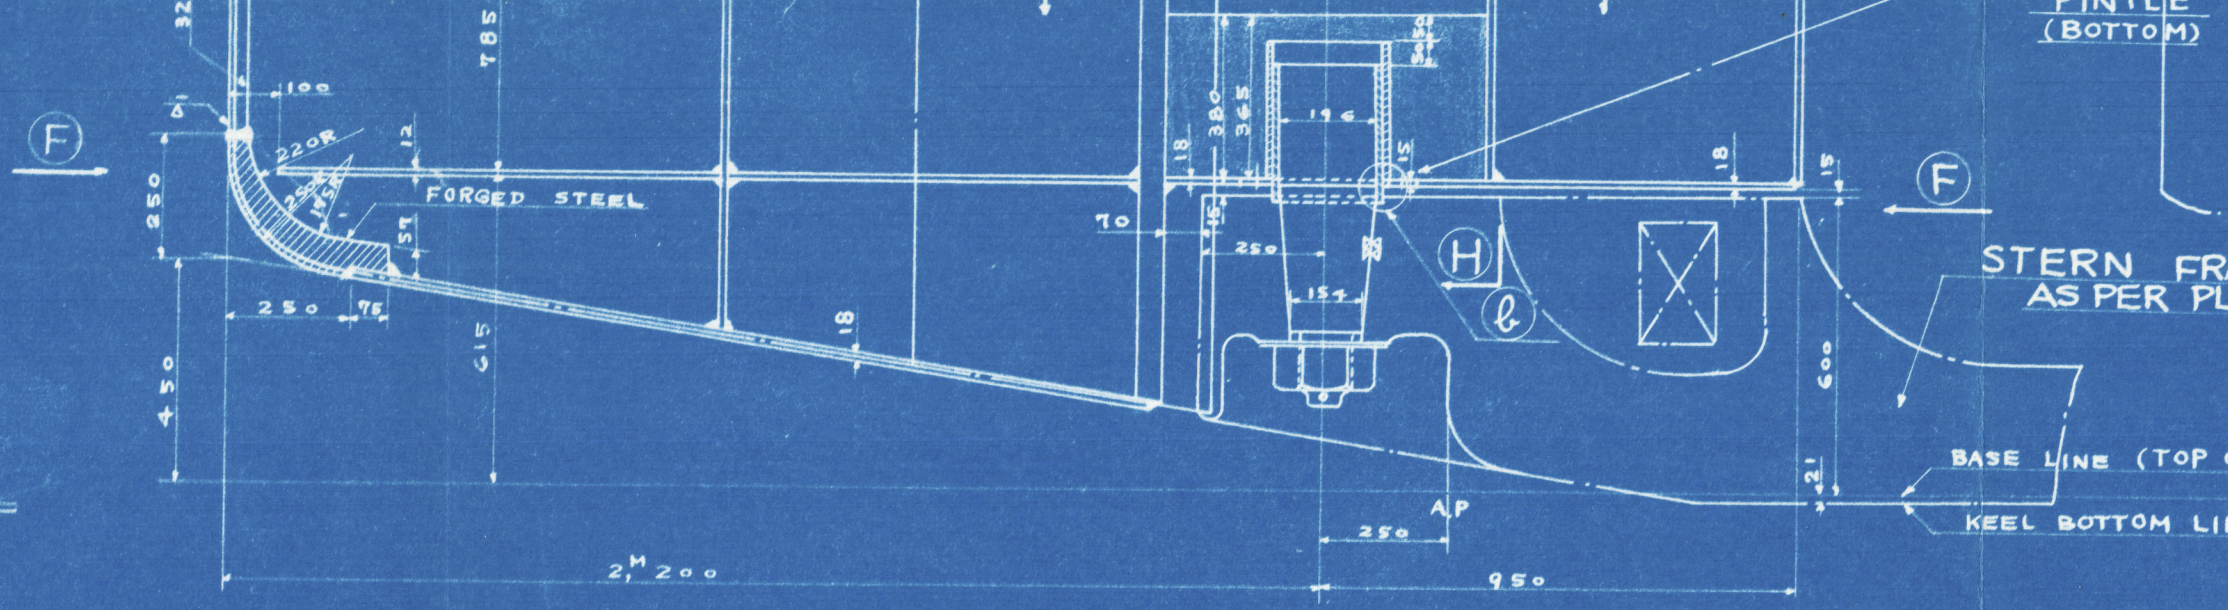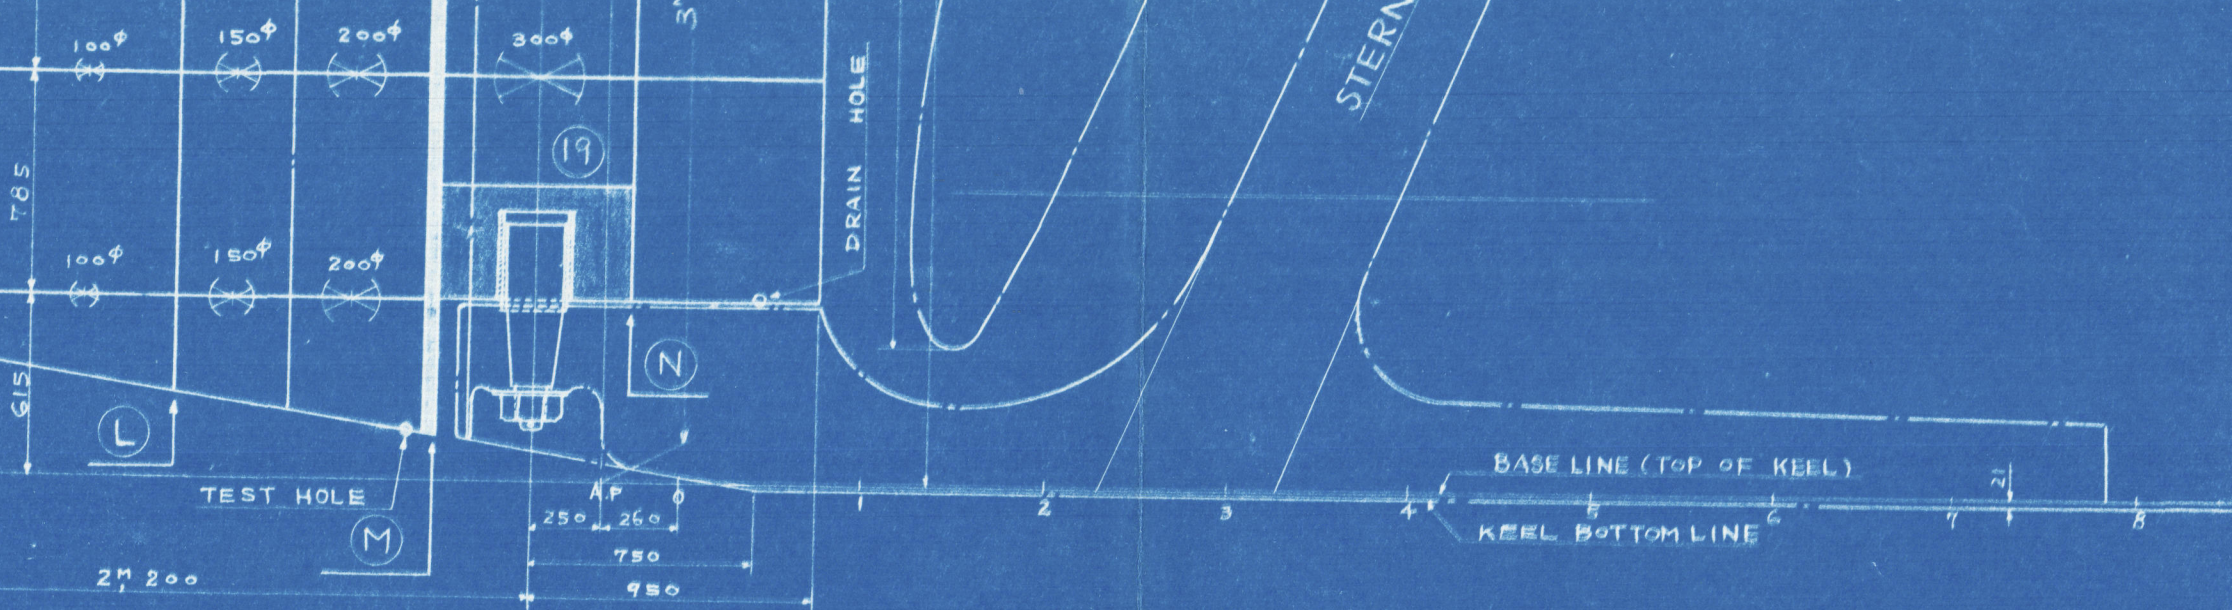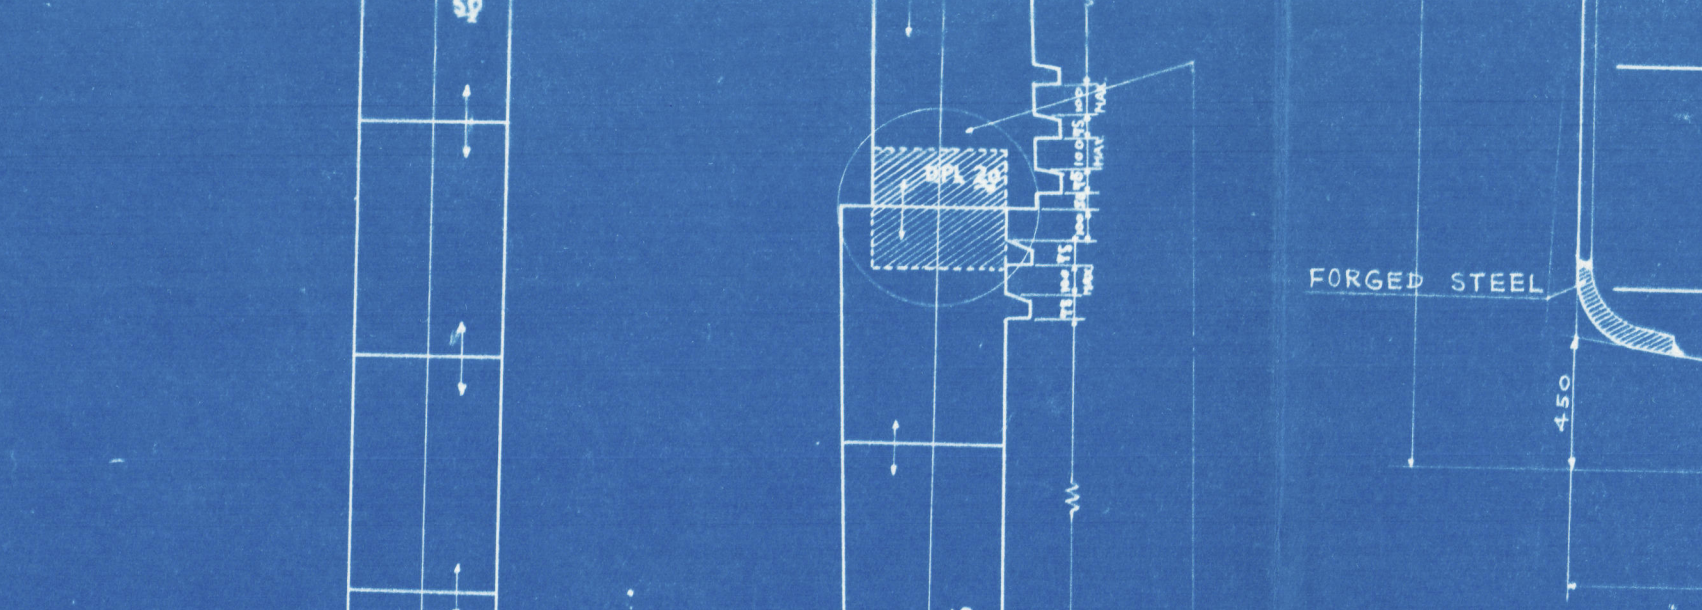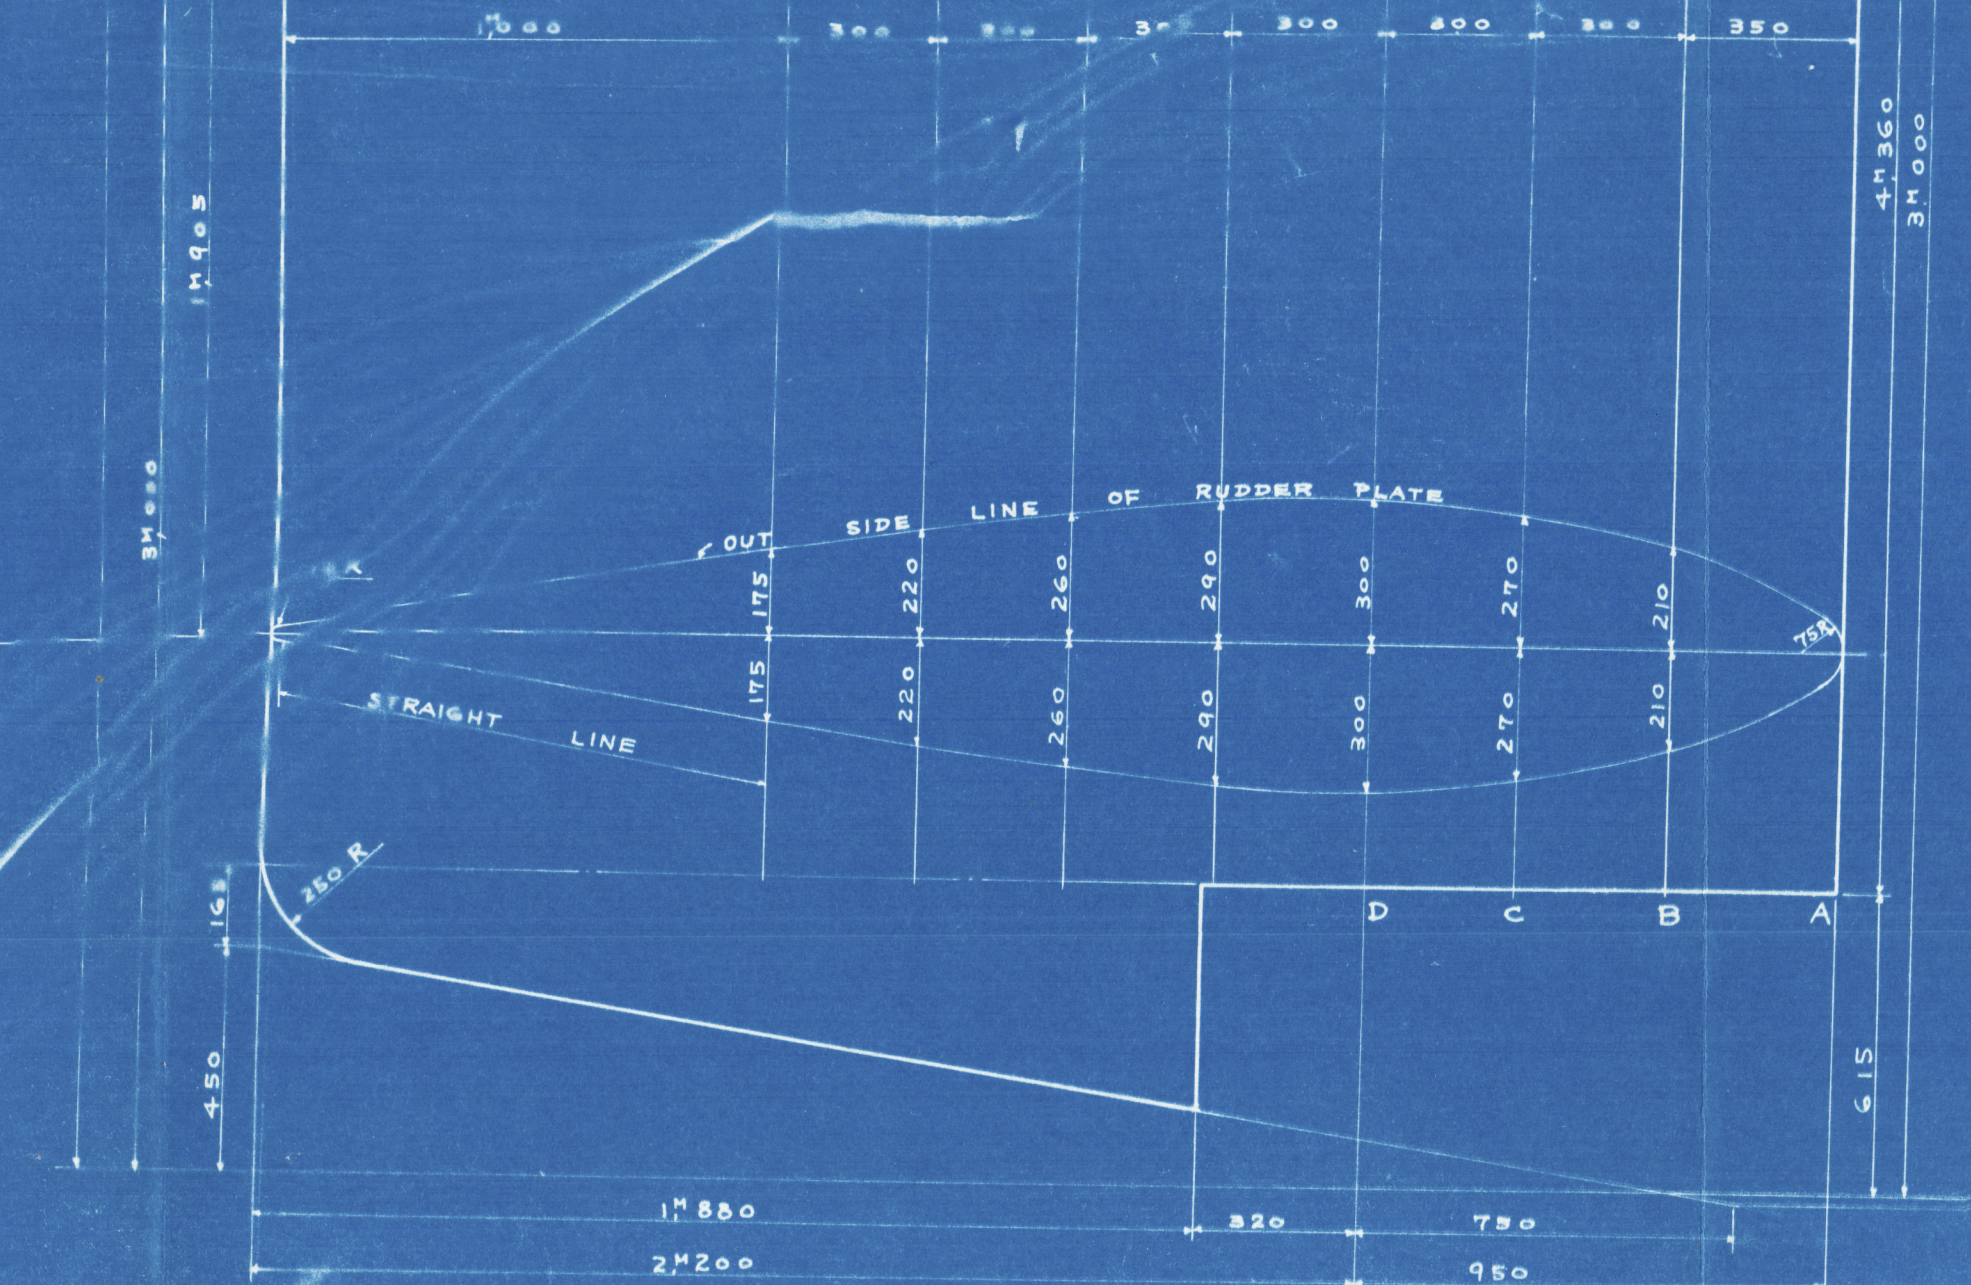


OTHER SIDE SECTION

1. 1/2 (1/2)	2. 1/2 (1/2)

COPY FOR
LONDON OFFICE

RECORDS DEPT.
LONDON

7

Hikosan Maru 
Rudder (as built)

Yka FE Rpt no. 667



© 2021

Lloyd's Register
Foundation

008773-008777-0005