


TO
LLOYD'S REGISTER OF SHIPPING


RECORDS DEPT.
LONDON

13

Kenryu Maru 

Rudder

AS BUILT.

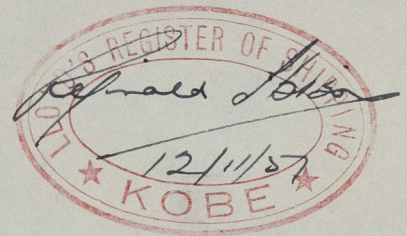

008773-008777-0051



NOV 12 1951

Lloyd's Register
Foundation