

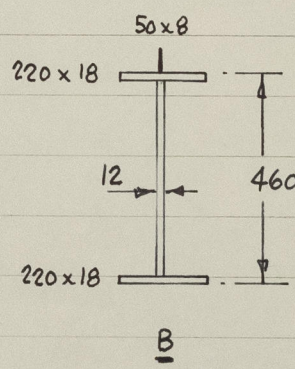
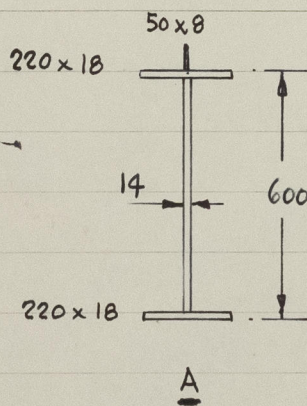
LLOYD'S REGISTER OF SHIPPING

UNITED WITH THE BRITISH CORPORATION REGISTER

ALTERATIONS TO CONDITIONS OF ASSIGNMENT OF LOADLINES

Ship's Name KENRYU MARUOfficial No. 67584Port of Registry KOBEThis ship has been under survey at Osakaon 13 - 21 July 55 195 and the following alterations to the conditions of assignment of loadlines have now been effected/found:—Alteration to No 2 Hatchway on upper deck.

No. 2 steel hatch covers have now been changed to wooden hatch covers, and hatch has been rebuilt as shown below:—

DESCRIPTION No 2 Cargo hatch. Upper deck.DIMENSIONS 21.450 x 6.400 m.COAMINGSHt. above deck 740 mm.thickness { sides 12 mm.
endsStiffeners 250 x 90 x 12 BA. horizontal.Brackets 9 mm. plate, flanged 90 mm, spaced 1.650 m.BEAMSNumber 16Spacing 1.275 m.Bearing surface 150Beams A & B fitted alternately
(8 of each)COVERSMaterial Wood.Thickness 60 mm.Fitted F & A.Bearing surface 100 mm.BATTENING ARRGT'SCleats, battens, tarpaulins, & locking bars provided in accordance with Rules.A copy of this Report has been placed on board.

5m, 3, 55. T.

The above details taken from Rpt. B and attached approved plan 29.7.55

Kobe 29.7.55
29.7.55

DPR 20 OCT 1955

008773-008777-0093

© 2021

Lloyd's Register
Foundation