

Lloyd's Register of Shipping.


Ship's Name "ISLAS MASLVINAS"

Official No. ---

Memorandum of alterations reported since ship was surveyed for assignment of Load Lines
in May, 1950.

A bulwark, 1100 mm. in height, as per sketch, fitted abaft the forecastle bulkhead.

Length of bulwark = 8991 mm.

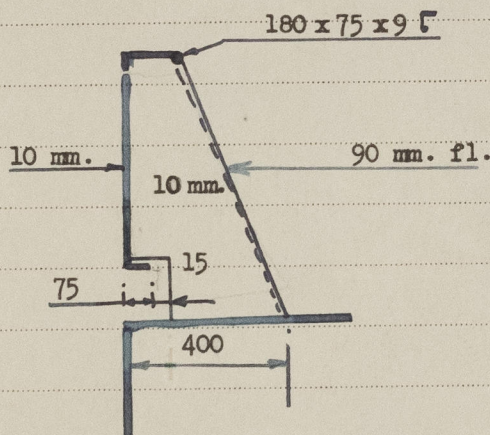

GOTHENBURG.
22. 7. 1950.

Handwritten signature

Handwritten signature

Handwritten mark