


· PROFILE & DECK PLAN ·

Scale $\frac{1}{4}$ in. = 1 ft.

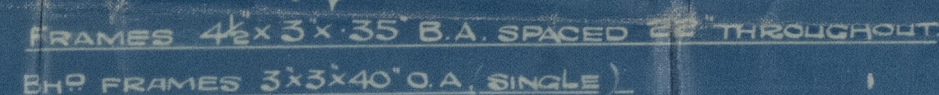

PROFILE

APPROVED
LLOYD'S REGISTER OF SHIPPING
Montgomery 24-12

24.12.93.

Can & Somerville Ltd.,

V. No. 135.

Profile & Deck Plan

of "Maurice"



© 2021

Lloyd's Register
Foundation

008778-008785-0224