

Sindlersleben u. Dingelinge 55 Obr. 340/44

Actien-Gesellschaft „Neptun“
Schiffswerft u. Maschinenfabrik
Abtheilung für Schiffbau.

J. N. 3. 18. x. 13


STERN FRAME

ACT GES NEPTUN ROSTOCK N^o 344

S.S. LENNEP

HAMBURG REPORT 14324

now named "Brant County"

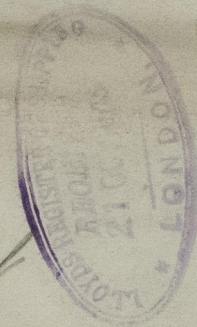

Act. Ges. Neptun 9/10 3401344

Plan of Stern Frame

Heim. Letter 20.10.19



© 2021

Lloyd's Register
Foundation

008784-008795-0002

Handwritten signature

008789-008745-0002



© 2021

Lloyd's Register
Foundation