

Act Geo. Meptim. No 340 & 344


Plan of Rudder.

Ham. letter 20.10.12

Brant County

ex

"Lennep."

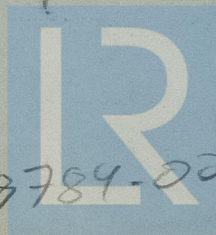

© 2021

Lloyd's Register
Foundation

008784-008795-0003


RUDDER PLAN

ACT. GES. NEPTUN ROSTOCK N^o 344

S. S. TENNER

HAMBURG, REPORT. N^o 14324

now named "Brant County"

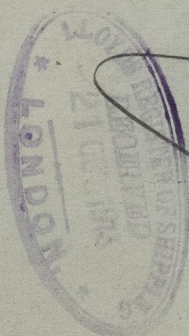

© 2021

Lloyd's Register
Foundation

008784-008745-0003