

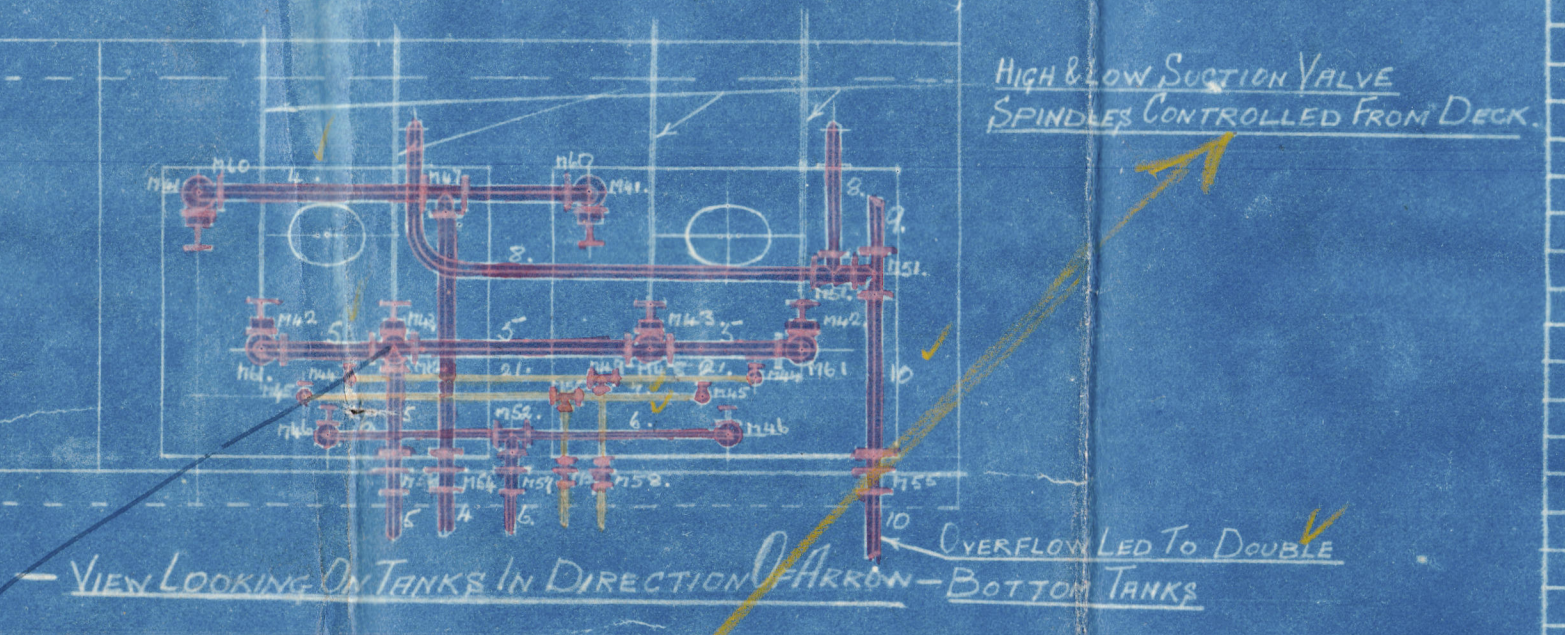


18/10/19

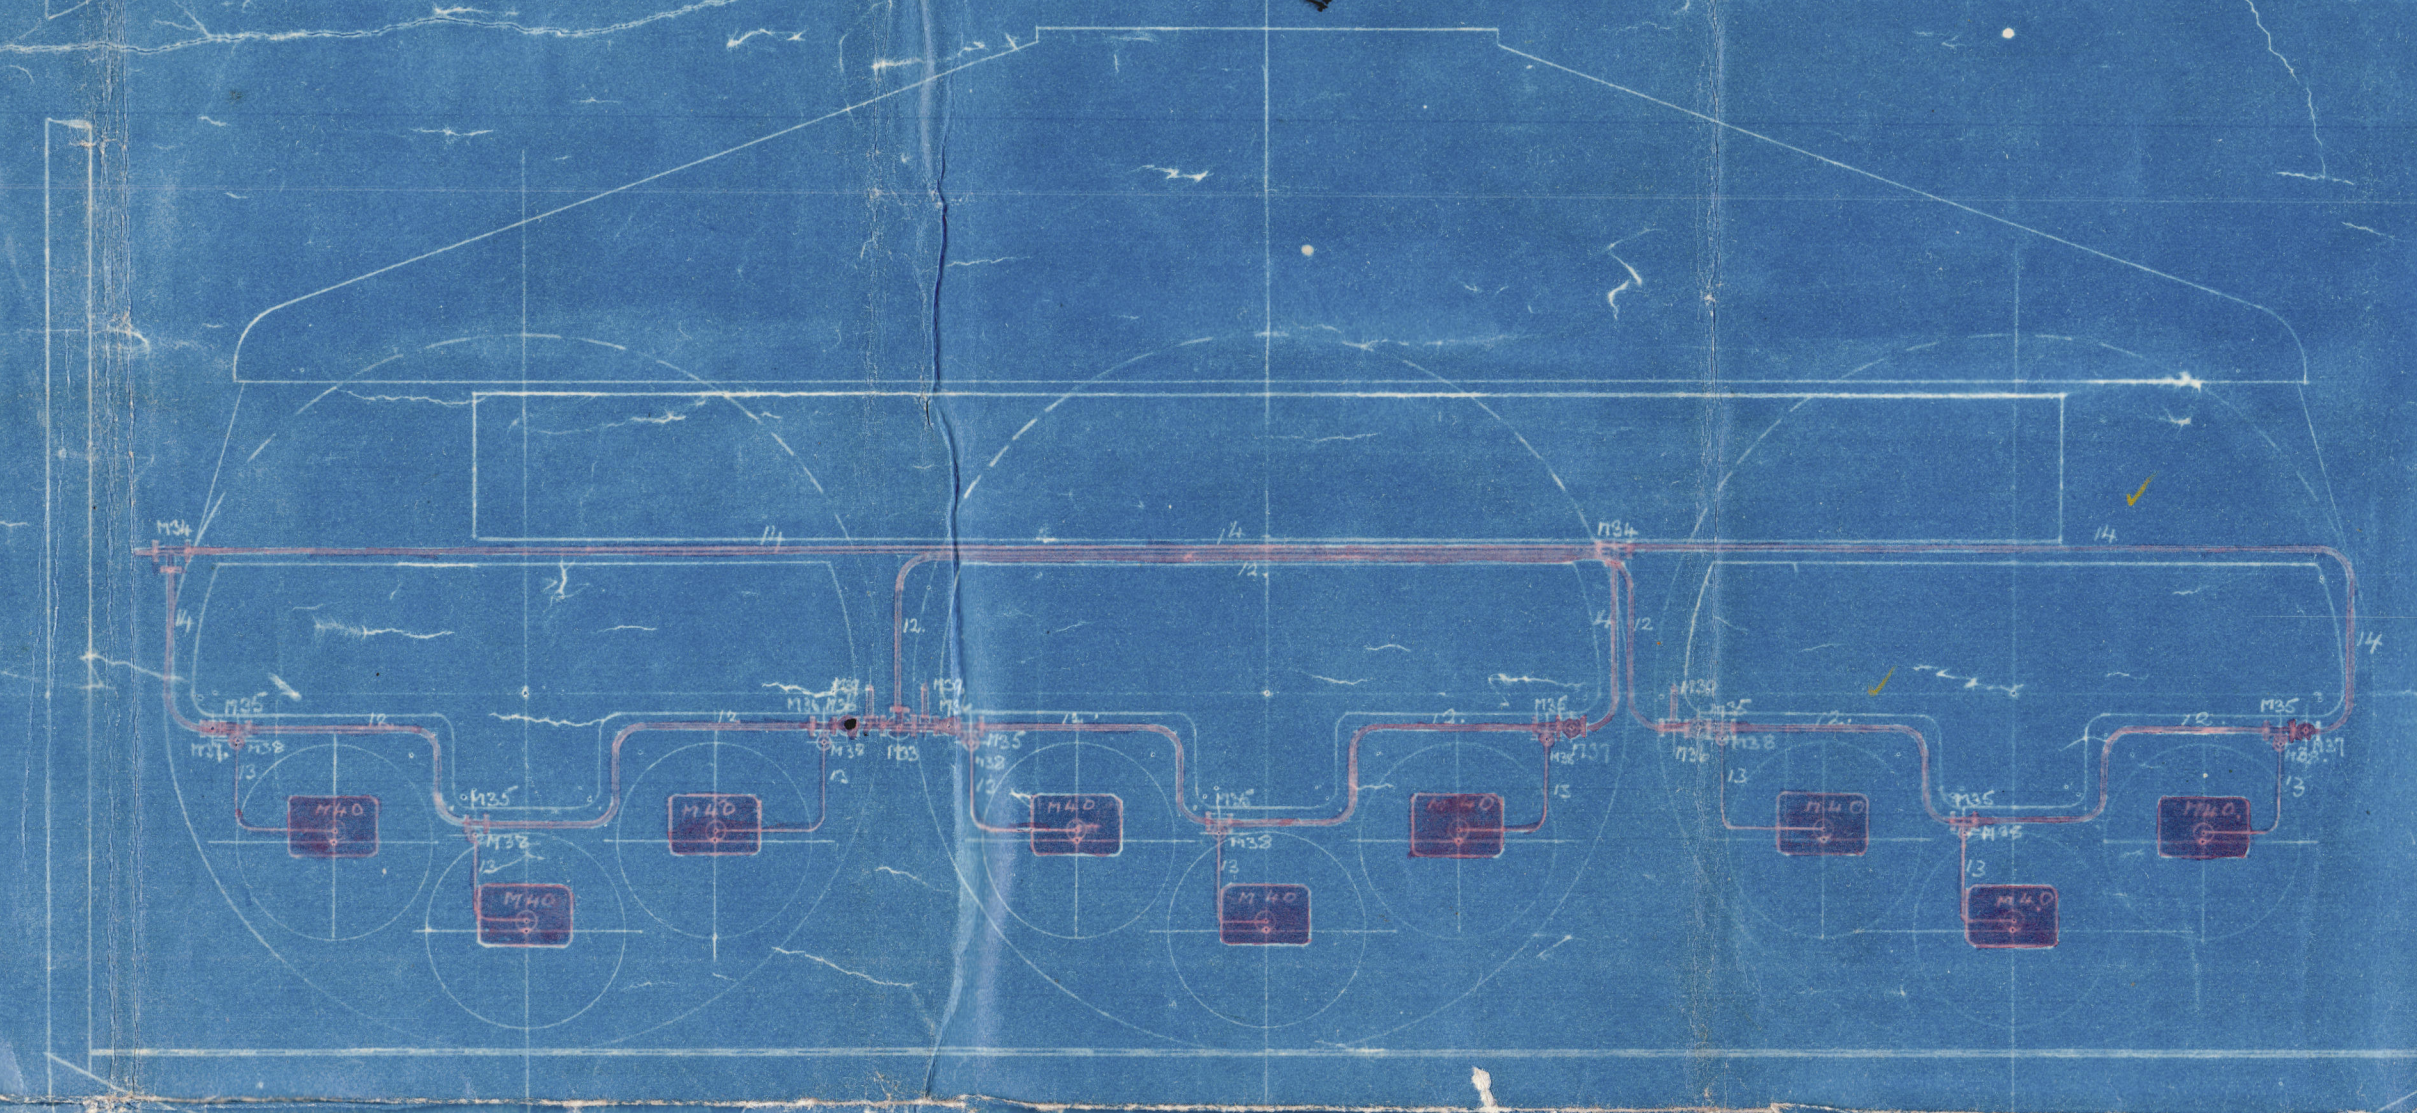

It is proposed that instead of 4 Cisterns being carried to deck that this 1st Cistern be fitted as a unit & shut off valve to control all cisterns & that only this valve be controlled from deck

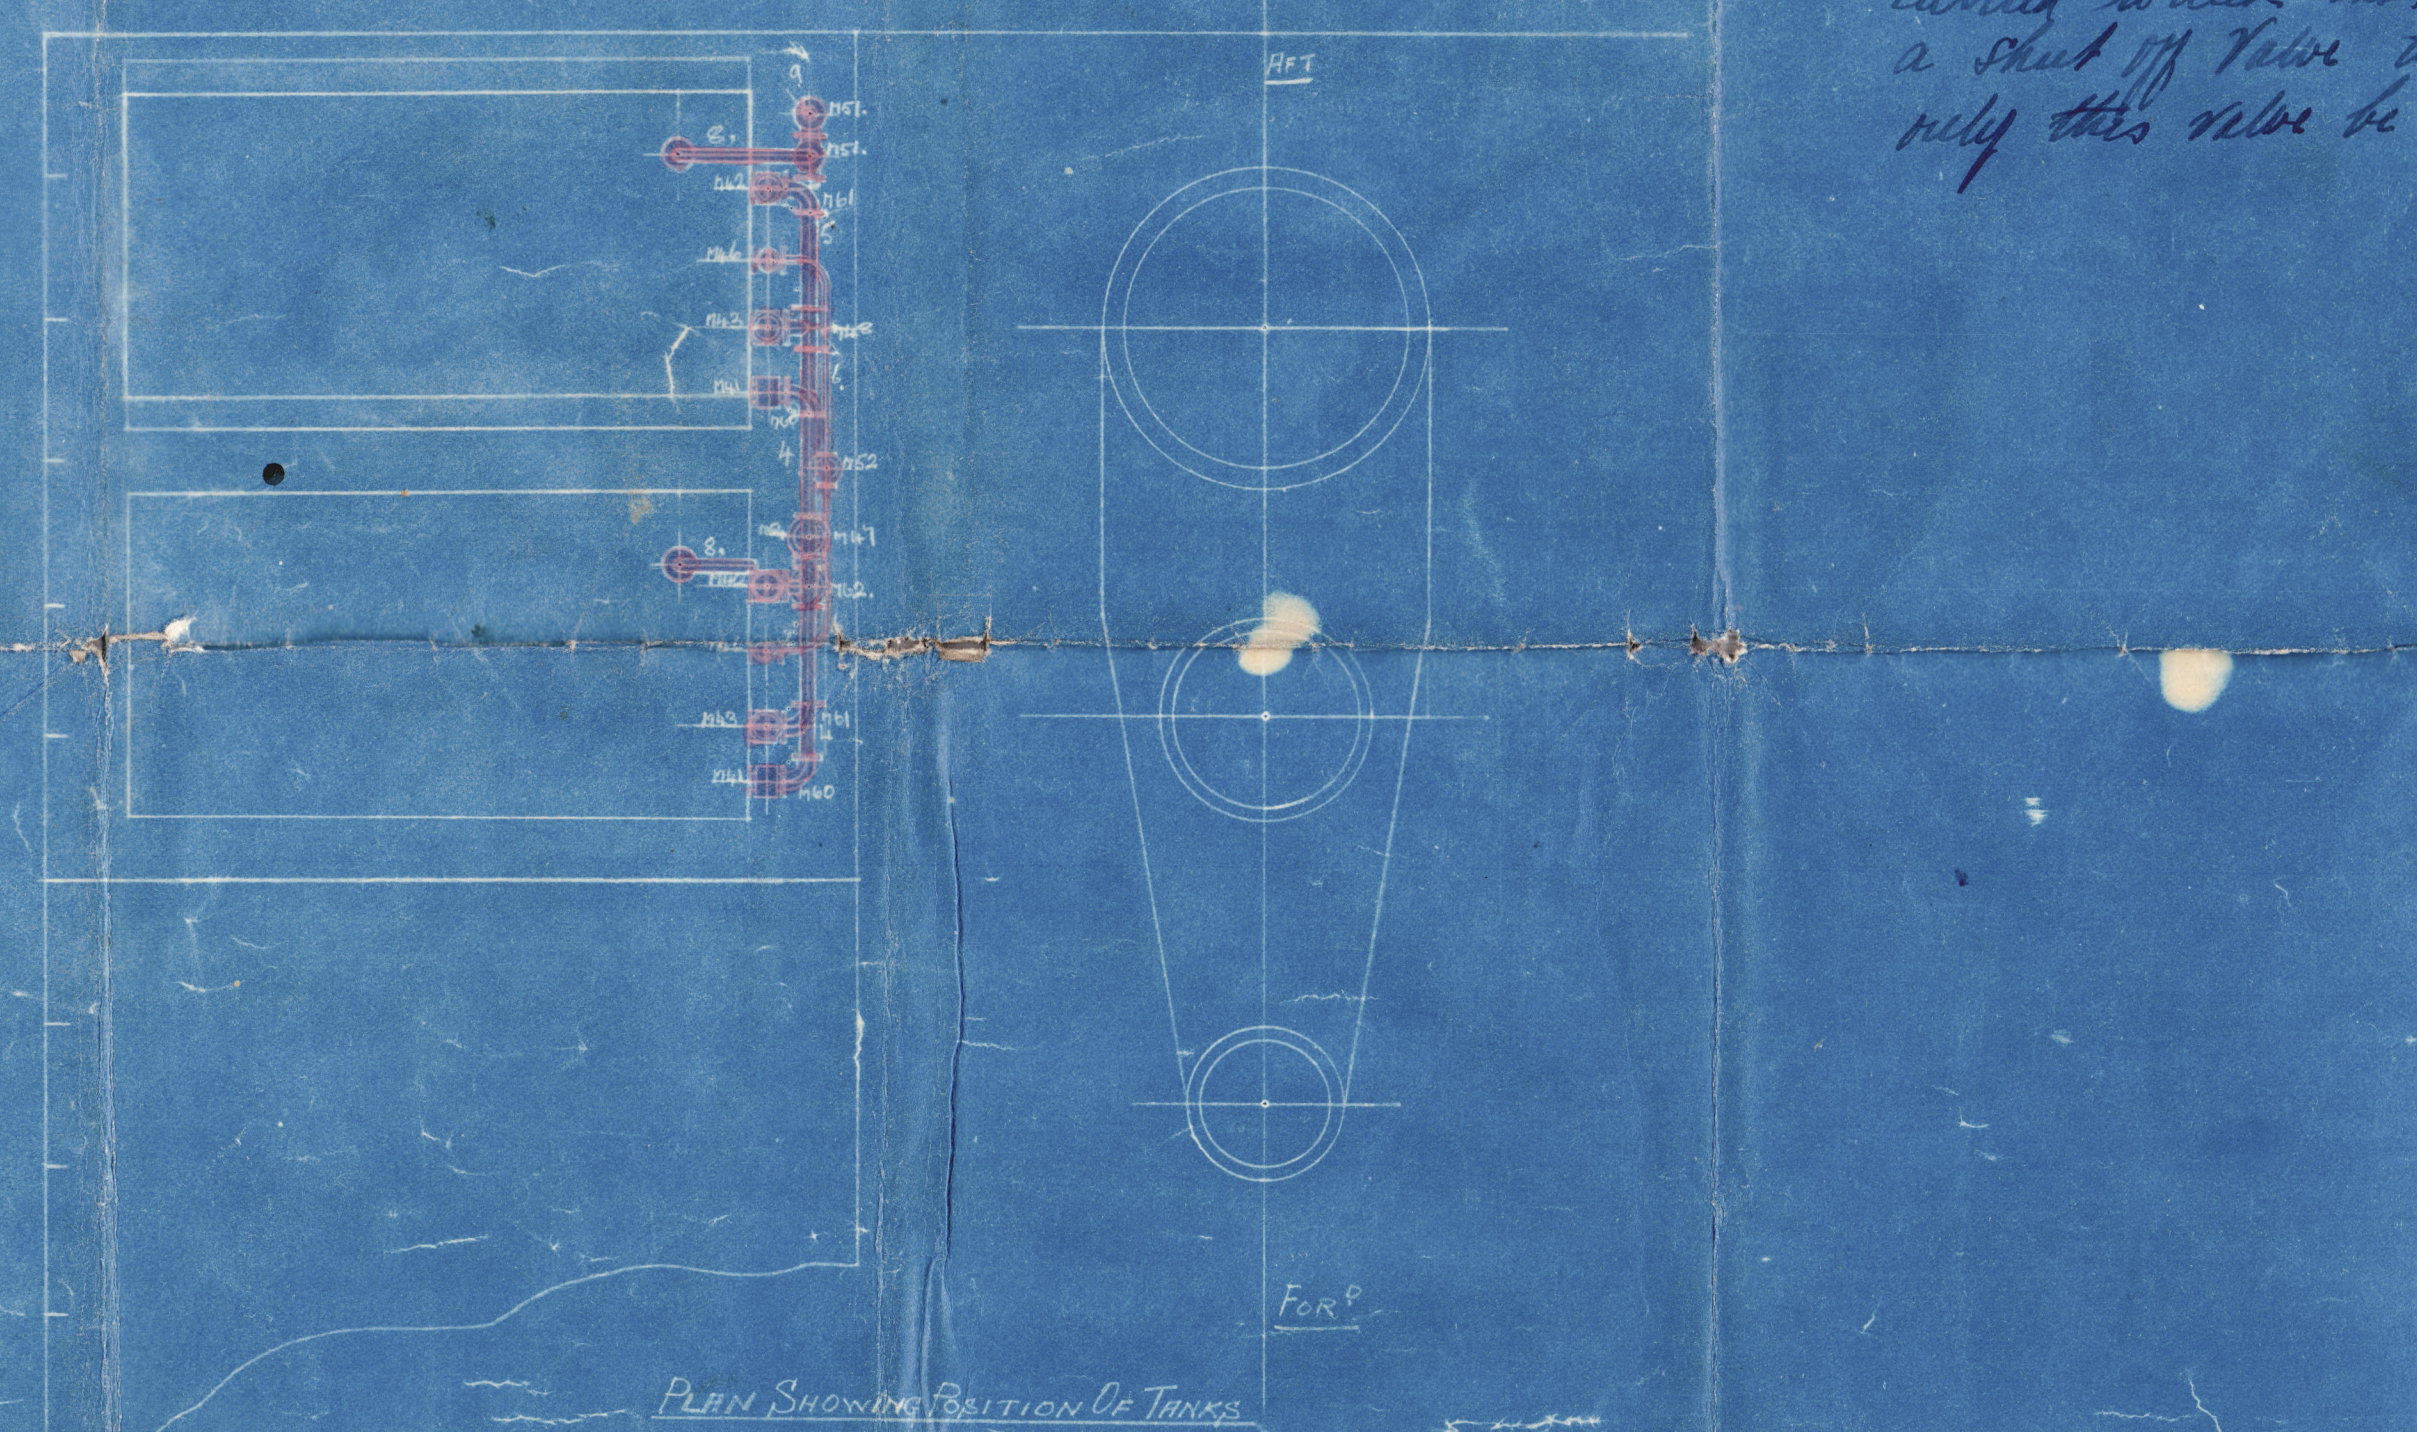

Head point of oil fuel to be above 150°F. and the remaining requirements of Section 19 of the Rules to be complied with.

17/10/19



BRIGHT & GOWAN, LTD.
SCOTT STREET, GLASGOW
DRAWING OFFICE
CONTRACT NO. 406
DATE 17/10/19

GENERAL ARRANGEMENT OF OIL BURNING MACHINERY
THE WHITE PATENT LOW PRESSURE MECHANICAL OIL BURNING SYSTEM
SCALE 1/2" = 1 FOOT

CONTRACT NO. 406

DRAWING NO. 360

SALACIA

Zuisyo Maru
Esc.

S.S. *"Salacia"*

LIVERPOOL

Report No. *80470*

WED. DEC. 10. 1919

WED. DEC. 10. 1919

008796-008803-0001



© 2021

Lloyd's Register
Foundation

008796-008803-0001