





C Council & Co

Midships Section


~~Proposed 410 ft S.S.~~

36" spacing

Ex^o 348 7/8

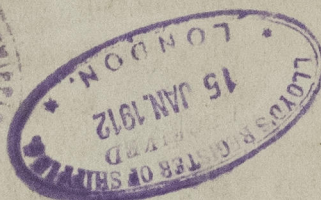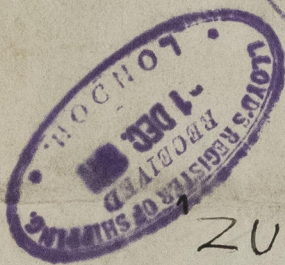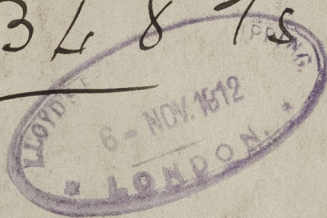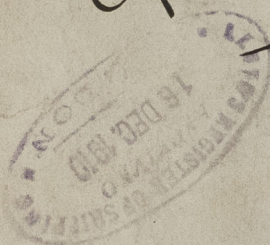

ZUIS 70 MARU

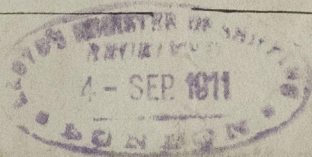

Ex

S/s "Dunachton"

GLASGOW REPORT No. 32001



© 2021

Lloyd's Register
Foundation

008796-008803-0002