


5-3-53

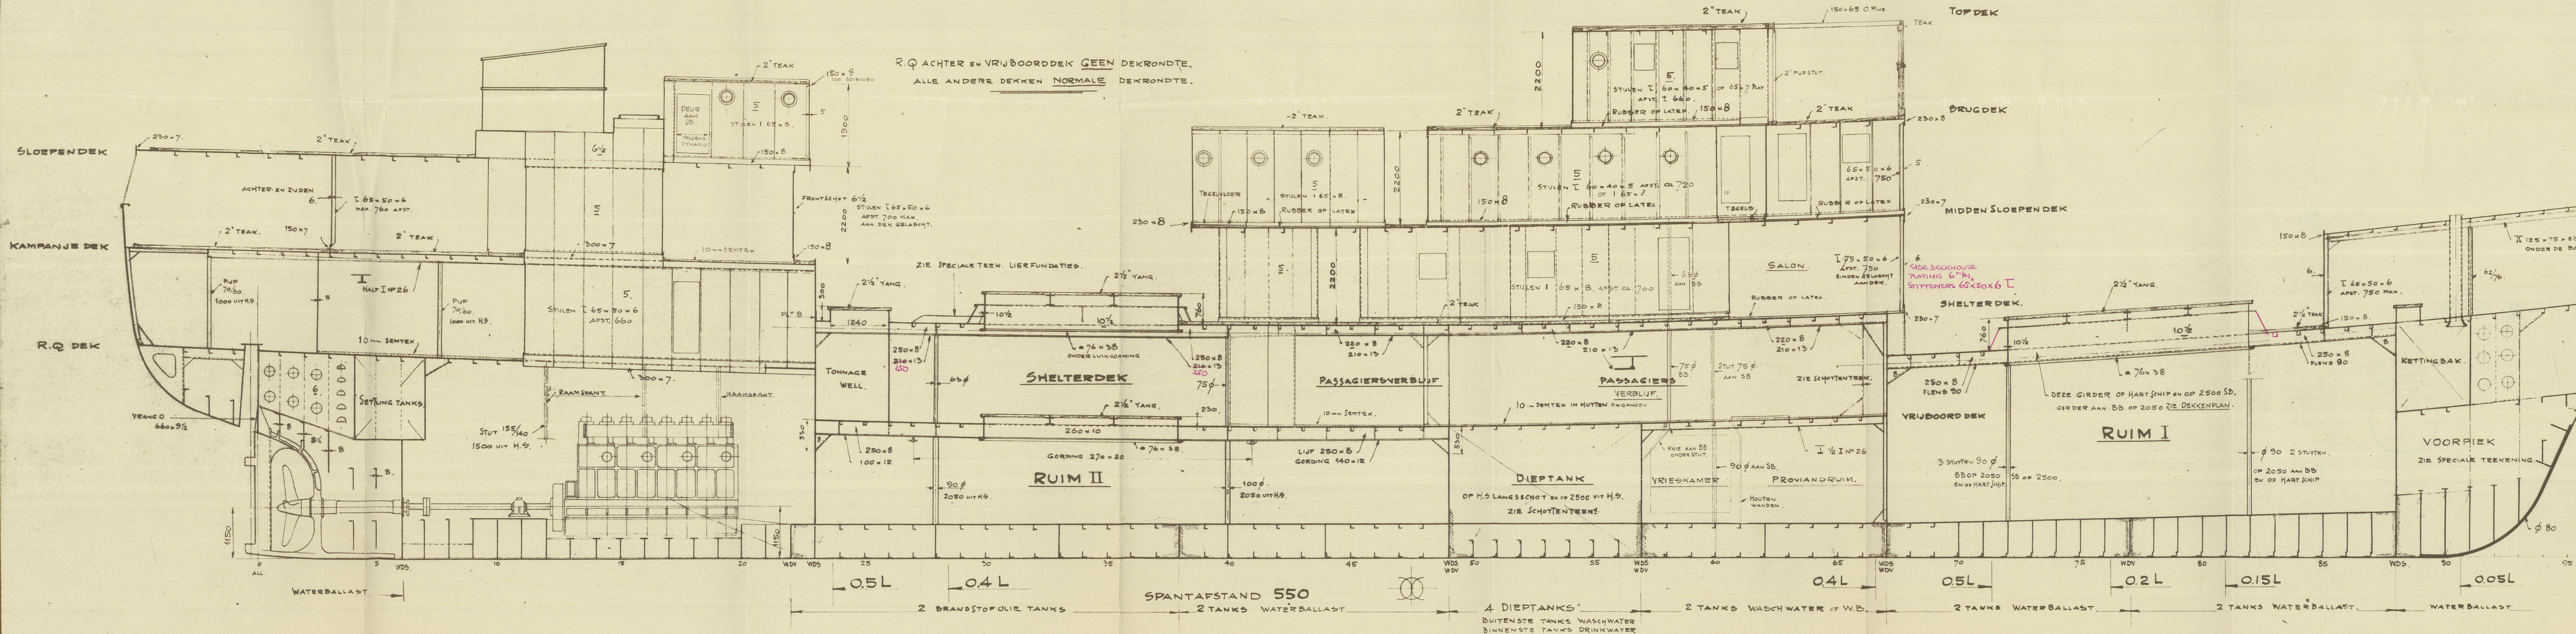

WINDLASS, WINCHES, MASTS AND
STEERING GEAR SUPPORTED TO
SURVEYORS' SATISFACTION.


R.Q. DEK

C/k.
5-3-53

BELONGS TO GRONINGEN Rpt No. *9474*
 VESSEL'S NAME. "*Bombardier*"

WIJZIGINGEN	LETER	datum	PARAAF
-------------	-------	-------	--------

N.V. E. J. SMIT & ZON'S
SCHEEPSWERVEN
WESTERBROEK (GR.) HOLLAND.

LANGSPLAN.

SCHAAL 1 : 50

H.V. FERUS. SMIT. "OEBAKENING. BOUWEN. 116
 H.V. PATFUE "VAARTUIG." " 217
 72703
 H.V. "INTAN" Lloyd's Regi-
 blad

008804 . 008811 . 008831

Profile

★INTAN

RECORDS DEPT.,
LONDON.

2

008804 - 008811 - 0036

008811 - 0036

12-1-53

© 2021

Lloyd's Register
Foundation